


COALITION FOR THE UPPER SOUTH PLATTE
11-MILE CANYON DIVERSION DAM REMOVAL
LAKE GEORGE, COLORADO
70% DRAWINGS
OCTOBER 2020

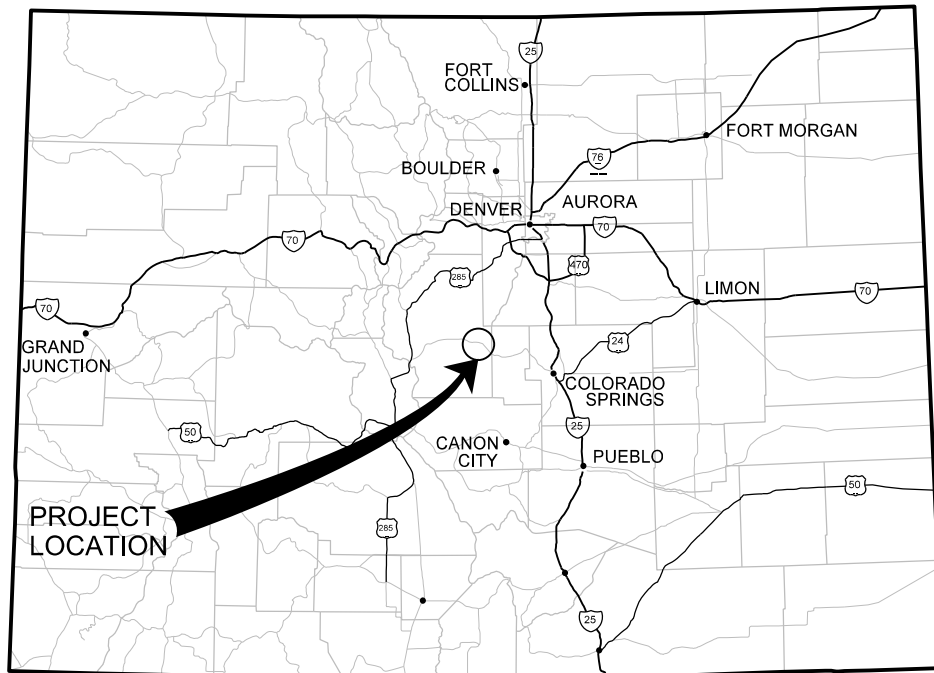


COLORADO LOCATION MAP



PROJECT PARTNERS



Colorado Springs Utilities
It's how we're all connected

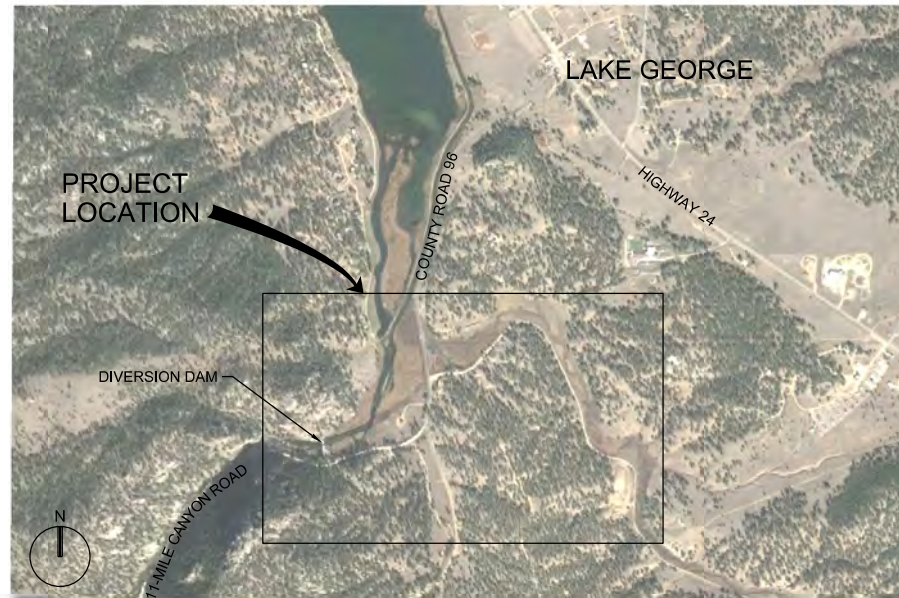

VICINITY MAP

SHEET INDEX		
SHEET NO	DWG NO	DESCRIPTION
1	G-0001	COVER SHEET AND SHEET INDEX
2	G-0002	ABBREVIATIONS, GENERAL NOTES, AND LEGEND
3	G-0003	PHASING NOTES AND CONTROL TABLES
4	C-2001	SITE OVERVIEW
5	C-2002	KEY MAP
6	C-2003	WATER, EROSION CONTROL, AND SITE ACCESS PHASING PLAN
7	C-2004	WATER, EROSION CONTROL, AND SITE ACCESS PHASING PLAN
8	C-2101	DAM REMOVAL AND DEMOLITION PLAN PHASE 1
9	C-2102	DAM REMOVAL AND DEMOLITION PLAN PHASE 2
10	C-2103	DAM REMOVAL AND DEMOLITION PLAN PHASE 3
11	C-2201	FILL AREAS AND EROSION CONTROL
12	C-2301	PLAN AND PROFILE
13	C-2302	PLAN AND PROFILE
14	C-5001	CIVIL AND EROSION CONTROL DETAILS
ATTACHMENT 1		FIN-UP HABITAT CONSULTANTS
ATTACHMENT 2		RESTORATION PLANS (13 SHEETS)
		11-MILE CANYON DIVERSION DAM AS-BUILTS (7 SHEETS)
ATTACHMENT 3		FISHING PIER AS-BUILTS (10 SHEETS)

US FOREST SERVICE SIGNATURE BLOCK

CUSP SIGNATURE BLOCK

JACOBS SIGNATURE BLOCK

OTHER SIGNATURE BLOCK IF NEEDED

PRELIMINARY
NOT FOR
CONSTRUCTION

DATE	BY	DESCRIPTION	REMARKS
11/11/2018	CH2M HILL	REUSE OF DOCUMENTS:	THIS DOCUMENT, AND THE IDEAS AND DESIGNS INCORPORATED HEREIN, AS AN INSTRUMENT OF PROFESSIONAL SERVICE, IS THE PROPERTY OF CH2M HILL AND IS NOT TO BE USED, IN WHOLE OR IN PART, FOR ANY OTHER PROJECT WITHOUT THE WRITTEN AUTHORIZATION OF CH2M HILL.

© CH2M HILL 2018. ALL RIGHTS RESERVED.

JACOBS

GENERAL
COVER SHEET AND SHEET INDEX

VERIFY SCALE

IS ONE INCH ON
ORIGINAL DRAWING.

DATE	OCT 2020
------	----------

ROJ	WXXY3000
-----	----------

WG	G-0001
----	--------

HEET 1 of 14

1. SOURCE OF TOPOGRAPHY SHOWN ON THE CIVIL PLANS IS LIDAR PROVIDED BY COLORADO WATER CONSERVATION BOARD IN 2018. EXISTING CONDITIONS MAY VARY FROM THOSE SHOWN ON THESE PLANS. THE CONTRACTOR SHALL VERIFY EXISTING CONDITIONS AND ADJUST WORK PLAN ACCORDINGLY PRIOR TO BEGINNING CONSTRUCTION.
2. EXISTING TOPOGRAPHY, STRUCTURES, AND SITE FEATURES ARE SHOWN SCREENED AND/OR LIGHT-LINED. NEW FINISH GRADE, STRUCTURES, AND SITE FEATURES ARE SHOWN HEAVY-LINED UNLESS INDICATED OTHERWISE ON PLANS.
3. STAGING AREA SHALL BE FOR CONTRACTOR'S EMPLOYEE PARKING, CONTRACTOR'S TRAILERS, PARKING FOR PROJECT PARTNERS, AND ON-SITE STORAGE OF MATERIALS. PROVIDE TEMPORARY FENCING AS NECESSARY TO MAINTAIN SECURITY AT ALL TIMES.
4. ELEVATIONS GIVEN ARE TO FINISH GRADE UNLESS OTHERWISE SHOWN.
5. SLOPE UNIFORMLY BETWEEN CONTOURS AND SPOT ELEVATIONS SHOWN.
6. CONTRACTOR SHALL BE RESPONSIBLE FOR IMPLEMENTING AND MAINTAINING EROSION CONTROL DEVICES DURING CONSTRUCTION.
7. SEDIMENT/DEBRIS EXCAVATED FROM WITHIN THE WORK AREA SHALL BE TRANSPORTED IN WATER TIGHT TRUCKS .
8. MEANS, METHODS, AND DESIGN FOR COFFERDAMS AND OTHER APPROACHES TO CONTROL WATER ARE CONTRACTOR'S RESPONSIBILITY, SEE SUBMITTALS FOR DETAILS, LOCATION, AND SPECIFICATIONS. CONTRACTOR SHALL PROVIDE ALL MATERIALS AND METHODS AT THE CONTRACTOR'S DISCRETION. ADDITIONAL, OR ALTERNATIVE COFFERDAMS OR WATER CONTROL DEVICES MAY BE CONSTRUCTED WHERE NEEDED, NOT SHOWN. WHAT IS SHOWN IS CONCEPTUAL AND HAS NOT BEEN DIMENSIONED. CONTRACTOR MAY CONSIDER ALTERNATIVES TO COFFERDAMS, SUCH AS TEMPORARY FILL, BUT CONTRACTOR IS SOLELY RESPONSIBLE TO ENSURE SUCH ALTERNATIVES COMPLY WITH ALL REQUIRED PERMITS AND REGULATIONS INCLUDING THOSE PERTAINING TO TEMPORARY FILL AND TURBIDITY.
9. EXCEPT WHEN OTHERWISE SPECIFIED, DEMOLITION PHASING/SEQUENCING IS AT THE CONTRACTOR'S DISCRETION. FOR EXAMPLE, IT MAY BE POSSIBLE TO ACCESS AND ACCOMPLISH SOME OF THE PHASE II DEMOLITION FROM WITHIN THE LIMITS OF PHASE I PLATFORMS.
10. ALL TREES SHALL BE PROTECTED UNLESS SPECIFICALLY IDENTIFIED TO BE REMOVED. AT A MINIMUM, TREE PROTECTION FENCING SHALL BE INSTALLED AS SHOWN. DAMAGED TREES SHALL BE REPLACED AT THE CONTRACTOR'S EXPENSE.

ADDL	ADDITIONAL
ADJ	ADJACENT
AGGR	AGGREGATE
APVD	APPROVED
AVG	AVERAGE
@	AT
BMP(S)	BEST MANAGEMENT PRACTICE(S)
CDPHE	COLORADO DEPARTMENT OF PUBLIC HEALTH AND ENVIRONMENT
CFS	CUBIC FEET PER SECOND
CL	CENTERLINE
CMP	CORRUGATED METAL PIPE
CONC	CONCRETE
CONT	CONTINUED, CONTINOUS, CONTINUATION
COORD	COORDINATE
CS	CROSS SECTION
CPW	COLORADO PARKS AND WILDLIFE
CTR	CENTER
CF, CU FT	CUBIC FOOT
CY, CU YD	CUBIC YARD
DIA	DIAMETER
DT	DETAIL
DWG	DRAWING
EA	EACH
EG	EXAMPLE
EL	ELEVATION, EASEMENT LINE
ESC	EROSION AND SEDIMENT CONTROL
EXST, EXIST	EXISTING
FIG	FIGURE
FG	FINISH GRADE
FL	FLOW LINE
FT	FOOT OR FEET
FHWA	FEDERAL HIGHWAY ADMINISTRATION
FPS	FEET PER SECOND
G, GND	GROUND
GESC	GRADING, EROSION, AND SEDIMENT CONTROL
GPS	GLOBAL POSITIONING SYSTEM
HORIZ	HORIZONTAL
INV EL	INVERT ELEVATION
IN	INCH
INV, INVT	INVERT
IP	INLET PROTECTION
L	LENGTH
LB	POUND
LF	LINEAR FEET
MAX	MAXIMUM
MH	MANHOLE
MIN	MINIMUM
MISC	MISCELLANEOUS
MUTCD	MANUAL ON UNIFORM TRAFFIC CONTROL DEVICES FOR STREETS AND HIGHWAYS

PLACEHOLDER FOR
SEED MIX TABLES

EXISTING	THIS CONTRACT	
		CENTER LINE, BUILDING, ROAD, ETC.
		CHANNEL STATIONING AND CENTERLINE
		CONTOUR LINE
		CULVERT
		DEMOLITION
		DRAINAGE WAY OR DITCH
		EMBANKMENT AND SLOPE
		FENCE LINE
		FENCE- POST AND CABLE
		COFFERDAM
		WATER CONTROL FLOW PATH
		SEDIMENT CONTROL LOG
		LIMITS OF GRADING
		OVERHEAD POWERLINE
		EASEMENT LINE
		PROPERTY LINE
		LIMITS OF CONSTRUCTION
		TEMPORARY CONSTRUCTION EASEMENT
		BENCH MARK
		BOULDERS
		BRUSH/TREE LINE
		CATCH BASIN OR INLET
		ELECTRIC OVERHEAD POWER POLE
		ELECTRIC TRANSFORMER
		FENCE POST OR GUARD POST
		MANHOLE
		STRUCTURE, BUILDING OR FACILITY
		SPOT ELEVATION
		SURVEY CONTROL POINT OR POINT OF INTERSECTION
		UTILITY POLE
		TREES/ BUSHES
		WATER
		ACCESS ROAD
		EXISTING WETLANDS
		TOP SOIL
		SOIL RIPRAP
		RIPARIAN SEED MIX AREA
		SALVAGED WETLAND MATERIAL
		STABILIZED STAGING AREA

The diagram illustrates the standard symbols and callouts for architectural drawings, organized into several sections:

- Section and Detail Callouts:**
 - Section:** A circle containing the letter 'A' is shown with a line pointing to it from the text "SECTION (LETTER) OR DETAIL (NUMERAL) DESIGNATION". Another circle containing the numeral '1' is shown with a line pointing to it from the text "ON DRAWING WHERE SECTION OR DETAIL IS TAKEN:". Below these, a circle containing the letter 'B' is shown with a line pointing to it from the text "DRAWING NUMBER (REPLACED WITH A LINE IF TAKEN AND SHOWN ON SAME SHEET)". To the right of the 'B' circle is a box labeled "DRAWING NUMBER WHERE SHOWN".
 - Detail:** A circle containing the numeral '2' is shown with a line pointing to it from the text "ON DRAWING WHERE SECTION IS SHOWN:". To the right of the '2' circle is a box labeled "DRAWING NUMBER(S) WHERE TAKEN".
- Title Block:**
 - A circle containing the letter 'B' is shown with a line pointing to it from the text "ON DRAWING WHERE SECTION IS SHOWN:". To the right of the 'B' circle is a box labeled "DRAWING NUMBER(S) WHERE TAKEN".
 - A circle containing the numeral '2' is shown with a line pointing to it from the text "ON DRAWING WHERE DETAIL IS SHOWN:". To the right of the '2' circle is a box labeled "DRAWING NUMBER(S) WHERE TAKEN".
- Section Callouts:**
 - A circle containing the letter 'B' is shown with a line pointing to it from the text "ON DRAWING WHERE SECTION IS SHOWN:". To the right of the 'B' circle is a box labeled "DRAWING NUMBER(S) WHERE TAKEN".
 - A circle containing the numeral '2' is shown with a line pointing to it from the text "ON DRAWING WHERE DETAIL IS SHOWN:". To the right of the '2' circle is a box labeled "DRAWING NUMBER(S) WHERE TAKEN".
- Keynotes:**
 - A circle containing the numeral '1' is shown with a line pointing to it from the text "ON DRAWING WHERE SECTION OR DETAIL IS TAKEN:". To the right of the '1' circle is a box labeled "DRAWING NUMBER WHERE SHOWN".
- North Arrow:**
 - A circle containing the letter 'N' is shown with a line pointing to it from the text "ON DRAWING WHERE SECTION OR DETAIL IS TAKEN:". To the right of the 'N' circle is a box labeled "DRAWING NUMBER WHERE SHOWN".

 
DRAWING NUMBER

PP-X


PP-X

LOWER LEFT CORNER DWG


PLOT TIME: 10:51:27 AM



VERIFY SCALE BAR IS ONE INCH ON ORIGINAL DRAWING. 0  1"	
DATE	APR 2020
PROJ	WXXY3000
DWG	C-2001
SHEET	4 of 14

 


VERIFICATION SCALE	
BAR IS ONE INCH ON ORIGINAL DRAWING.	
0	1"
DATE	OCT 2020
PROJ	WXXY3000
DWG	C-2004
SHEET	7 of 14

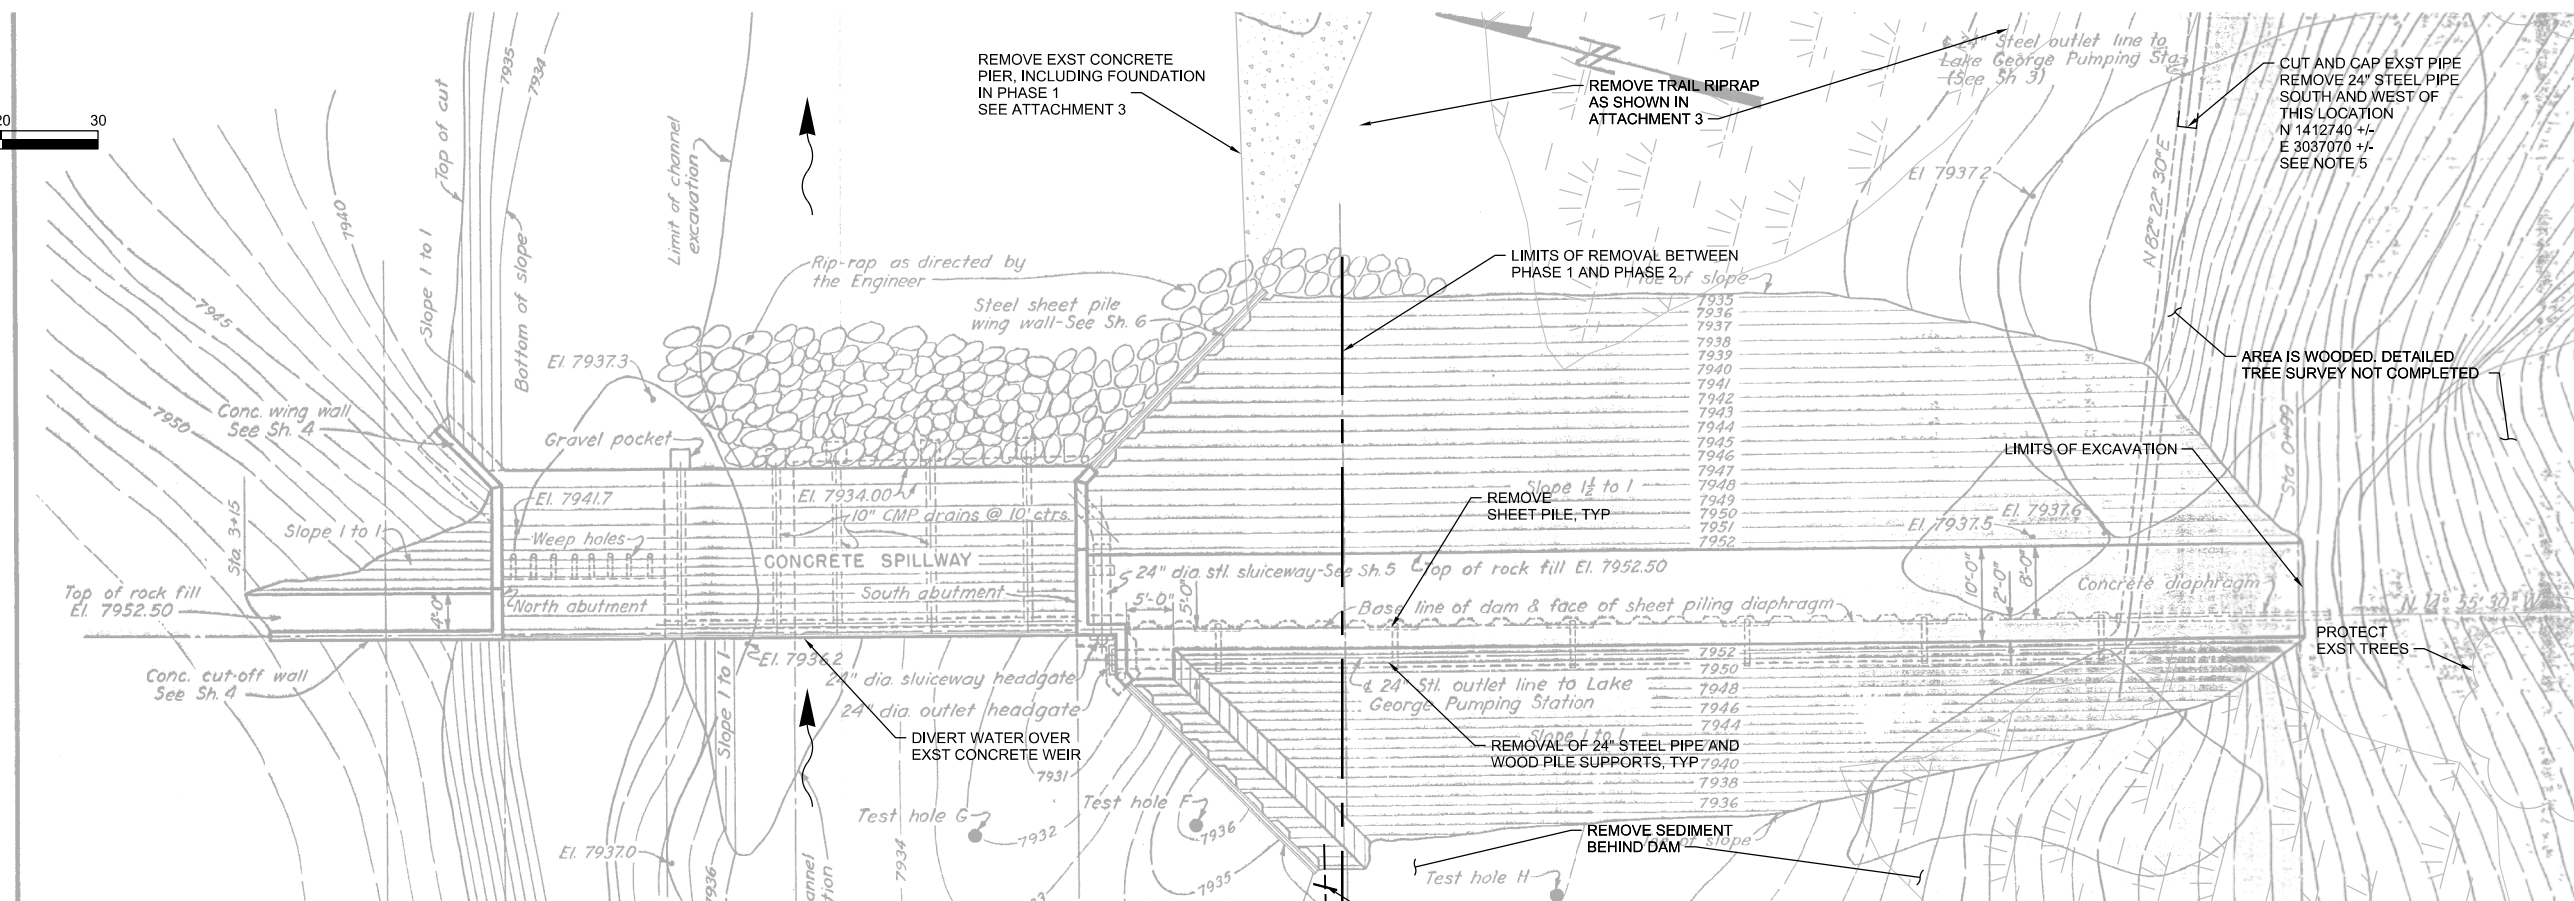



- ### PLAN VIEW



JACOBS'

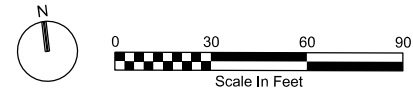

- NOTES:
- ALL DISTURBED AREAS SHALL BE RESEEDED WITH THE SEED MIX ON DWG G-0002.
 - PRIOR TO SEEDING, TOPSOIL SHALL BE CONDITIONED BY THE CONTRACTOR FOLLOWING SECTIONS 207 AND 212 (AND SUBSEQUENT REVISIONS) OF CDOT'S STANDARD SPECIFICATIONS.

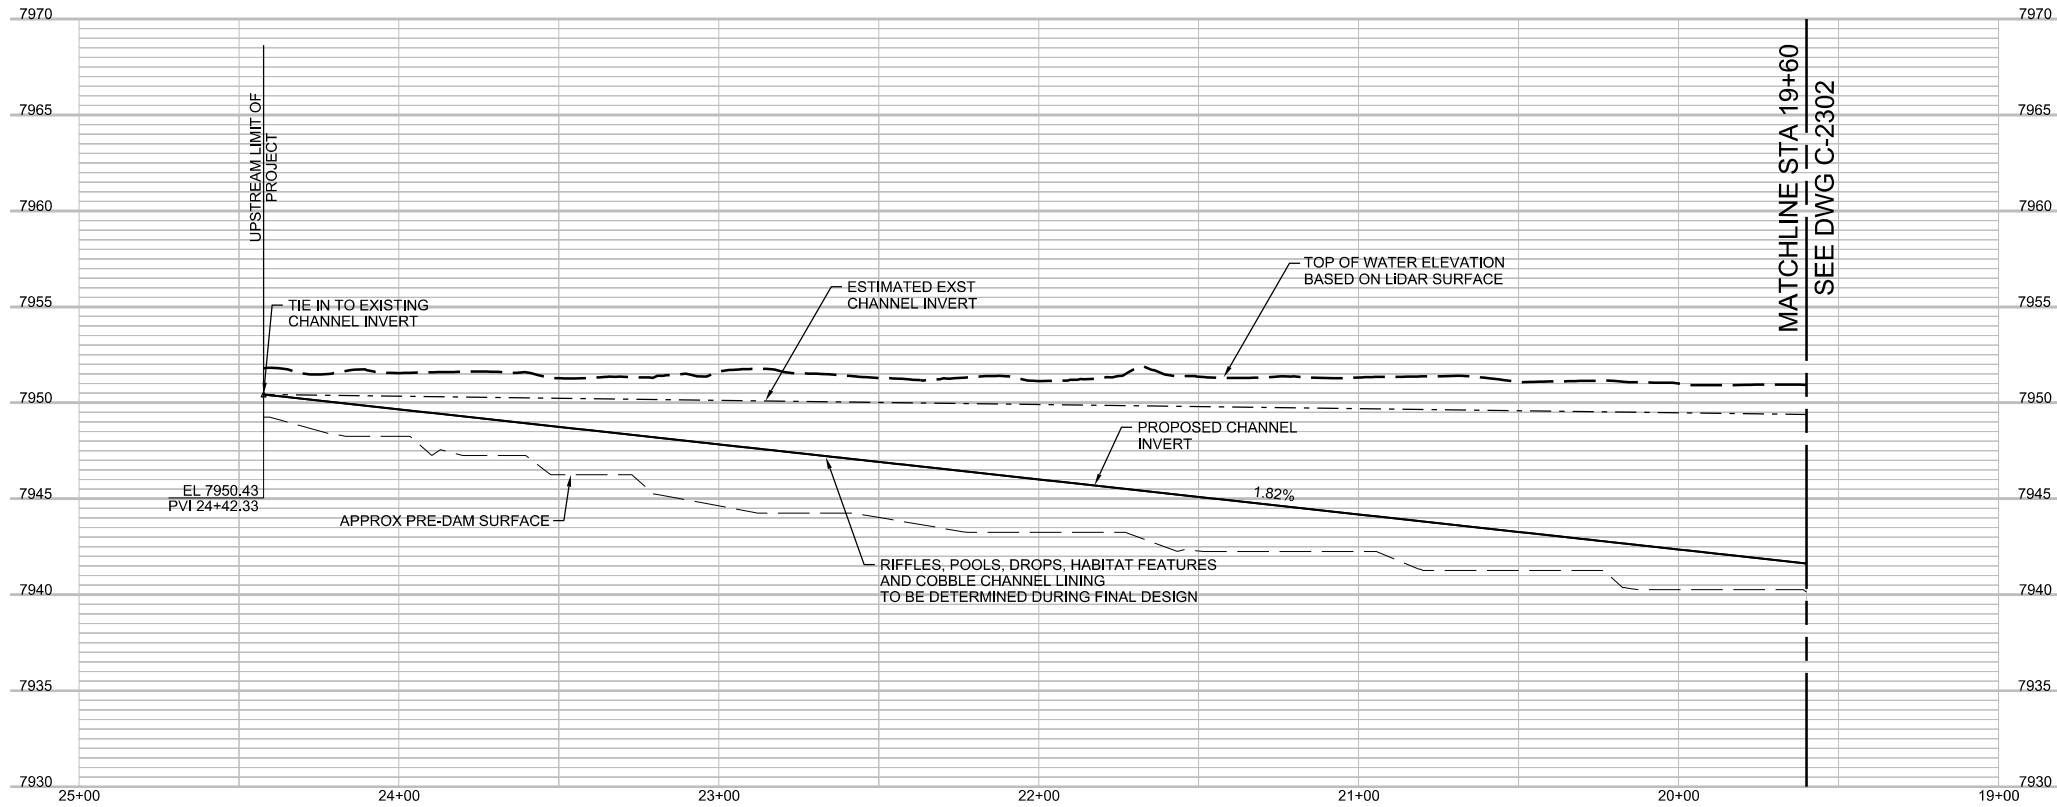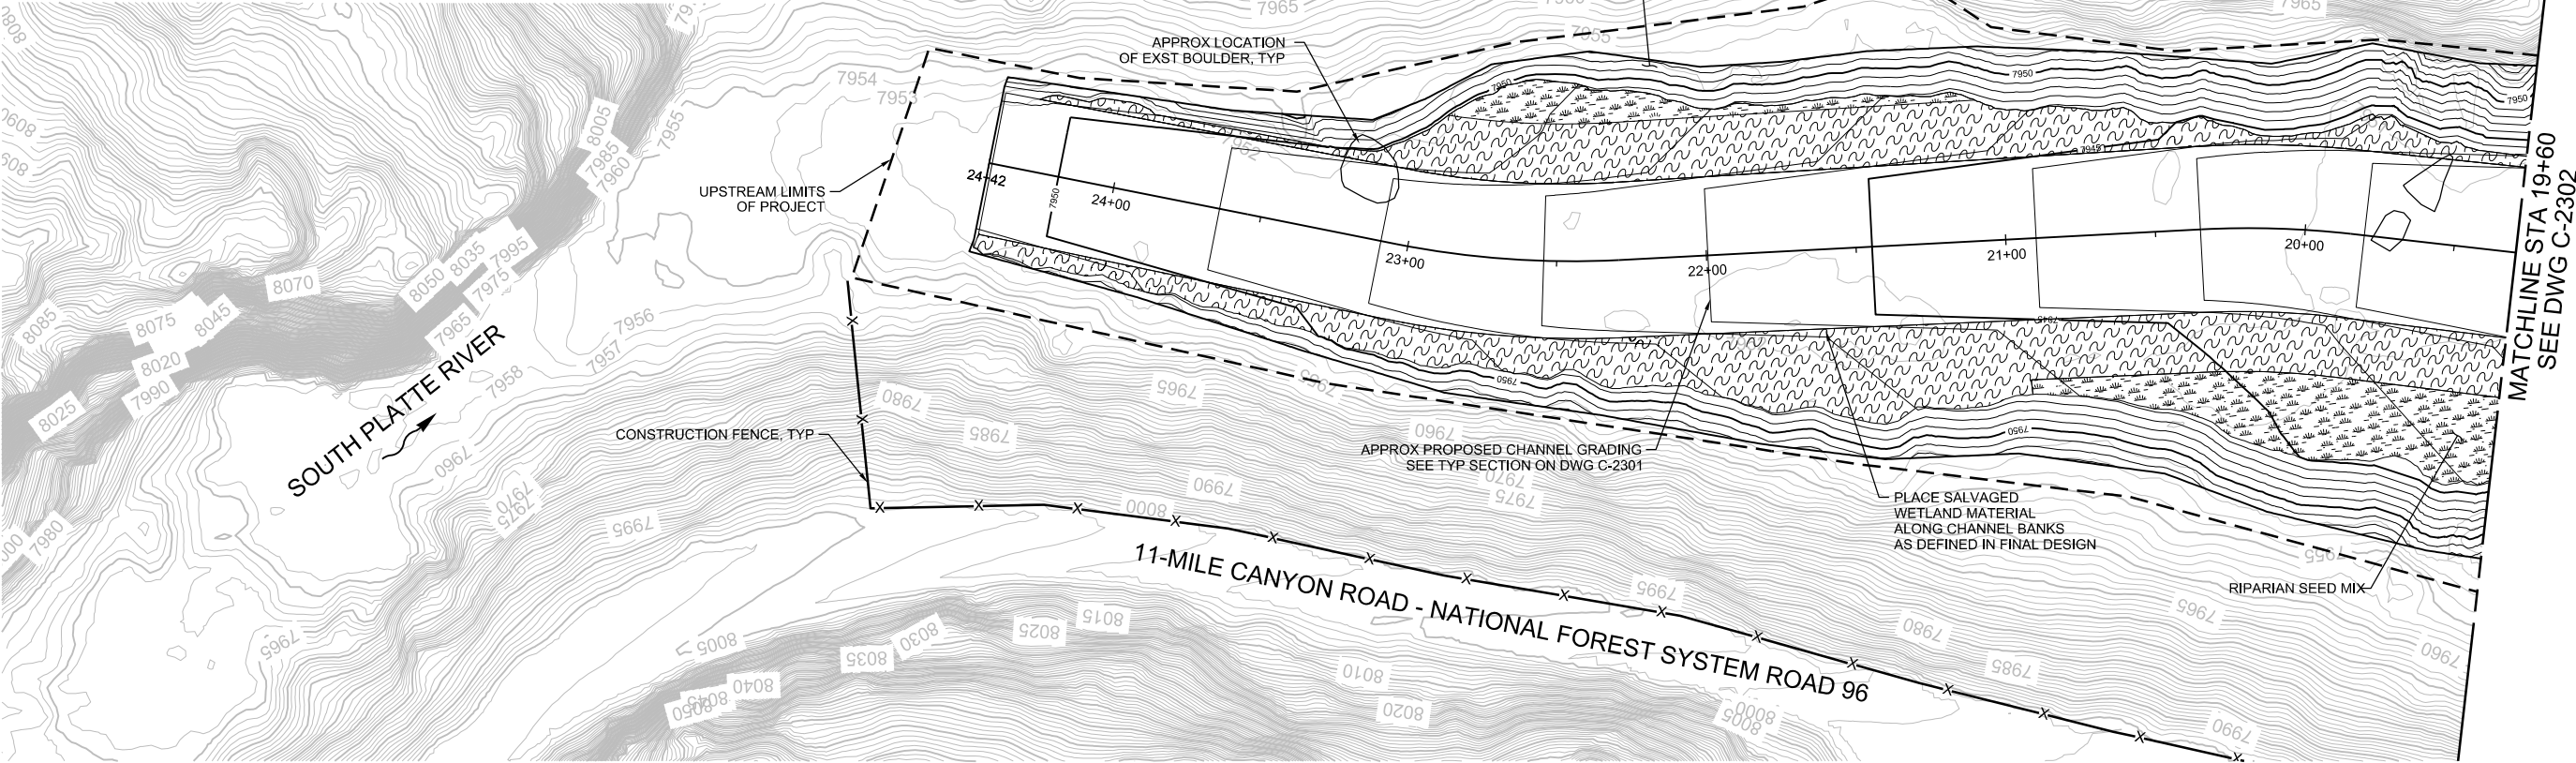

PRELIMINARY
NOT FOR
CONSTRUCTION

NO. DATE

REVISION

CHK

APVD

BY

APVD

DR

C PAJARES

F LAMBRECHTSEN

K HAMILTON

11-MILE CANYON DIVERSION DAM REMOVAL
PLAN AND PROFILE

VERIFY SCALE

BAR IS ONE INCH ON
ORIGINAL DRAWING, 1"

DATE OCT 2020

PROJ WXXY3000

DWG C-2301

SHEET 12 of 14

REUSE OF DOCUMENTS: THIS DOCUMENT, AND THE IDEAS AND DESIGNS INCORPORATED HEREIN, AS AN INSTRUMENT OF PROFESSIONAL SERVICE, IS THE PROPERTY OF CH2M HILL AND IS NOT TO BE USED, IN WHOLE OR IN PART, FOR ANY OTHER PROJECT WITHOUT THE WRITTEN AUTHORIZATION OF CH2M HILL.

© CH2M HILL 2018. ALL RIGHTS RESERVED.

\$PWURL

\$PWPATH

FILENAME: 11M-C-2301.dgn

PLOT DATE: 2020/10/14


PLOT TIME: 4:10:41 PM




PLOT TIME: 4:23:45 PM


ATTACHMENT 1
FIN-UP HABITAT CONSULTANTS
RESTORATION PLANS (13 SHEETS)

South Platte River Dam Removal Project 2020		Prepared For CUSP	
Checked by	Filename	Date November 2019	Scale
Fin-Up Habitat Consultants, Inc. 719 Brooks Ln. Sedalia, CO 80135 (719) 332-2550		South Platte River - Elevenmile Canyon Dam Removal Restoration CONCEPT Drawing	
DRAFT Drawing #1		Edition Ver. 1.0	Sheet 1

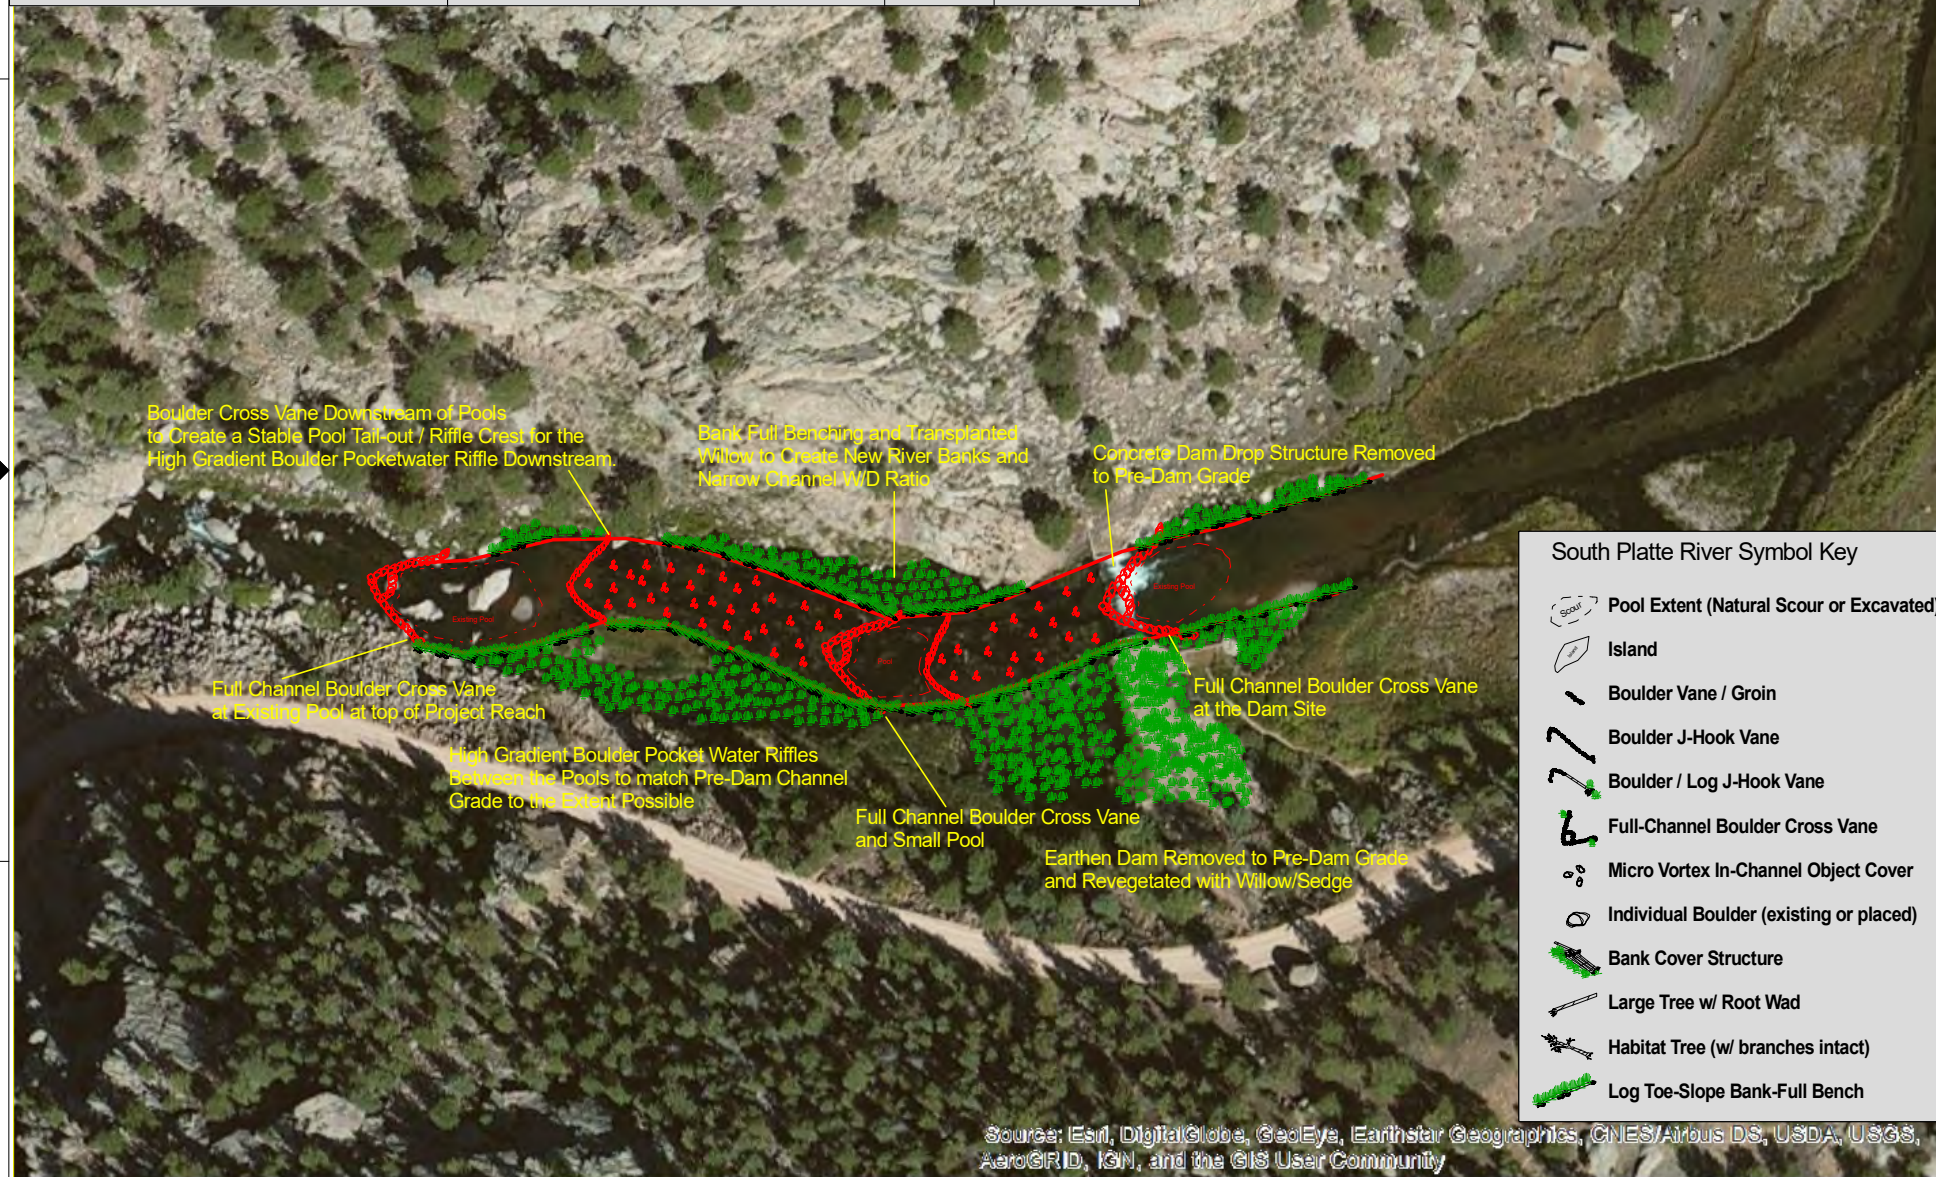

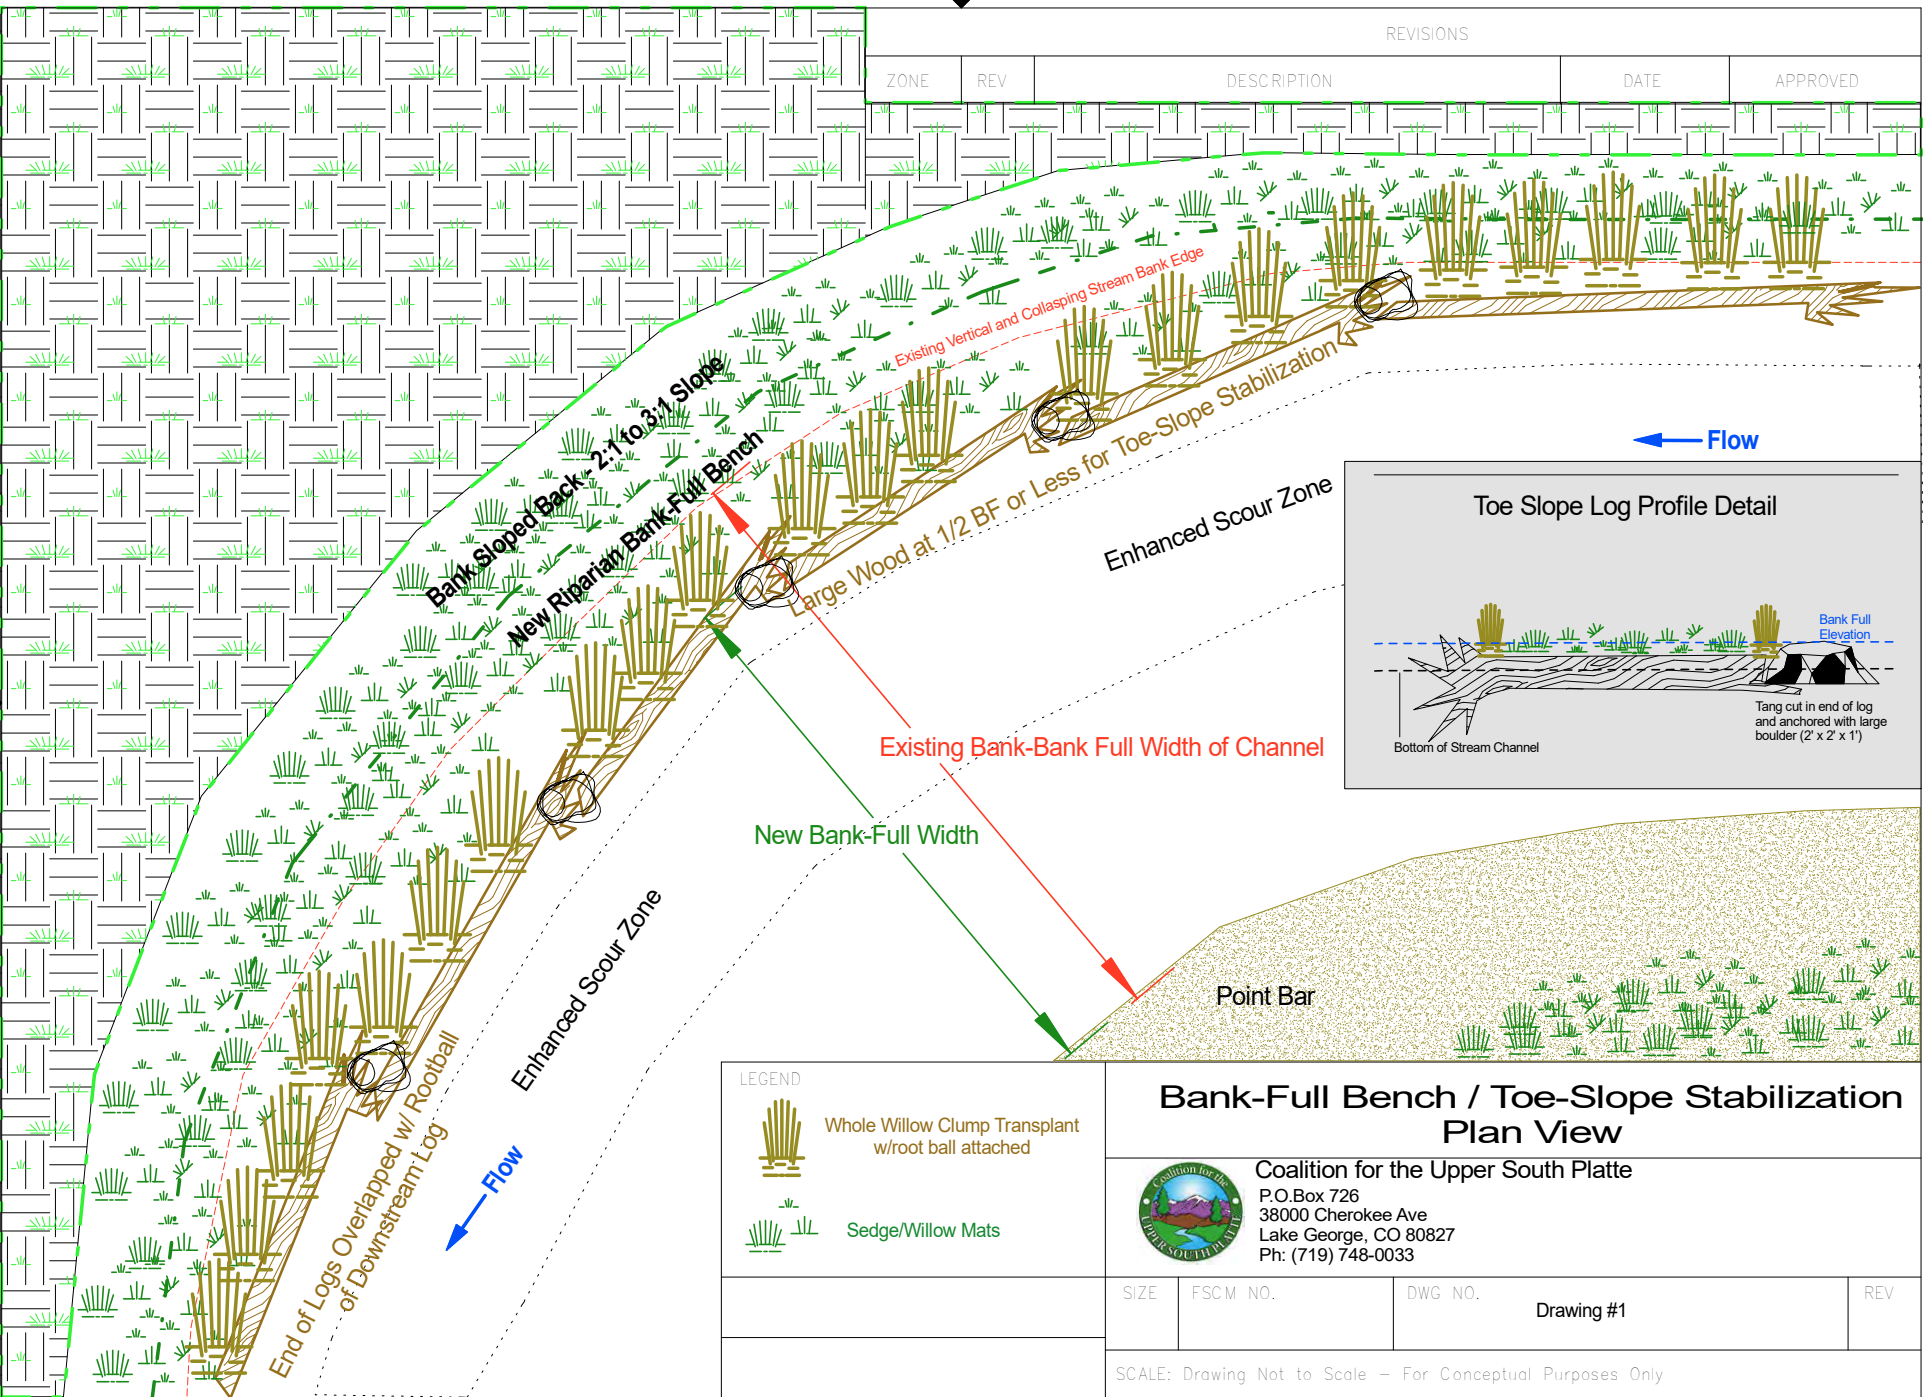

REVISIONS				
ZONE	REV	DESCRIPTION	DATE	APPROVED

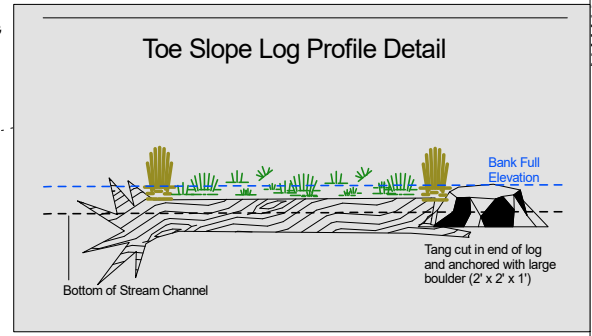

LEGEND	
	Whole Willow Clump Transplant w/root ball attached
	Sedge/Willow Mats

Bank-Full Bench / Toe-Slope Stabilization Plan View




Coalition for the Upper South Platte
P.O.Box 726
38000 Cherokee Ave
Lake George, CO 80827
Ph: (719) 748-0033

SIZE	FSCM NO.	DWG NO.	REV
		Drawing #1	

SCALE: Drawing Not to Scale - For Conceptual Purposes Only



REVISIONS				
ZONE	REV	DESCRIPTION	DATE	APPROVED

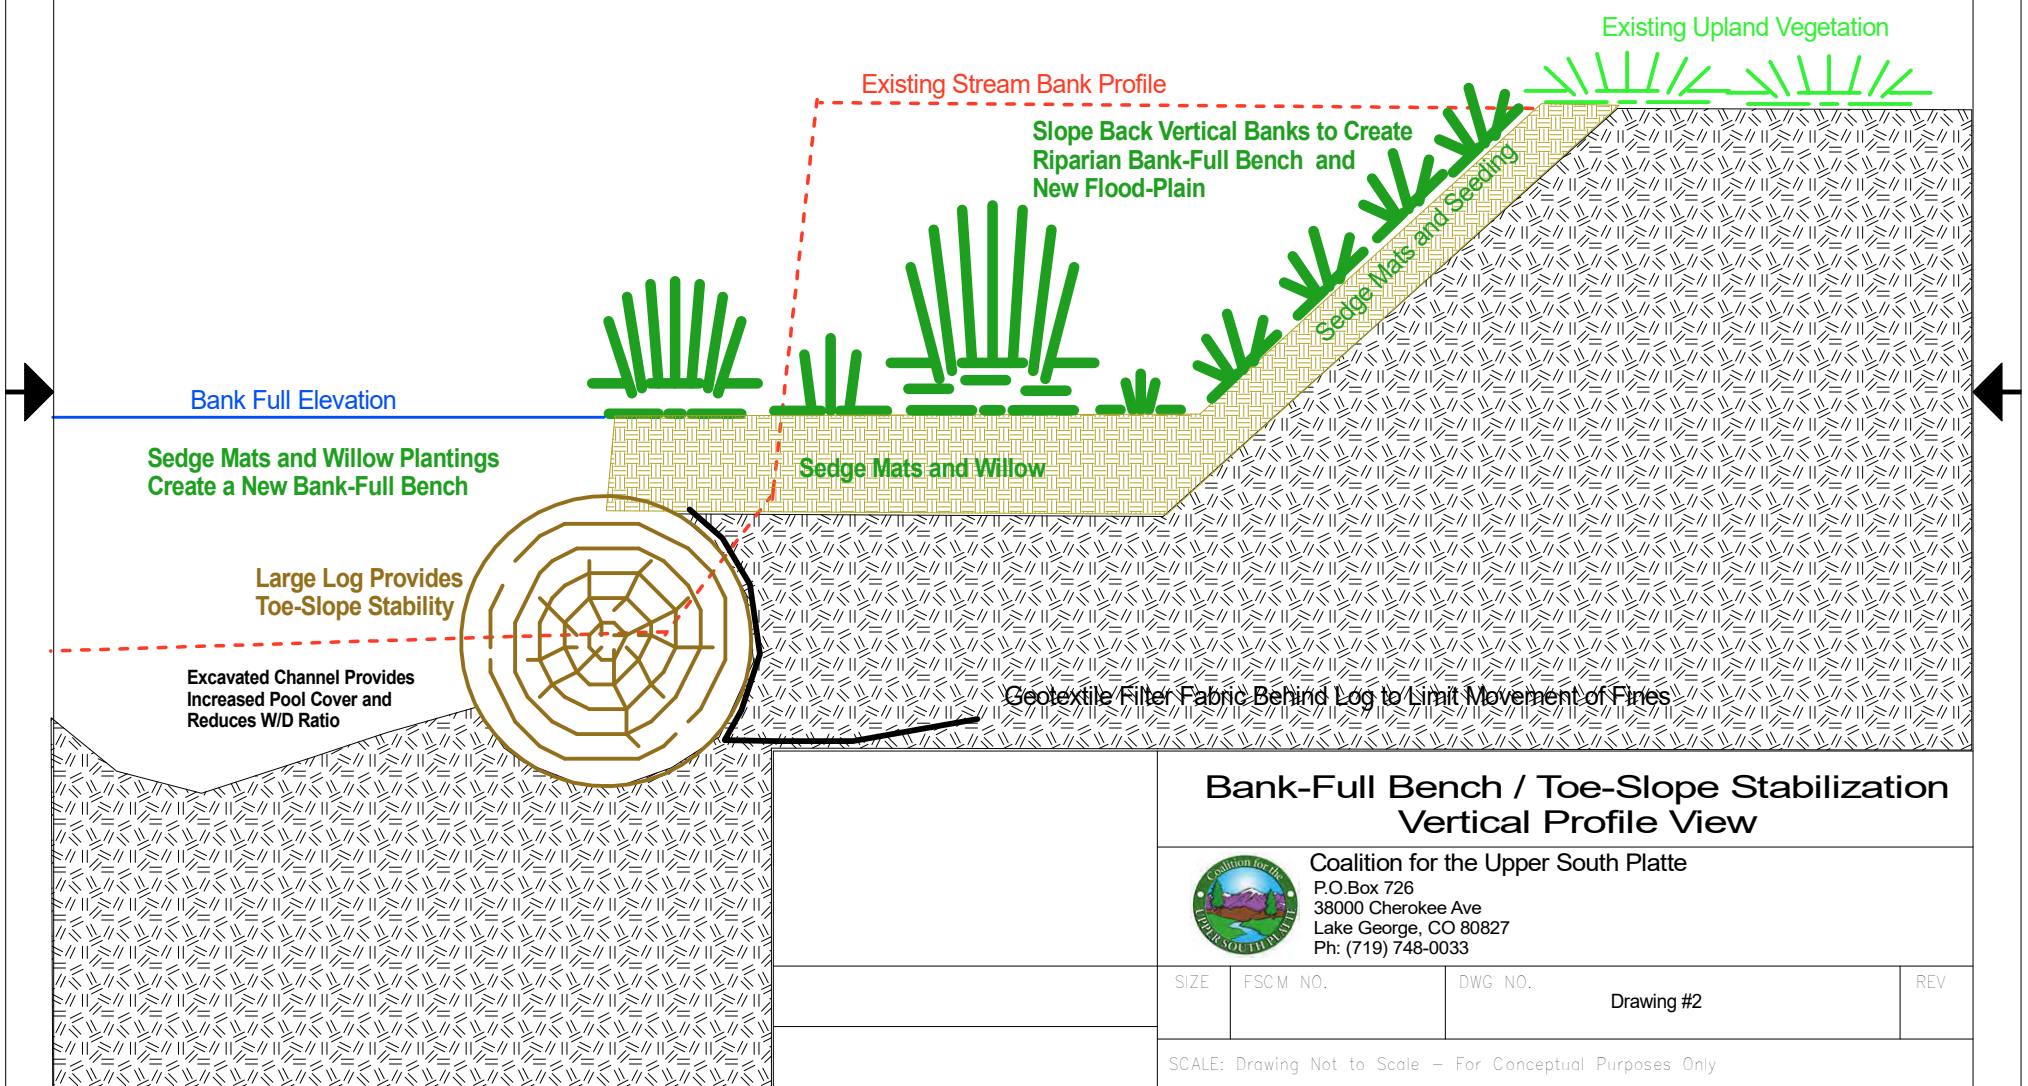

Bank-Full Bench / Toe-Slope Stabilization Vertical Profile View




Coalition for the Upper South Platte
P.O.Box 726
38000 Cherokee Ave
Lake George, CO 80827
Ph: (719) 748-0033

SIZE	FSCM NO.	DWG NO.	REV
		Drawing #2	

SCALE: Drawing Not to Scale - For Conceptual Purposes Only



REVISIONS				
ZONE	REV	DESCRIPTION	DATE	APPROVED

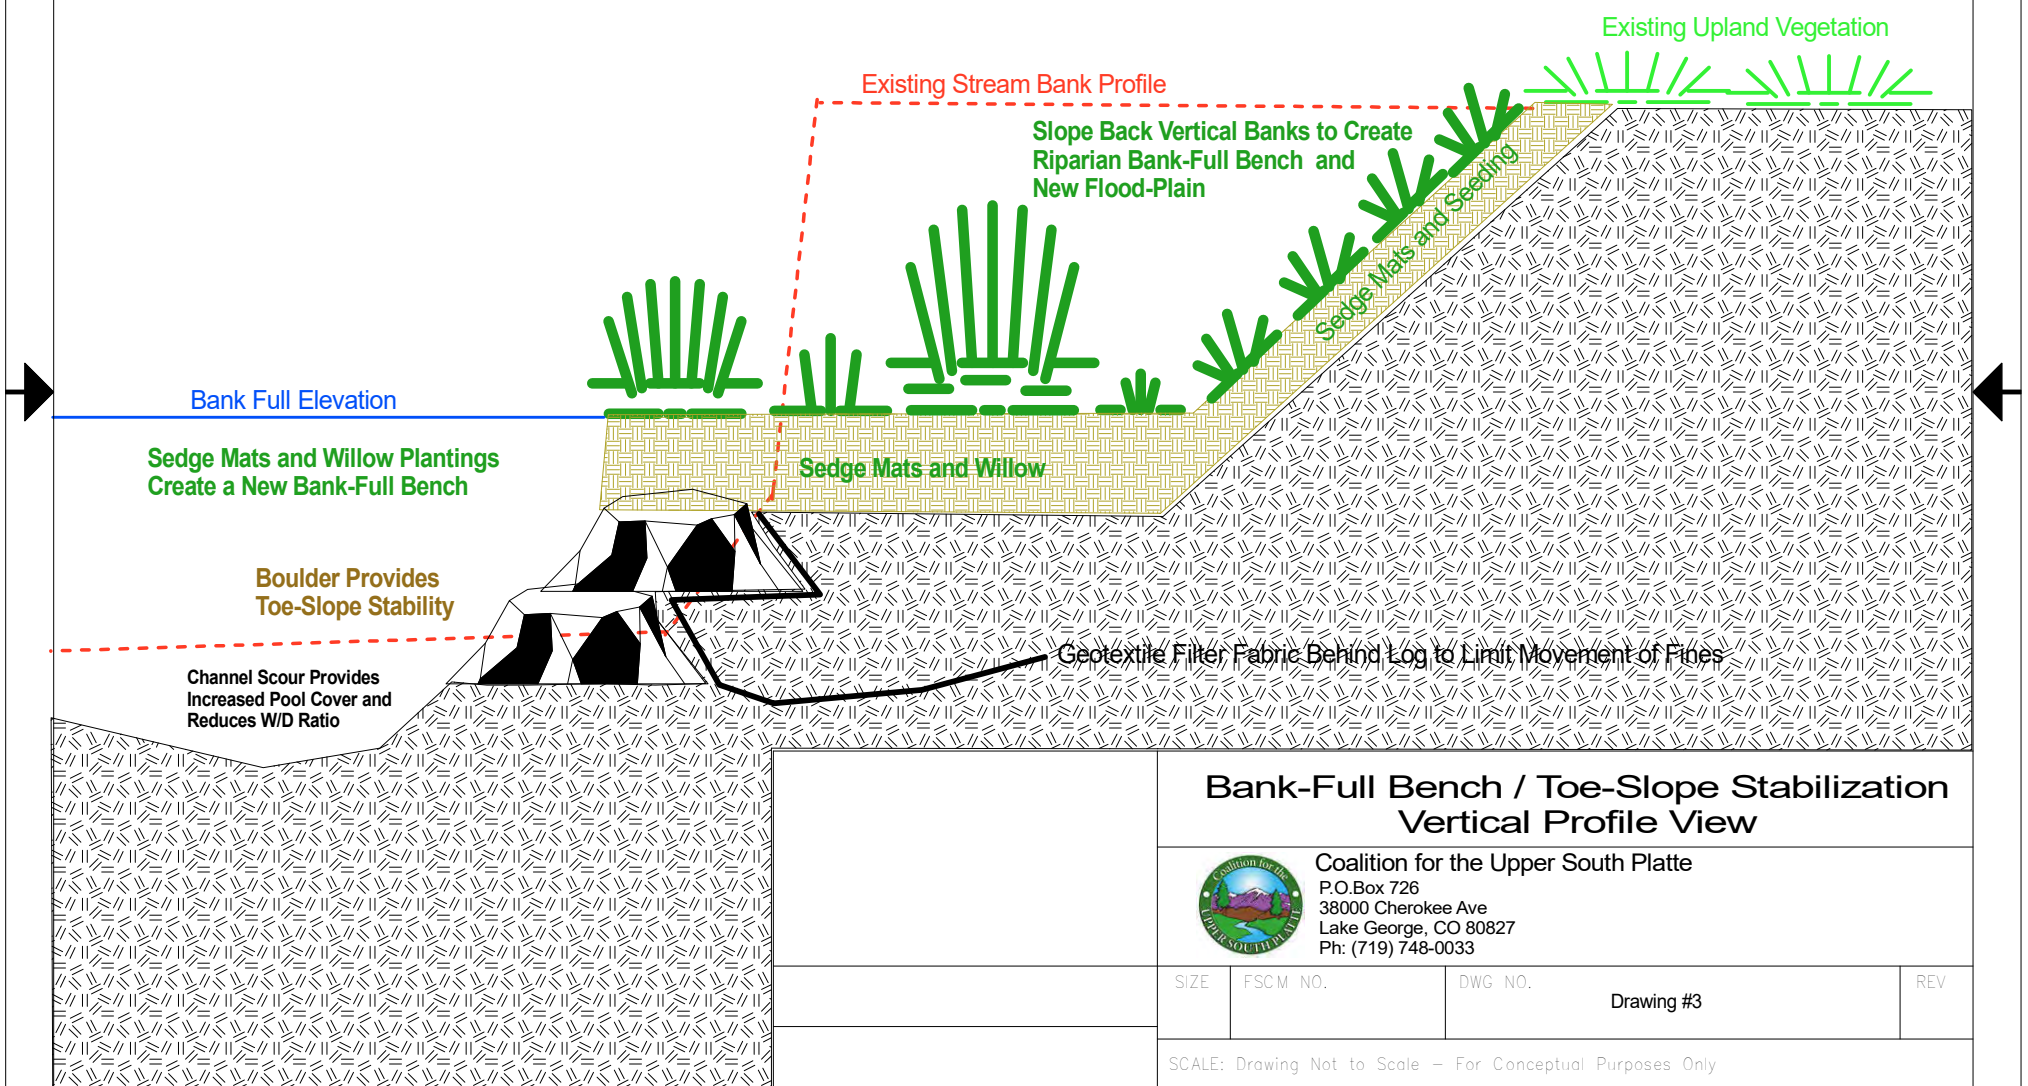


Bank-Full Bench / Toe-Slope Stabilization Vertical Profile View

 Coalition for the Upper South Platte
P.O.Box 726
38000 Cherokee Ave
Lake George, CO 80827
Ph: (719) 748-0033

SIZE	FSCM NO.	DWG NO.	Drawing #3	REV
------	----------	---------	------------	-----

SCALE: Drawing Not to Scale - For Conceptual Purposes Only



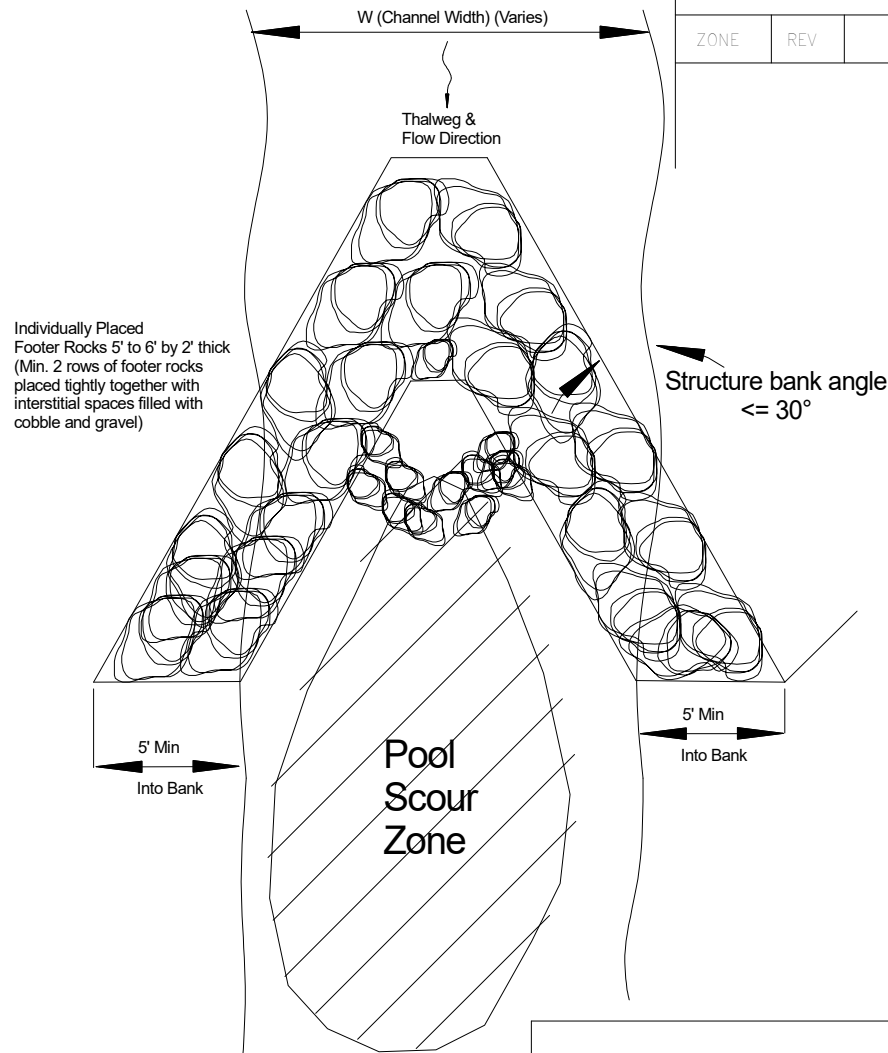

REVISIONS				
ZONE	REV	DESCRIPTION	DATE	APPROVED

Cross-Vane Plan View



Coalition for the Upper South Platte
P.O.Box 726
38000 Cherokee Ave
Lake George, CO 80827
Ph: (719) 748-0033

		SIZE	FSCM NO.	DWG NO.	REV
				Drawing #4	
SCALE: Drawing Not to Scale - For Conceptual Purposes Only					





REVISIONS

ZONE	REV	DESCRIPTION	DATE	APPROVED
------	-----	-------------	------	----------

- New Water Surface Slope
- New Channel Profile

Individually placed boulders
(3' to 4' by 3' thick)
Back-fill upstream of structure with stream substrate
to the level of the existing channel grade



Water Surface Slope

New Pool Scour

Channel Surface

4.0'

Existing Stream Substrate

6' to 12'

Cross-Vane Vertical Profile (Center of Structure)



Coalition for the Upper South Platte
P.O.Box 726
38000 Cherokee Ave
Lake George, CO 80827
Ph: (719) 748-0033

SIZE	FSCM NO.	DWG NO.	REV
		Drawing #5	


SCALE: Drawing Not to Scale - For Conceptual Purposes Only





REVISIONS				
ZONE	REV	DESCRIPTION	DATE	APPROVED

Structure Cross Vane Wings descend from Bank Full Elevation where they tie into the stream bank to $\leq 1/2$ Max Bank Full Depth at the center of the structure. Structure walls slope toward center of stream at between 5-10 degree slope.

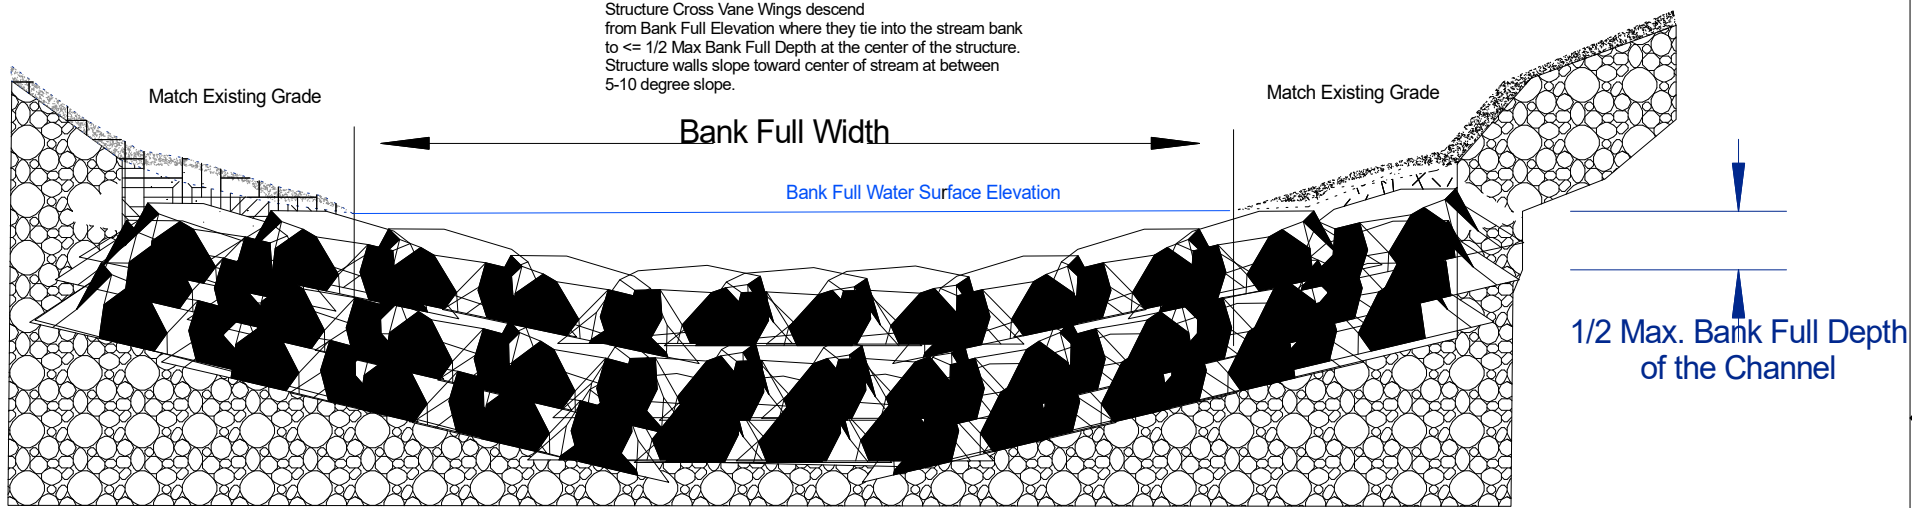

Cross-Vane Vertical Profile Cross Section Elevations)



Coalition for the Upper South Platte
P.O.Box 726
38000 Cherokee Ave
Lake George, CO 80827
Ph: (719) 748-0033

	SIZE	FSCM NO.	DWG NO.	Drawing #6	REV

SCALE: Drawing Not to Scale - For Conceptual Purposes Only





REVISIONS				
ZONE	REV	DESCRIPTION	DATE	APPROVED

35' - 70'

Individually Placed
Footer Rocks 3' to 4' by 3' thick
(Min. 1 row of footer rocks
placed tightly together with
interstitial spaces filled with
cobble and gravel)

Structure bank angle
 $\leq 30^\circ$

Thalweg &
Flow Direction

Scour
Zone

4" - 6" Gaps may be set between boulders
at the "J" end of the J-Hook to enhance
flow complexity and improve holding and
feeding habitats for trout.
(Optional - Depending on vertical channel stability)

Up to 1/3 Bank Full Channel Width

Bank Full Channel Width (Varies)

5' Min
Into Bank

Rock J-Hook Vane - Plan View



Coalition for the Upper South Platte
P.O.Box 726
38000 Cherokee Ave
Lake George, CO 80827
Ph: (719) 748-0033

SIZE	FSCM NO.	DWG NO.	REV
		Drawing #8	

SCALE: Drawing Not to Scale - For Conceptual Purposes Only





REVISIONS				
ZONE	REV	DESCRIPTION	DATE	APPROVED

Match Existing Grade

Top elevation of large tree descends from Bank Full Elevation where it ties into the stream bank to $\leq 1/2$ Max Bank Full Depth . Structure walls slope toward center of stream at between 5-10 degree slope.

Bank Full Water Surface Elevation

1/2 Max. Bank Full Depth of the Channel

Manta-Ray Deadman Anchors
Driven 3' to 4' into stream substrate and set with excavator. Stainless Steel Cable wrapped around tree bole and secured with cable clamps (Optional)

Habitat Tree Anchoring Detail Vertical Profile



Coalition for the Upper South Platte
P.O.Box 726
38000 Cherokee Ave
Lake George, CO 80827
Ph: (719) 748-0033

	Habitat Tree Anchoring Detail Vertical Profile			
	 Coalition for the Upper South Platte P.O.Box 726 38000 Cherokee Ave Lake George, CO 80827 Ph: (719) 748-0033			
	SIZE	FSCM NO.	DWG NO.	REV
			Drawing #9	
SCALE: Drawing Not to Scale - For Conceptual Purposes Only				






REVISIONS				
ZONE	REV	DESCRIPTION	DATE	APPROVED

Match Existing Grade

Top elevation of vane descends from Bank Full Elevation where it ties into the stream bank to $\leq 1/2$ Max Bank Full Depth . Structure walls slope toward center of stream at between 5 -10 degree slope.

Bank Full Water Surface Elevation

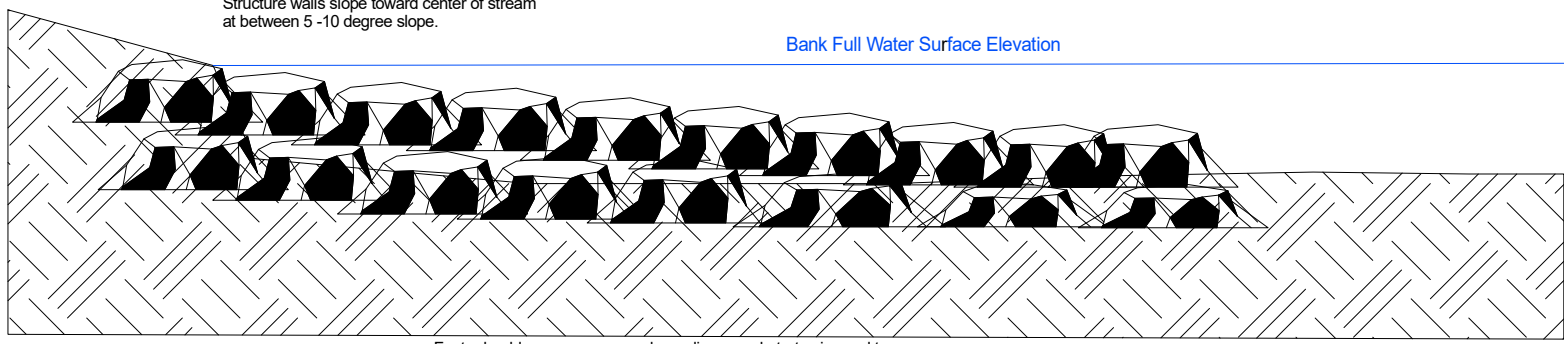

1/2 Max. Bank Full Depth of the Channel

Footer boulders as necessary depending on substrate size and type


J-Hook / Boulder Vane Vertical Profile




Coalition for the Upper South Platte
P.O.Box 726
38000 Cherokee Ave
Lake George, CO 80827
Ph: (719) 748-0033

	J-Hook / Boulder Vane Vertical Profile			
	Coalition for the Upper South Platte P.O.Box 726 38000 Cherokee Ave Lake George, CO 80827 Ph: (719) 748-0033			
	SIZE	FSCM NO.	DWG NO. Drawing #10	REV
	SCALE: Drawing Not to Scale – For Conceptual Purposes Only			




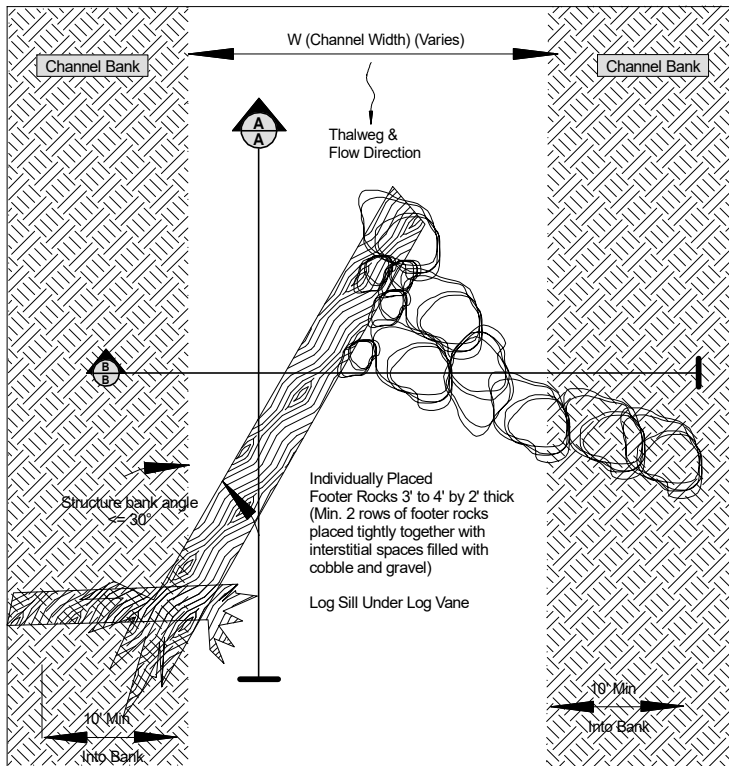

Detail Drawing #11 - Log/ Boulder J-Hook Vane Plan View
Not To Scale

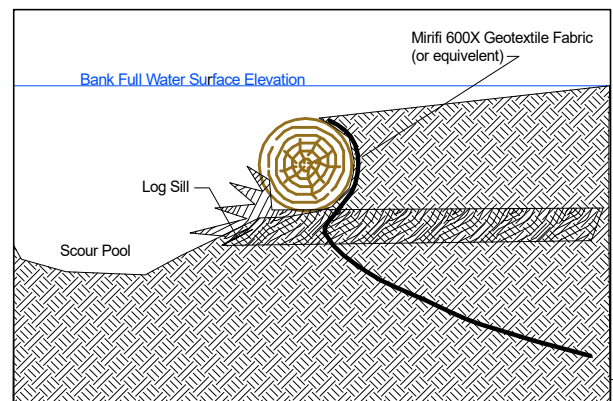

Long. A-A Log / Boulder J-Hook Vane Profile
Not To Scale

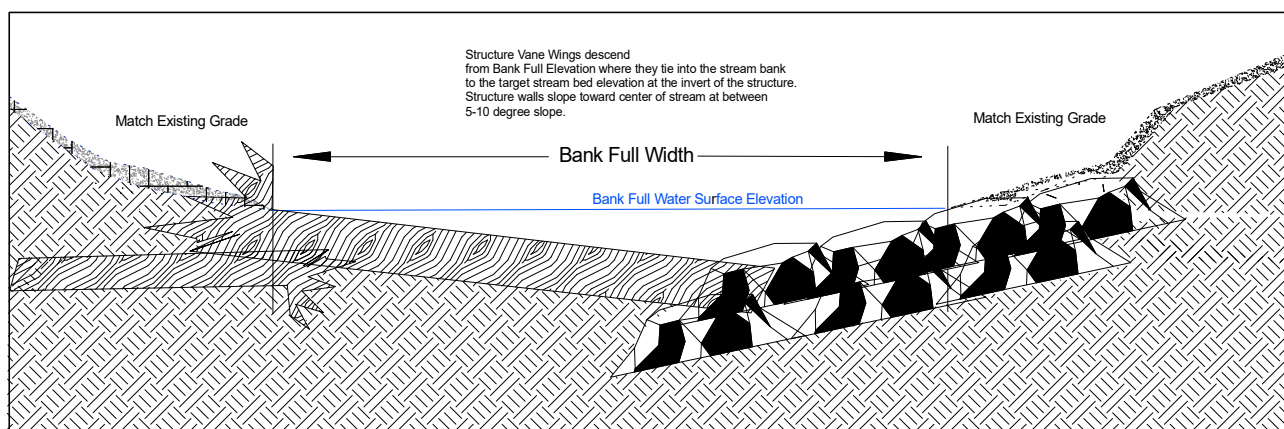

Cross Section B-B Log / Boulder J-Hook Vane Profile
Not To Scale

Drafted by
P. Gallagher - Fin-Up, Inc.

Checked by

Filename
11_LogJHook Detail.SKF

Date
July 16, 2014

Scale
NTS




Coalition for the Upper South Platte
P.O. Box 726
38000 Cherokee Ave
Lake George, CO 80827
Ph: (719) 748-0033

Log / Boulder J-Hook Vane Detail

Drawing #11


Edition
V3

Sheet

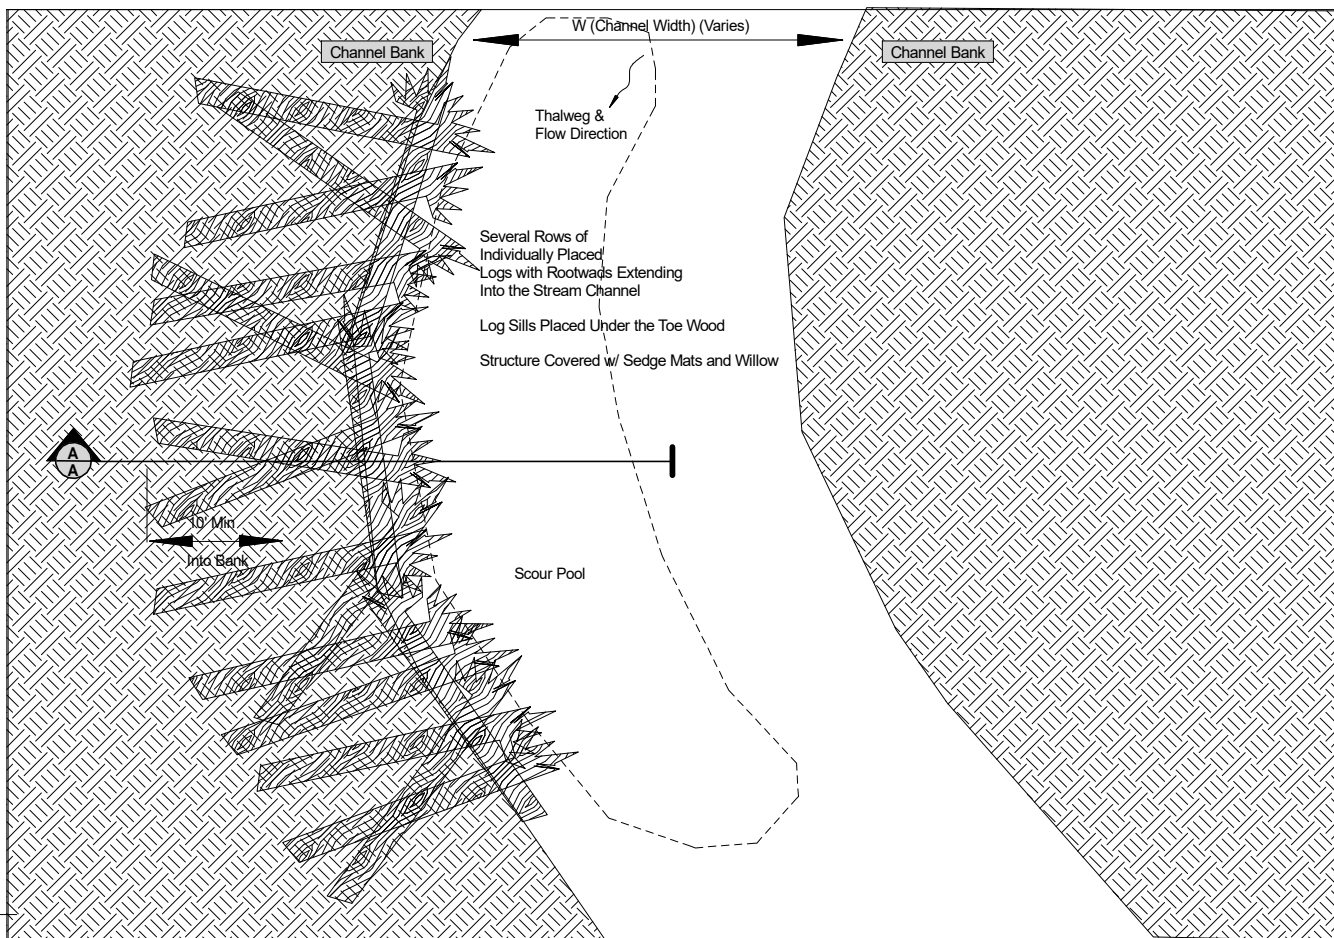

Detail Drawing #12 - Toe Wood Pool Plan View

Not To Scale

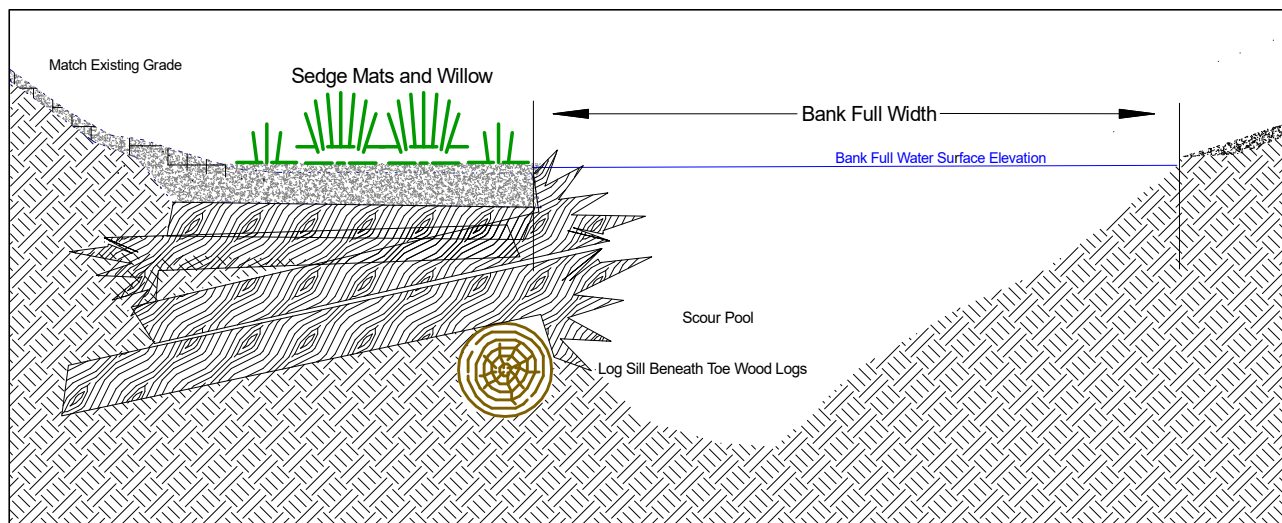

Cross Section A-A Toe Wood Pool Profile

Not To Scale

Drafted by
P. Gallagher - Fin-Up, Inc.

Checked by

Filename
12_Toe Wood Detail.SKF

Date
July 16, 2014

Scale
NTS



Coalition for the Upper South Platte
P.O. Box 726
38000 Cherokee Ave
Lake George, CO 80827
Ph: (719) 748-0033

Toe Wood Detail

Drawing #12

Edition
V3

Sheet

ATTACHMENT 2

11-MILE CANYON DIVERSION DAM AS-BUILTS (7 SHEETS)



FOR INFORMATION ONLY, SITE CONDITIONS MAY VARY

**PLANS FOR
WATER SUPPLY DEVELOPMENT
COLORADO SPRINGS, COLORADO**

CONTRACT NO. 5

LAKE GEORGE DIVERSION DAM

**BLACK & VEATCH
CONSULTING ENGINEERS
KANSAS CITY, MO.
1952**

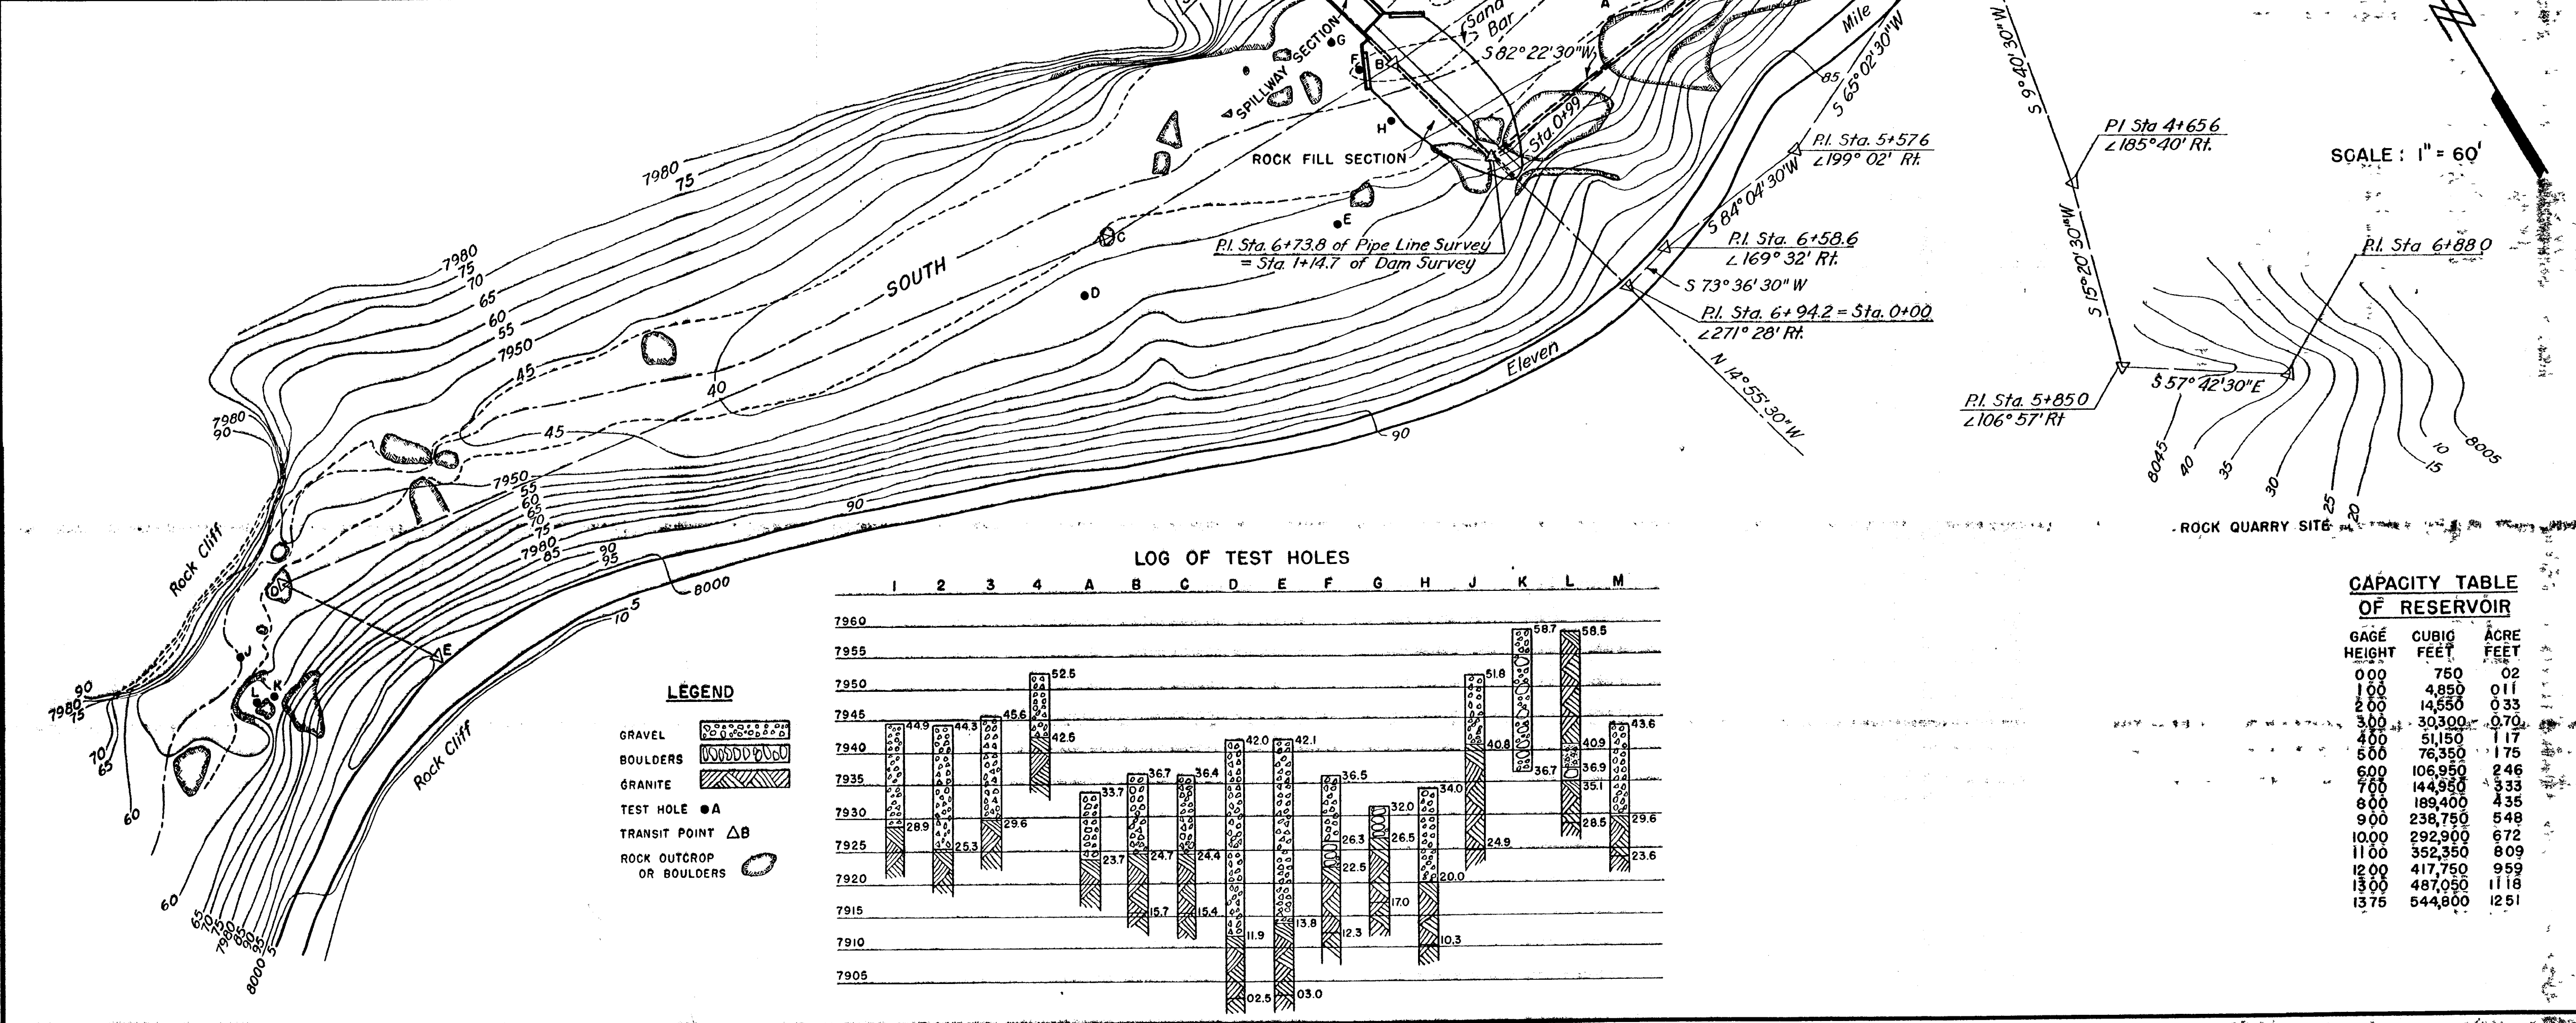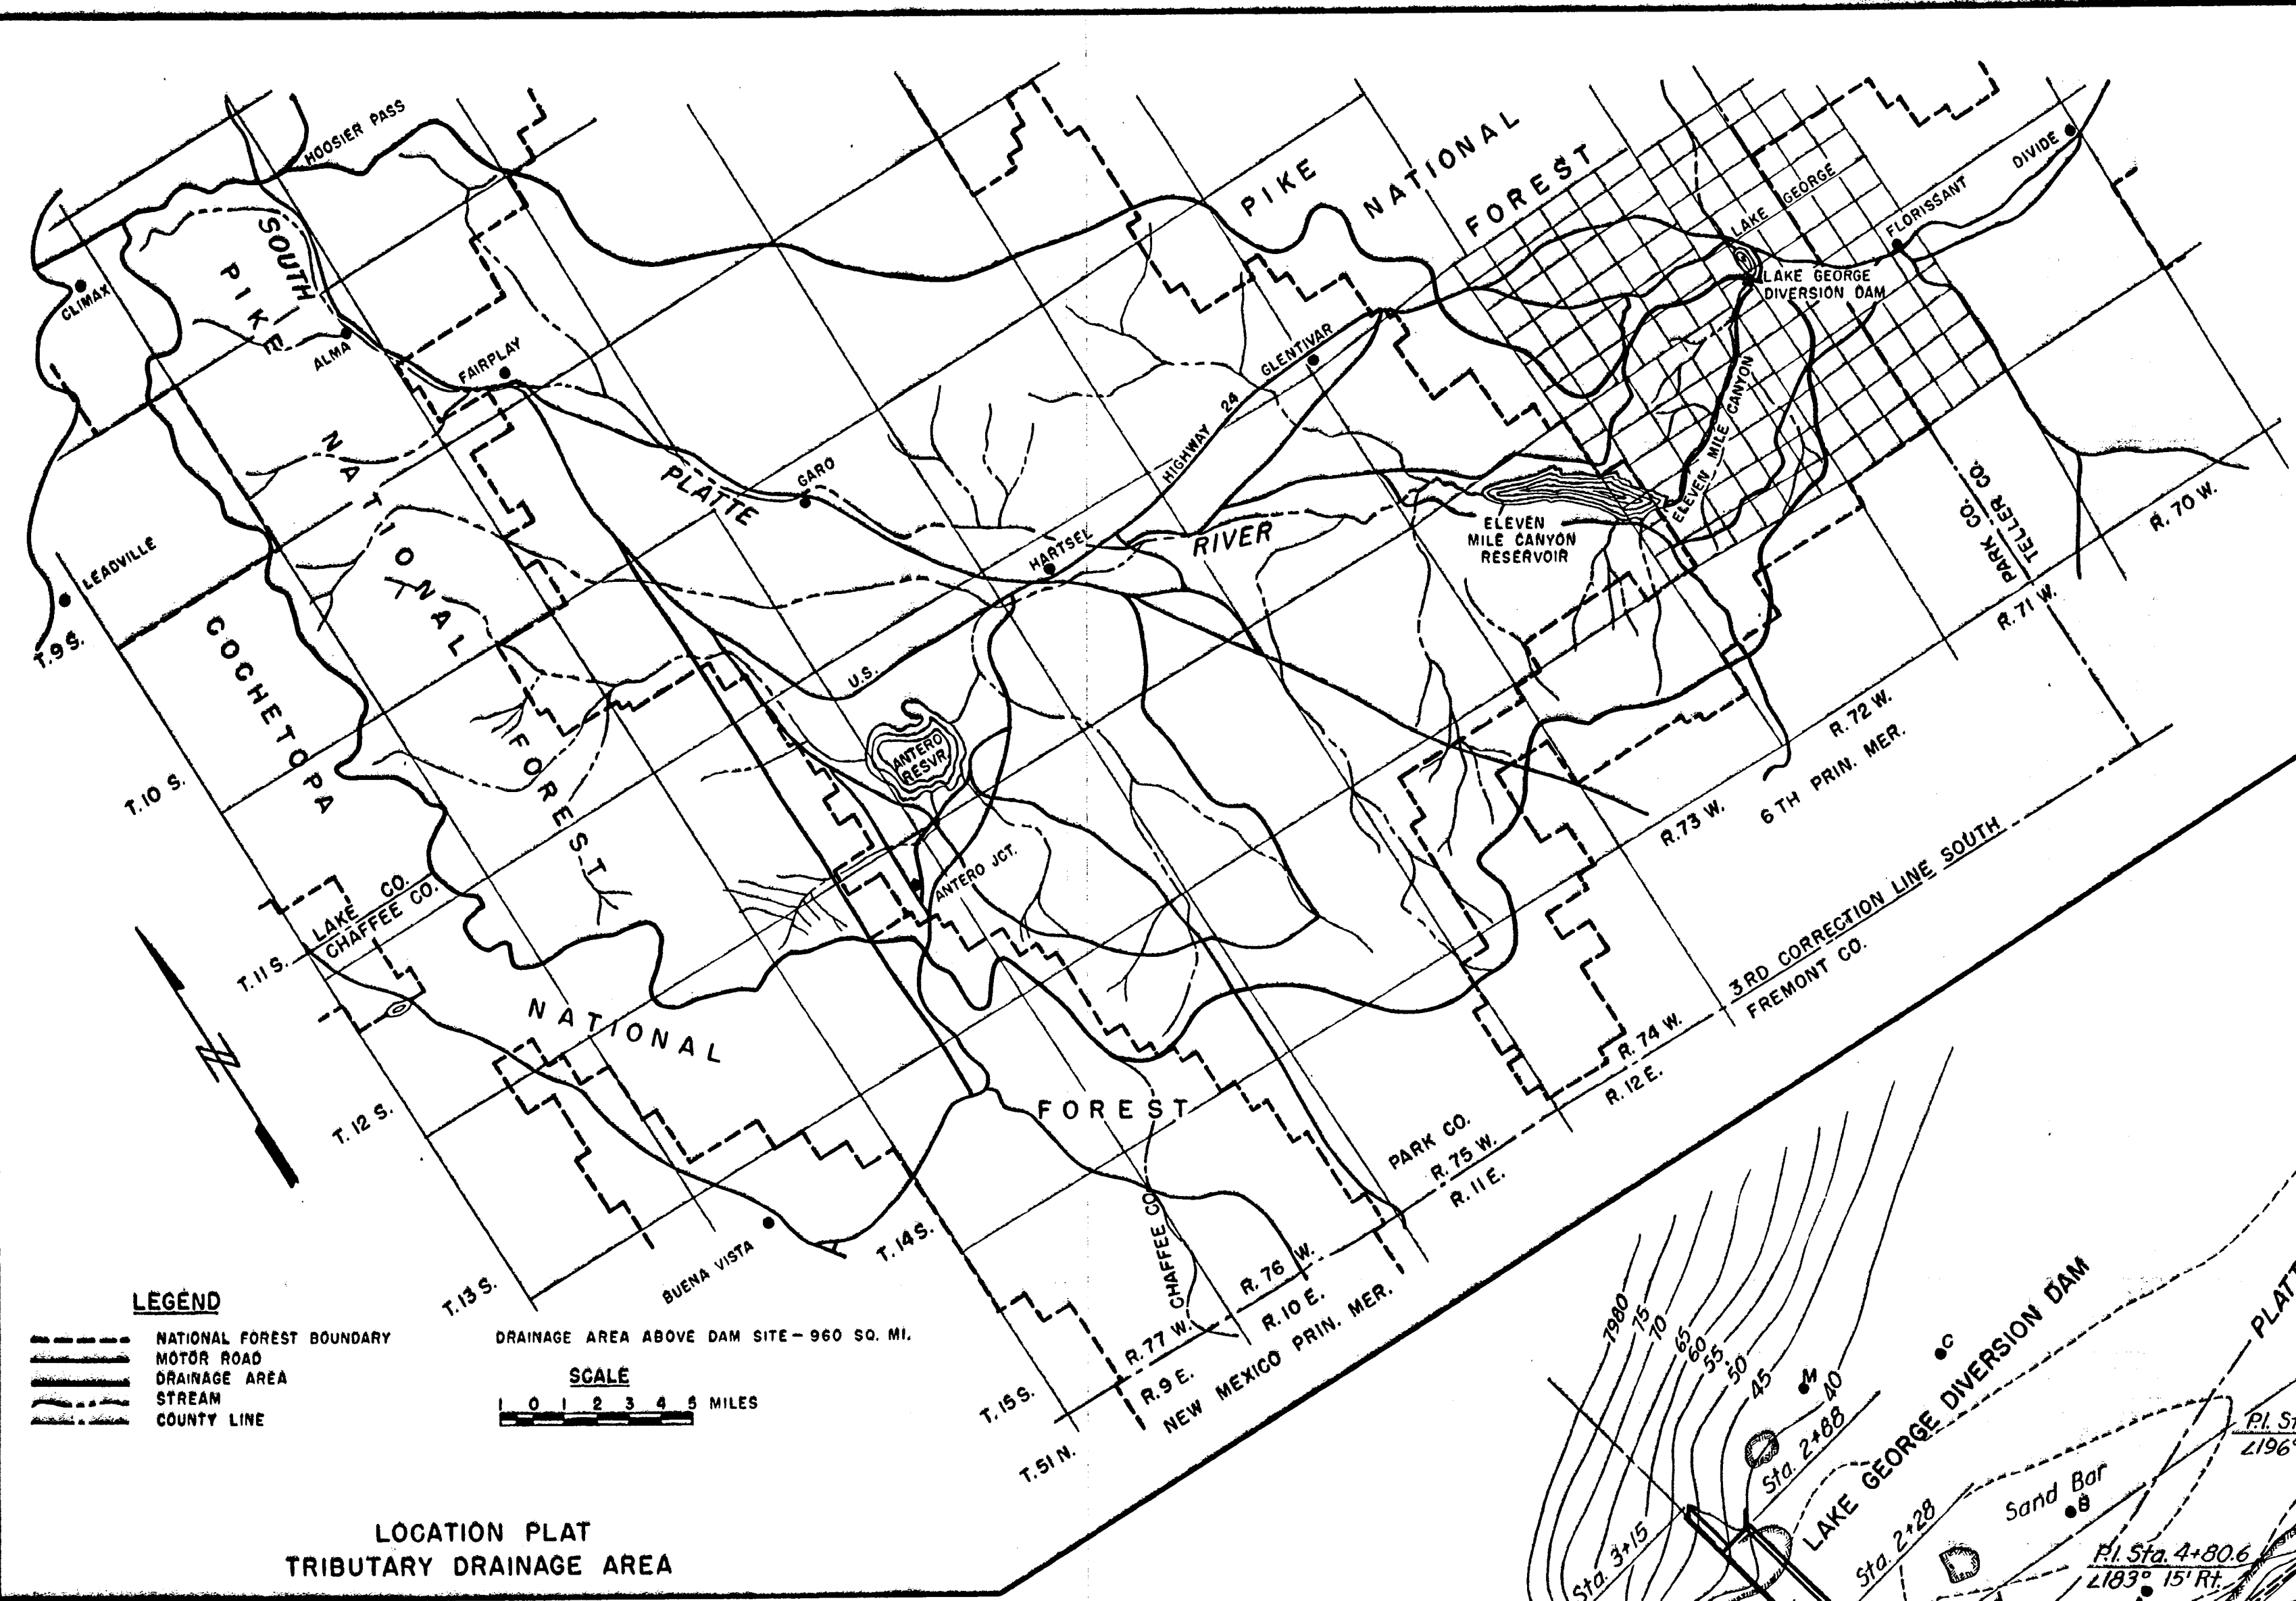

LOG OF TEST HOLES

	1	2	3	4	A	B	C	D	E	F	G	H	J	K	L	M
7960																
7955																
7950																
7945	44.9	44.3	45.6	52.5	42.5											
7940	28.9	25.3	29.6	33.7	26.7	36.4	42.0	42.1	36.5	34.0	40.8	36.7	40.9	36.9	43.6	
7935																
7930																
7925																
7920																
7915																
7910																
7905																

CAPACITY TABLE OF RESERVOIR

GAGE HEIGHT	CUBIC FEET	ACRE FEET
000	760	02
100	4,850	011
200	14,550	033
300	30,300	070
400	51,150	117
500	76,350	175
600	106,950	246
700	144,950	333
800	189,400	435
900	236,750	548
1000	292,900	672
1100	352,350	809
1200	417,750	959
1300	487,050	1118
1375	544,800	1251

I HEREBY CERTIFY THAT THESE PLANS FOR THE CONSTRUCTION OF THE LAKE GEORGE DIVERSION DAM WERE PREPARED UNDER MY DIRECT SUPERVISION FOR THE OWNERS THEREOF.

W. J. Veatch
REGISTERED ENGINEER

SUBSCRIBED AND SWORN TO BEFORE ME THIS 2nd DAY OF JULY 1952.

John A. ...
(NOTARY PUBLIC)

MY COMMISSION EXPIRES ON THE 12th DAY OF January 1953.

THESE PLANS FOR THE CONSTRUCTION OF THE LAKE GEORGE DIVERSION DAM ARE HEREBY APPROVED AND ACCEPTED BY THE CITY OF COLORADO SPRINGS, COLORADO (OWNER).

G. Harry ...
MAYOR

APPROVED ON THE 30th DAY OF July 1952.

W. J. Veatch
STATE ENGINEER

FILE NO. ... DEPUTY

LAKE GEORGE DIVERSION DAM
IRRIGATION DIVISION NO. 17 WATER DISTRICT NO. 23
PARK COUNTY


COLORADO SPRINGS, COLORADO
WATER SUPPLY DEVELOPMENT

LOCATION PLAT & GENERAL LAYOUT


BLACK & VEATCH
CONSULTING ENGINEERS - KANSAS CITY, MO.

DESIGNED BY D.P.P. CHECKED BY W.J.V.
DETAILED BY W.J.V. APPROVED BY W.J.V.
TRACED BY R.H.Z. DATE: JULY 2, 1952

C-617

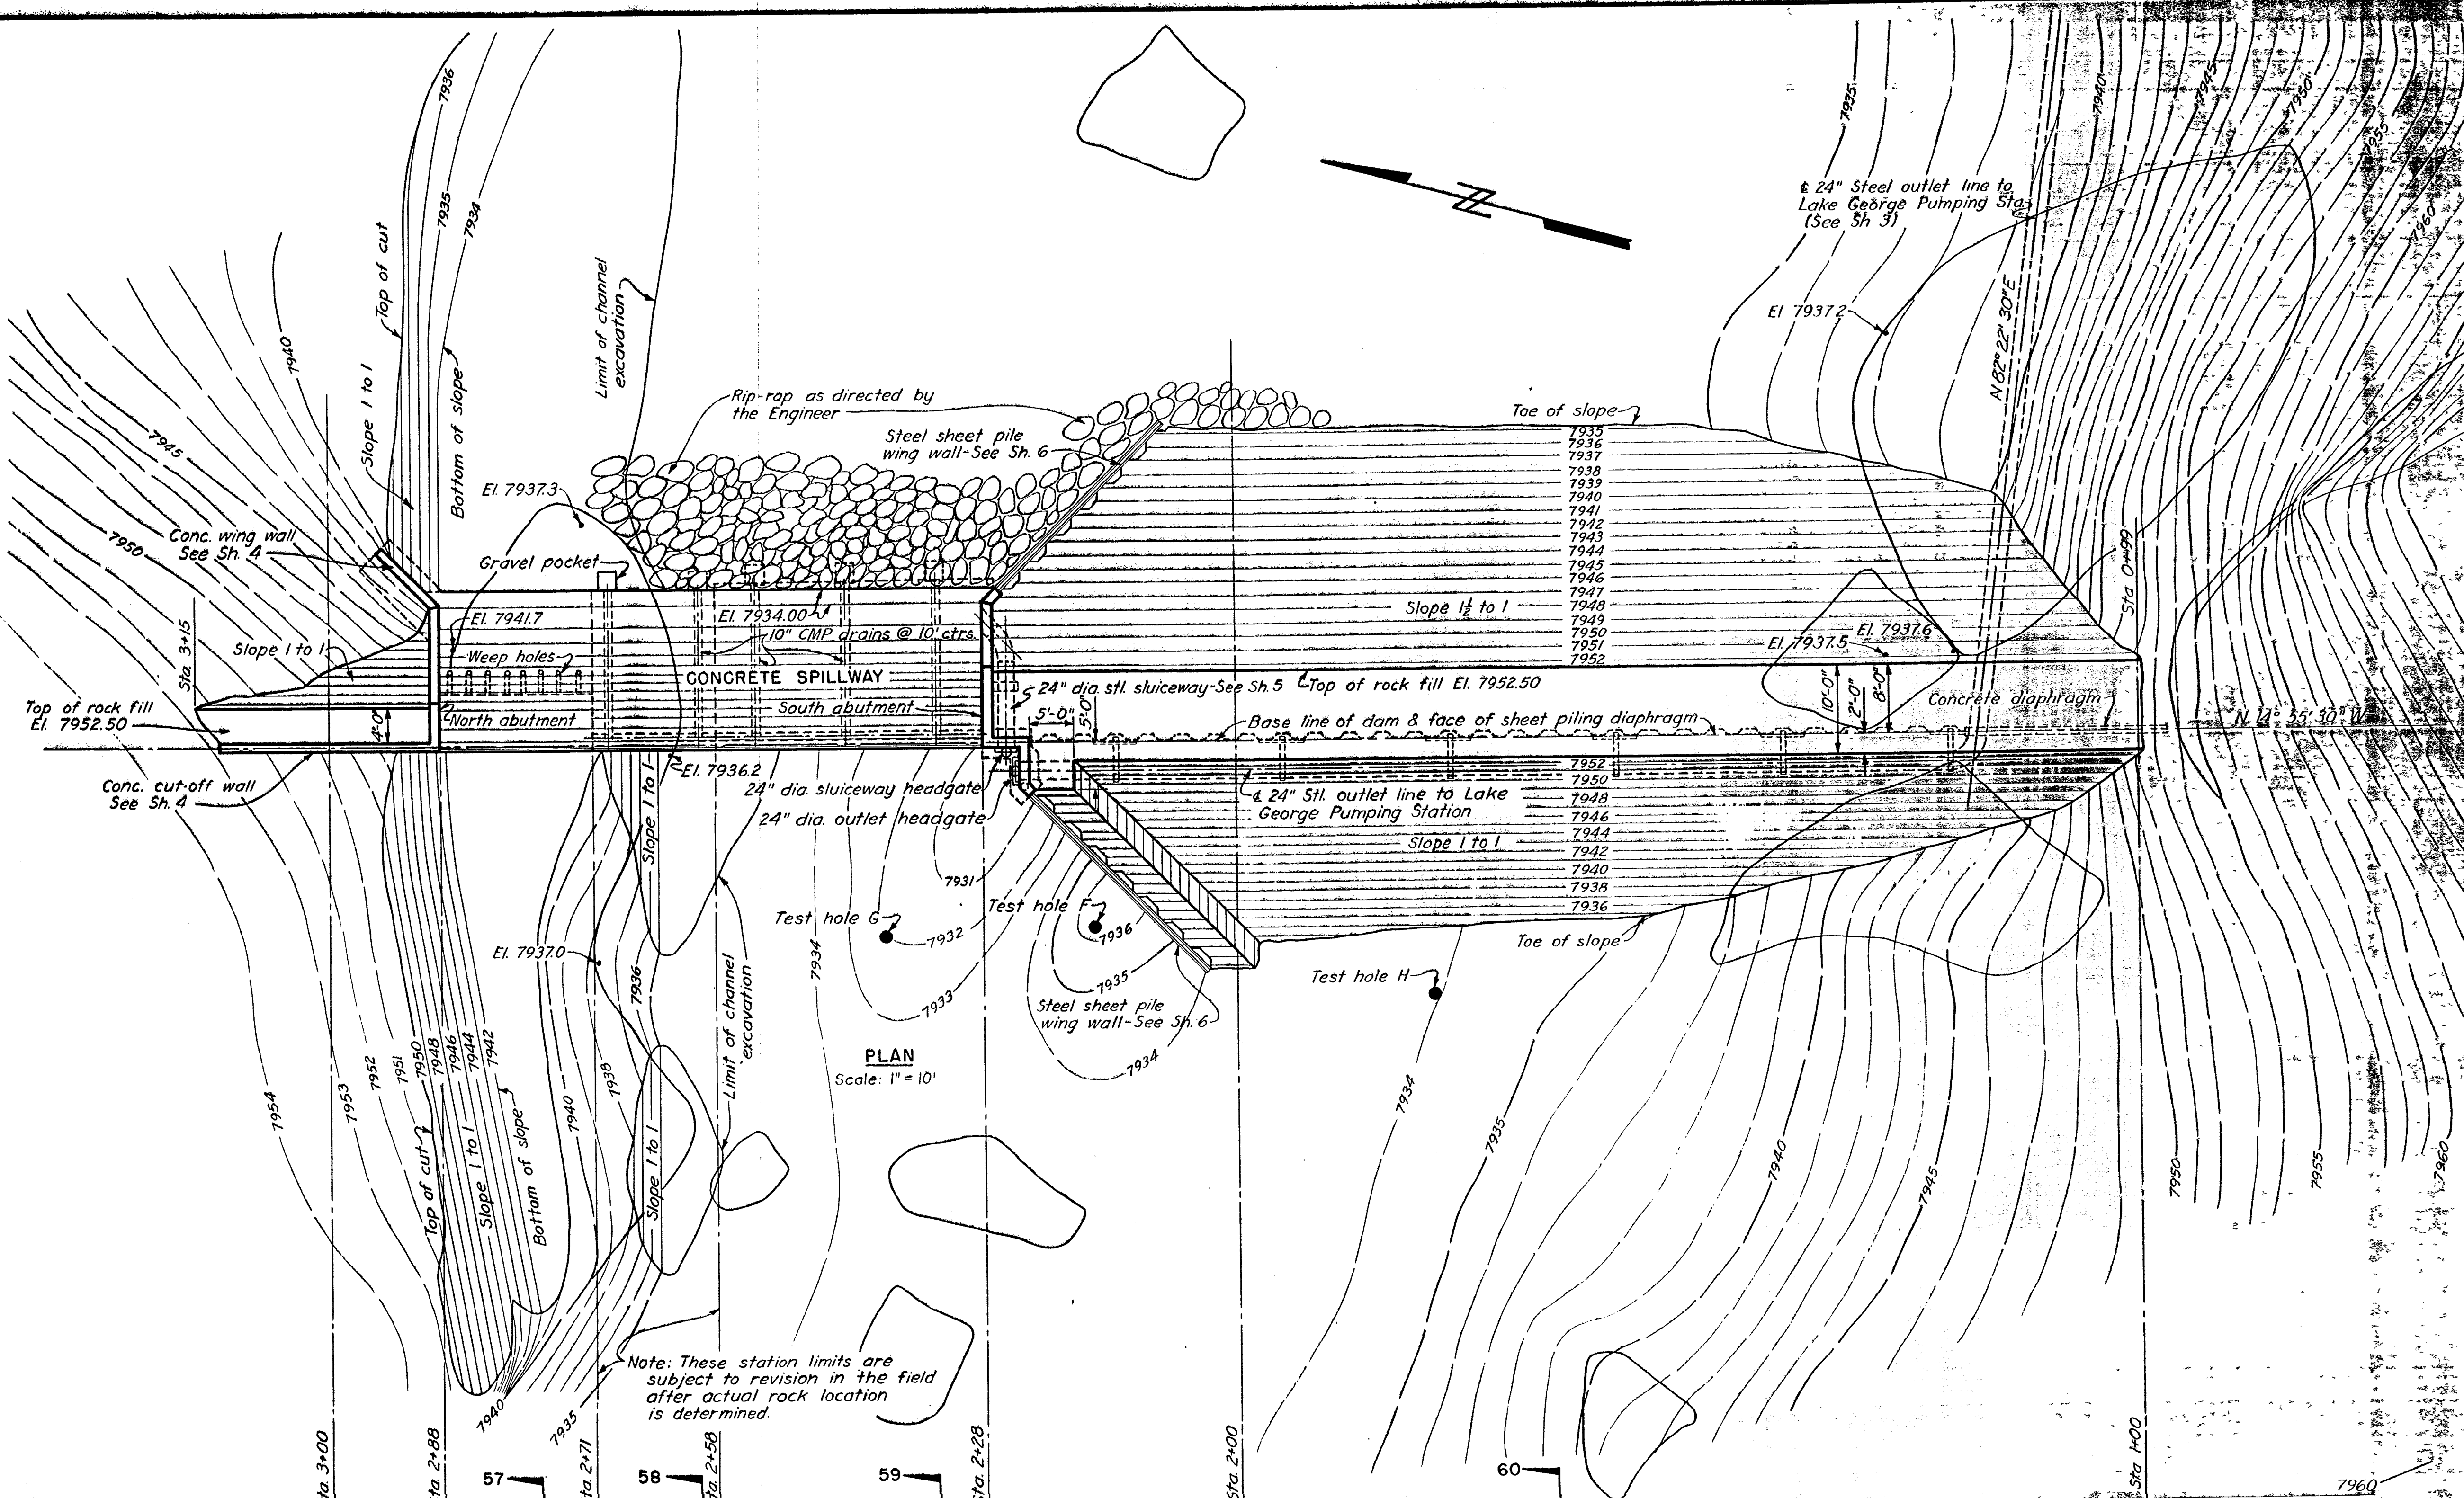

PLAN
Scale: 1" = 10'

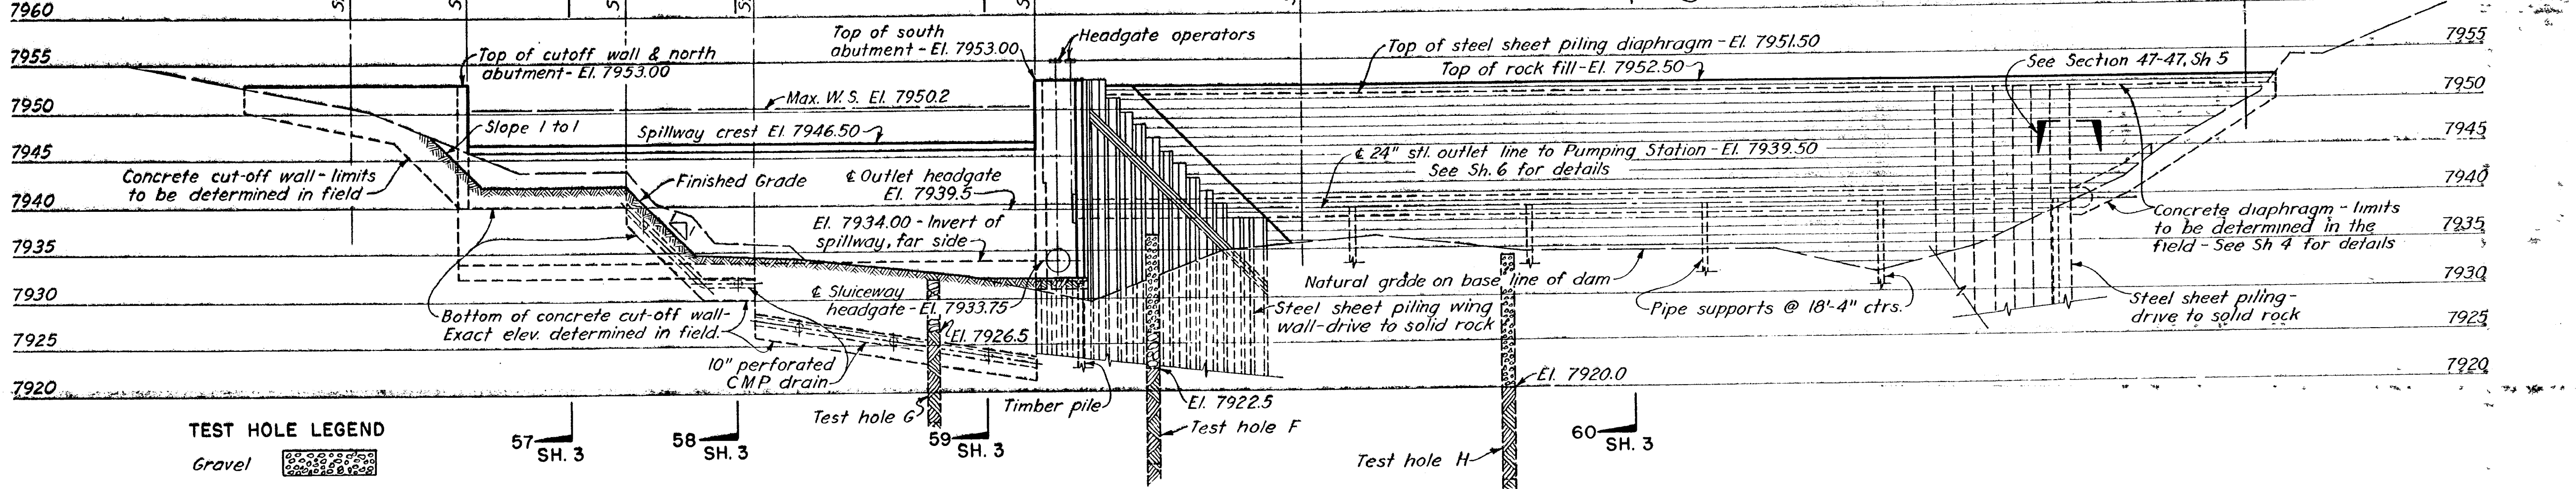

WEST ELEVATION
Scale: 1" = 10'

TEST HOLE LEGEND

Gravel	
Boulders	
Granite	

Note: Shaded areas indicate boulders or rock outcrop.
Broken lines indicate natural contours.
Solid lines indicate finished grades.

CAPACITY OF SPILLWAY

DEPTH IN FEET	CUBIC FEET PER SECOND
10	240
20	679
30	1,247
40	1,700

I HEREBY CERTIFY THAT THESE PLANS FOR THE CONSTRUCTION OF THE LAKE GEORGE DIVERSION DAM WERE PREPARED UNDER MY DIRECT SUPERVISION FOR THE OWNERS' INTEREST THEREOF.

M. T. Veatch
(REGISTERED ENGINEER)

SUBSCRIBED AND SWORN TO BEFORE ME THIS 2 DAY OF JULY, 1932.

Samuel
(NOTARY PUBLIC)

MY COMMISSION EXPIRES ON THE 12 DAY OF JANUARY, 1935.

THESE PLANS FOR THE CONSTRUCTION OF THE LAKE GEORGE DIVERSION DAM ARE HEREBY APPROVED AND ACCEPTED BY THE CITY OF COLORADO SPRINGS, COLORADO (OWNER).

Harry Rhoad
MAYOR

APPROVED ON THE 30 DAY OF JULY, 1932.

M. B. Anderson
STATE ENGINEER

FILE NO.

LAKE GEORGE DIVERSION DAM
IRRIGATION DIVISION NO. 15 - WATER DISTRICT NO. 23
PARK COUNTY

COLORADO SPRINGS, COLORADO
WATER SUPPLY DEVELOPMENT


PLAN 8 ELEVATION

BLACK & VEATCH
CONSULTING ENGINEERS, KANSAS CITY, MO.




DESIGNED: DDP
CHECKED: J.M.M.
DATE: 1-2-32

TRACED: RHP
APPROVED: J.M.M.
DATE: 1-2-32

C-617

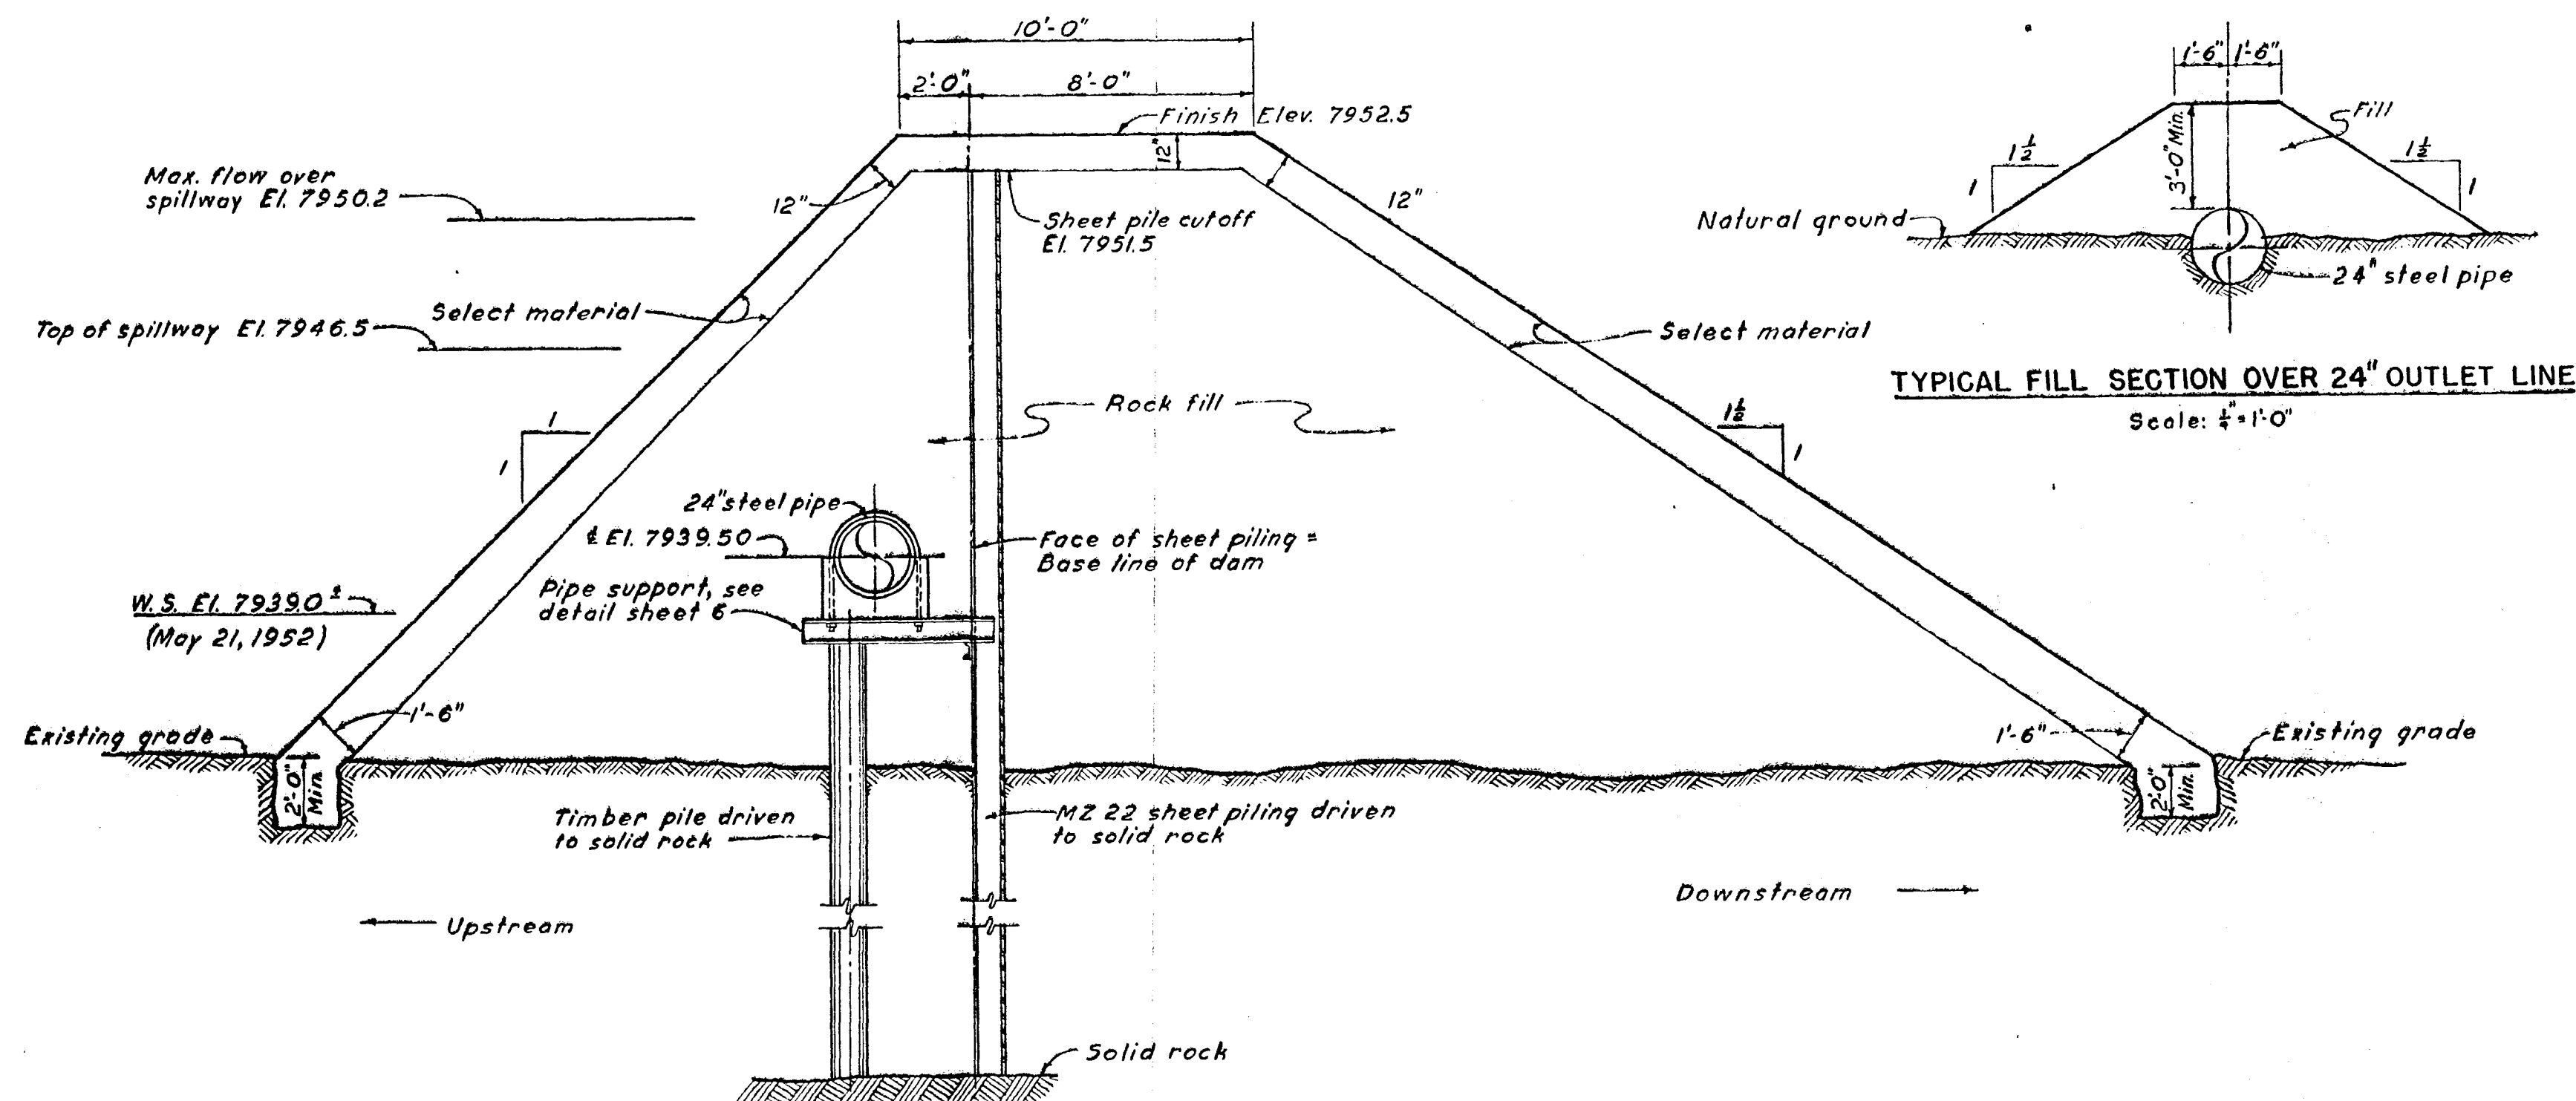


TYPICAL FILL SECTION OVER 24" OUTLET LINE
Scale: 1/2" = 1'-0"

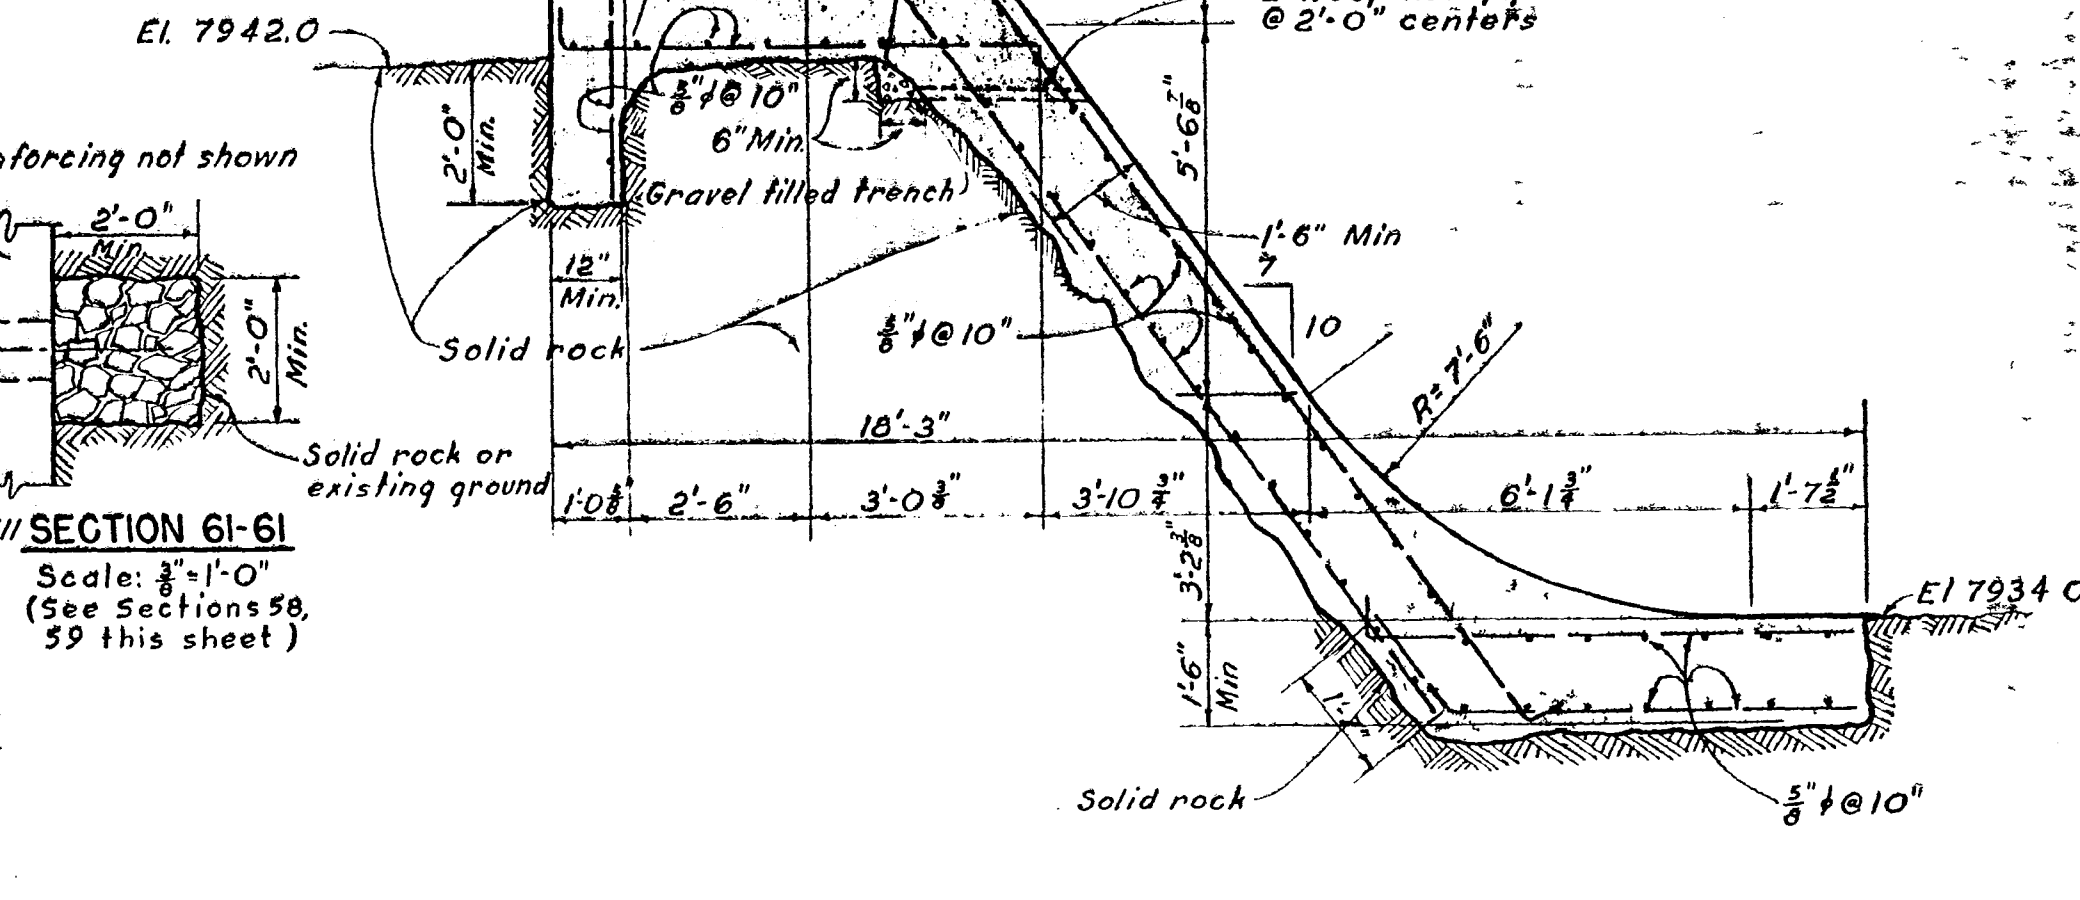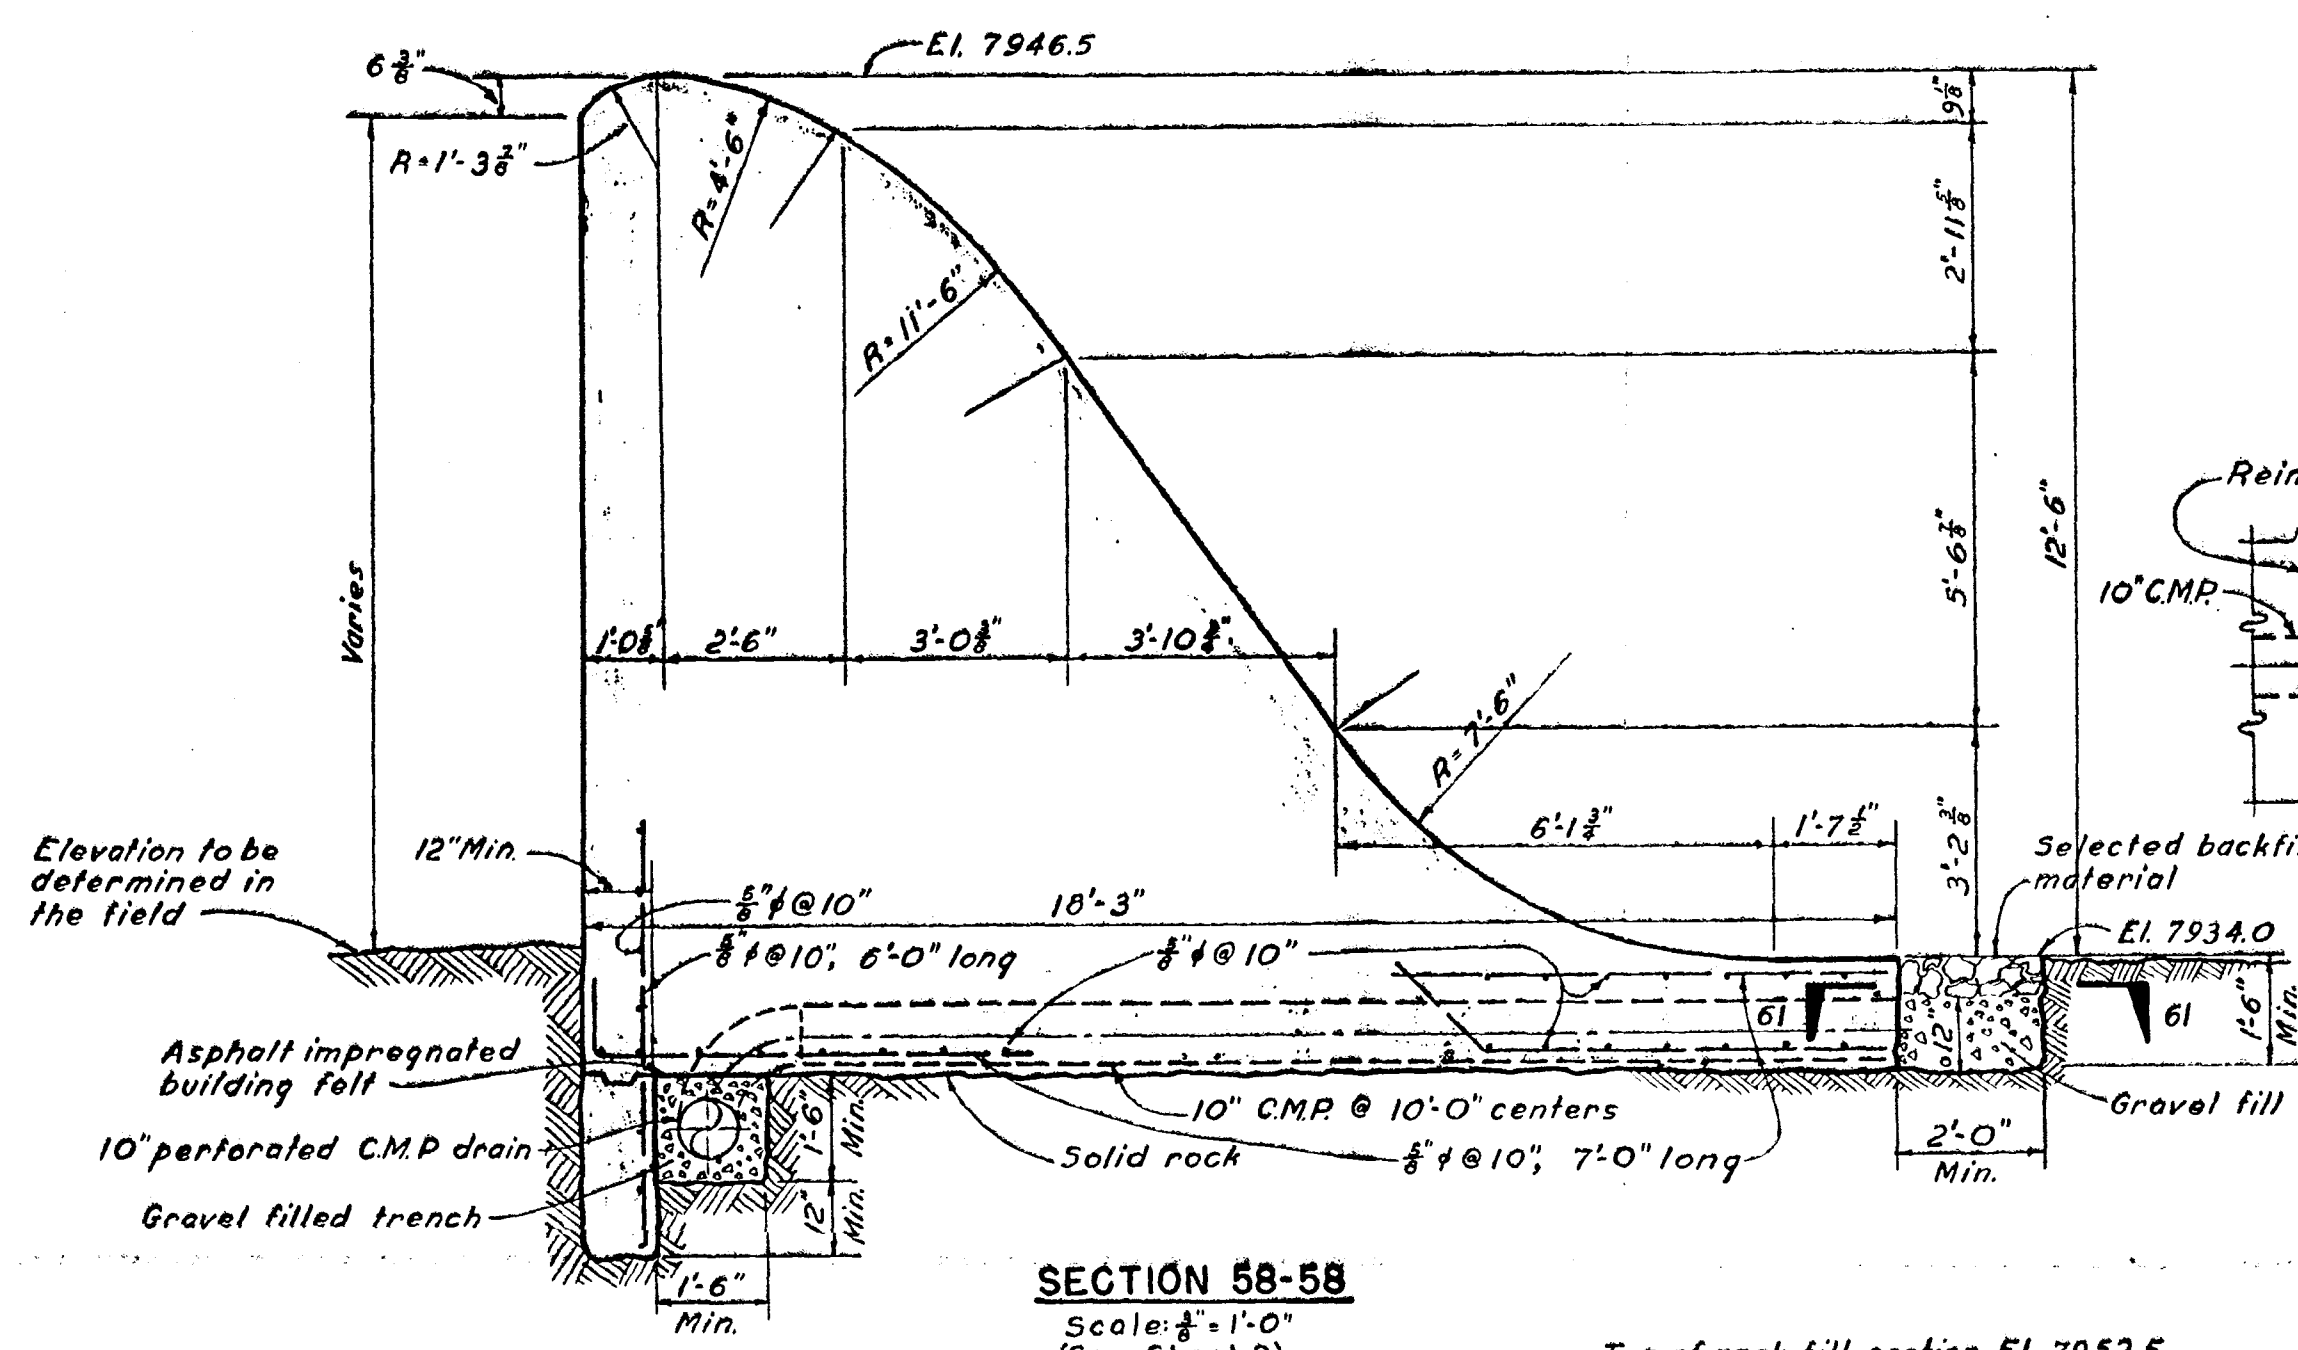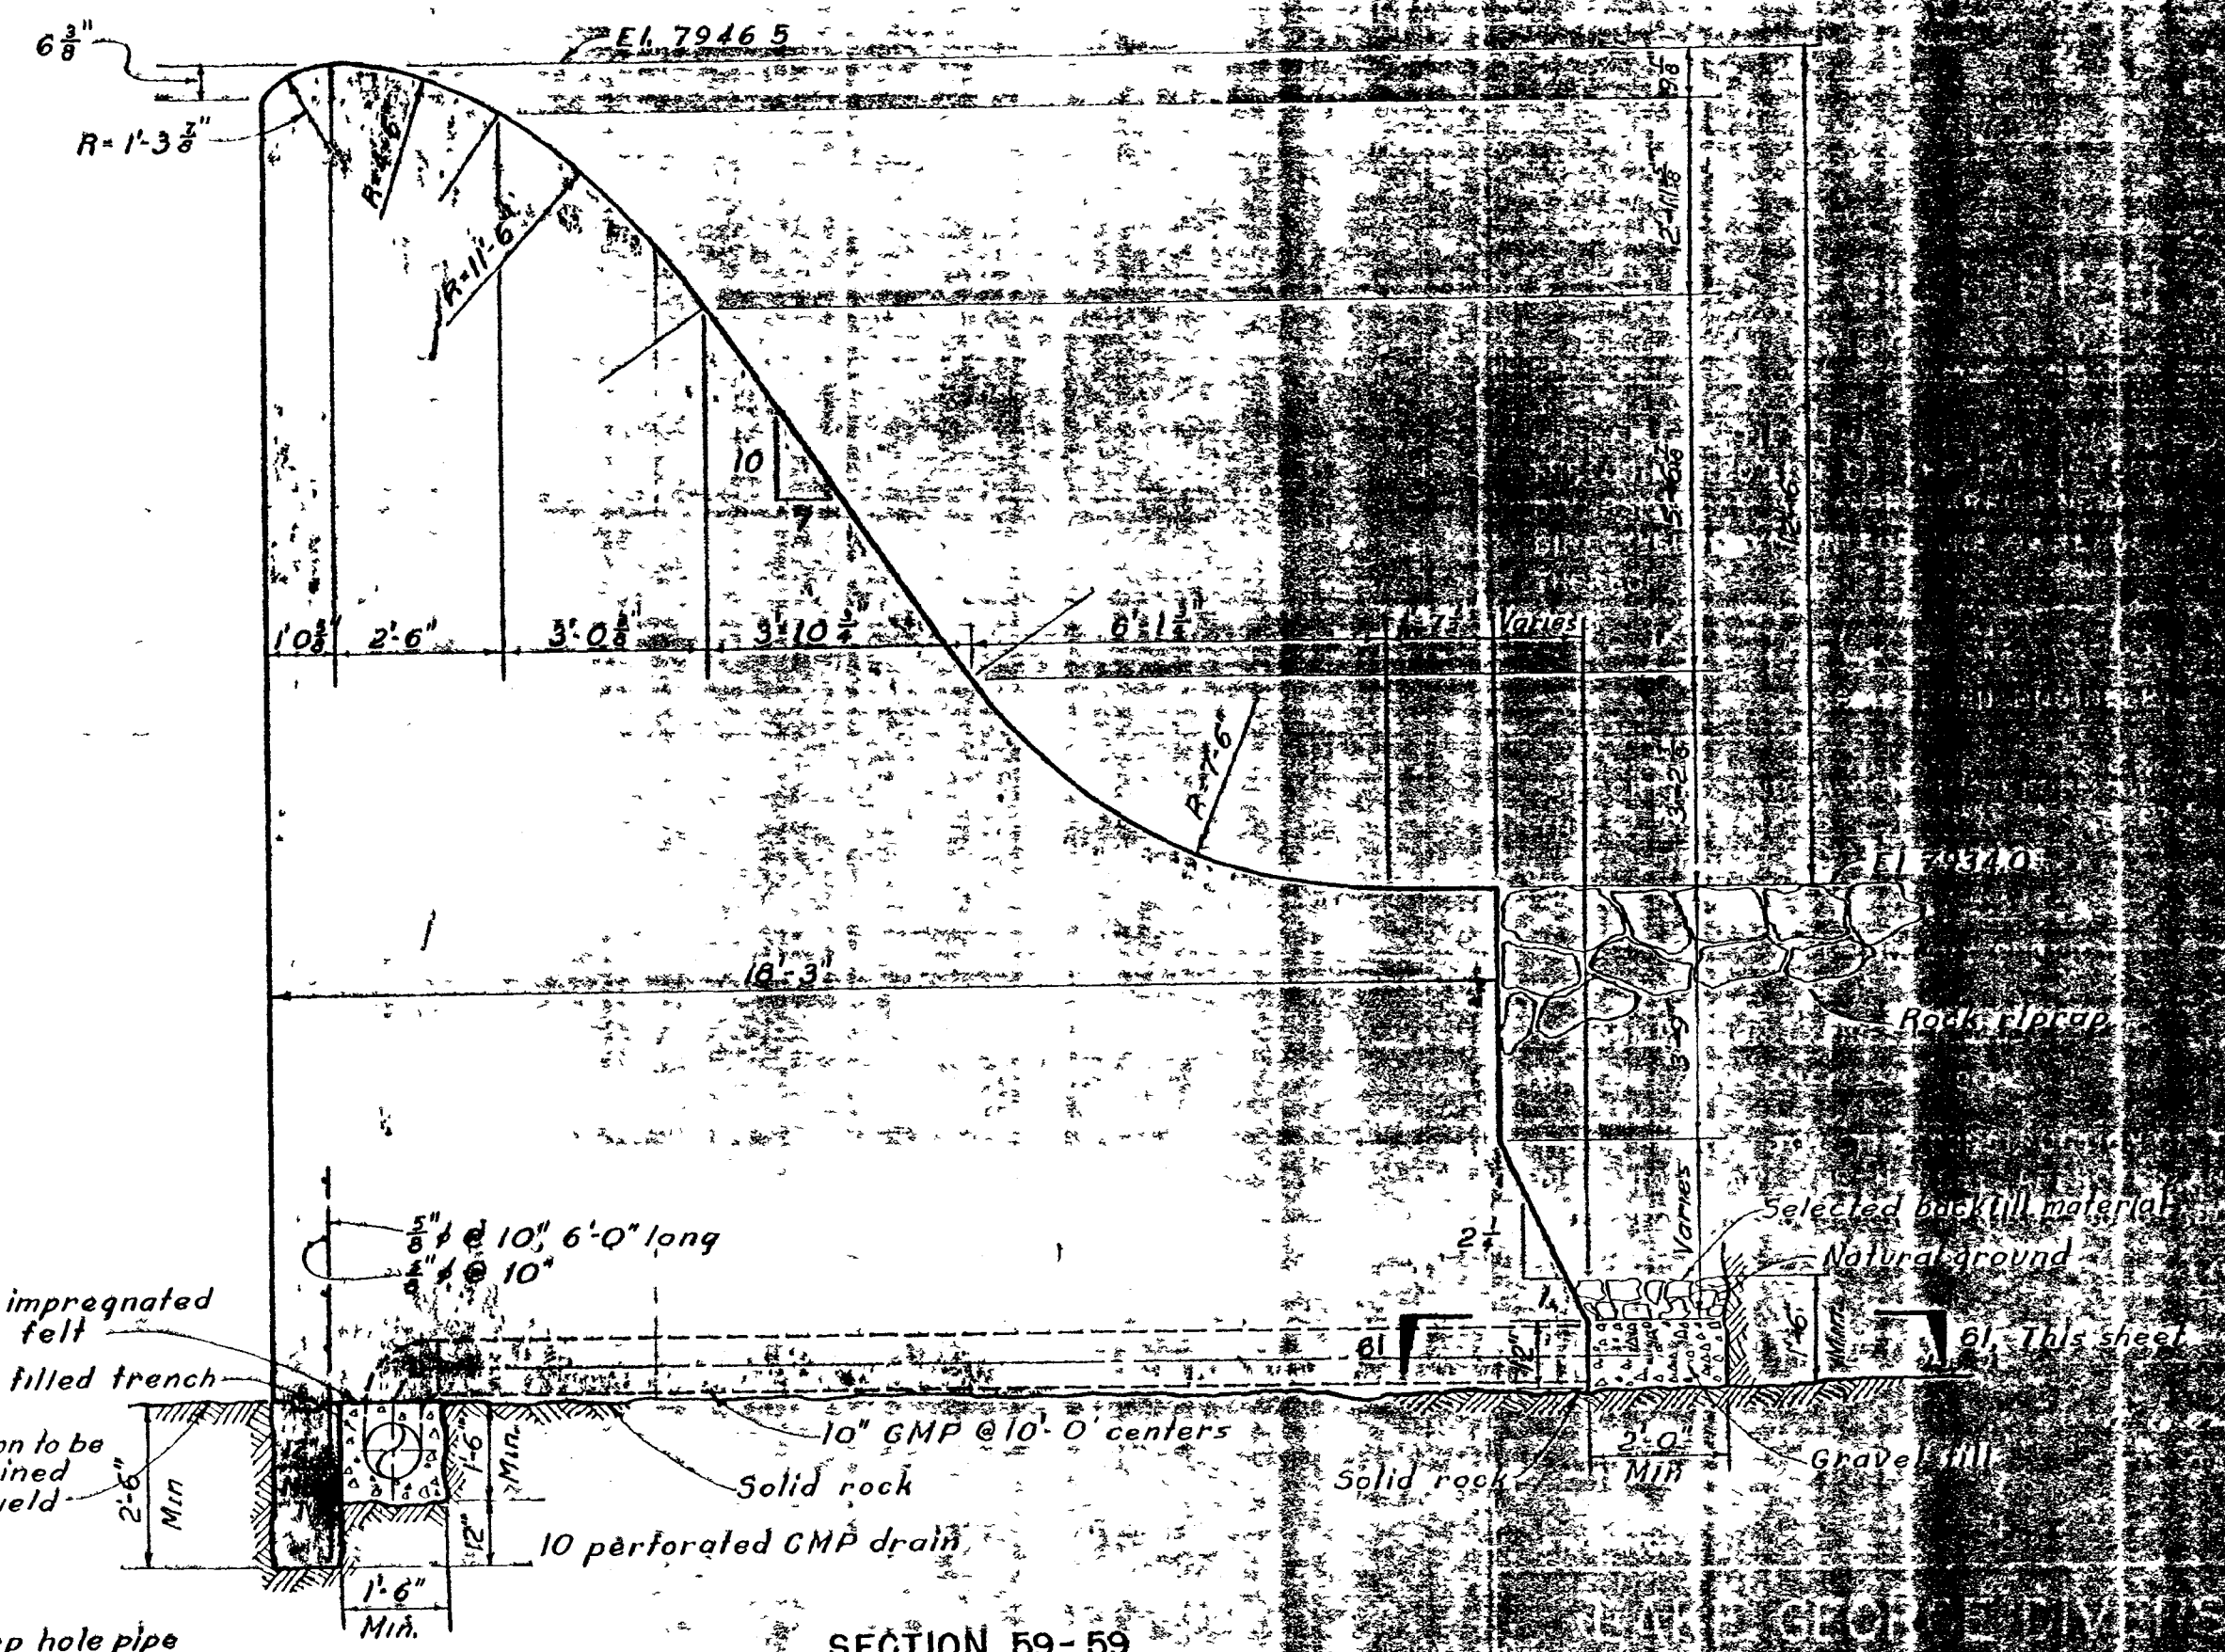

SECTION 57-57
Scale: 1/2" = 1'-0"
(See Sheet 2)

SECTION 58-58
Scale: 1/2" = 1'-0"
(See Sheet 2)

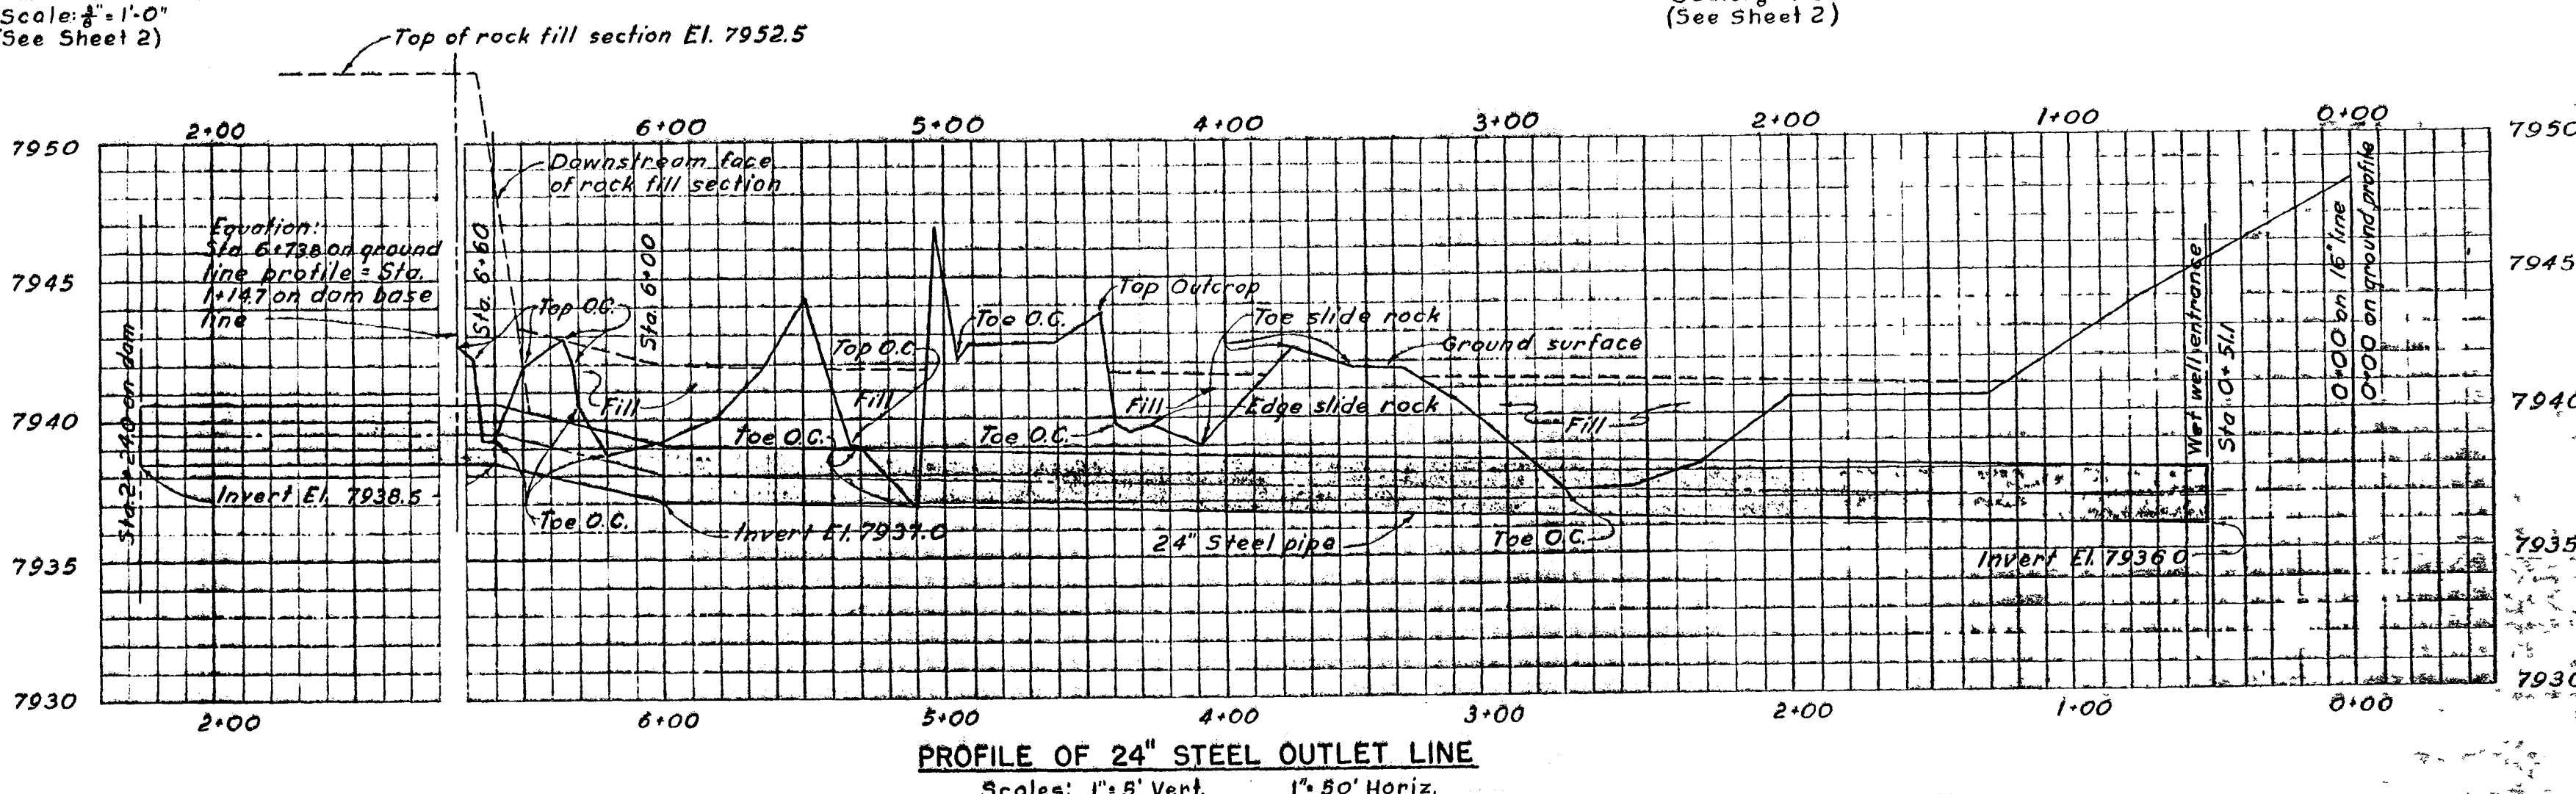

THESE PLANS FOR THE CONSTRUCTION OF THE LAKE GEORGE DIVERSION DAM WERE PREPARED UNDER MY DIRECT SUPERVISION FOR THE OWNERS THEREOF.

N. P. U. S. A.
(REGISTERED ENGINEER)

SUBSCRIBED AND SWORN TO BEFORE ME THIS 21 DAY OF JULY 1952.

W. L. W. L.
(NOTARY PUBLIC)

MY COMMISSION EXPIRES ON THE 12 DAY OF JULY 1954.

THESE PLANS FOR THE CONSTRUCTION OF THE LAKE GEORGE DIVERSION DAM ARE HEREBY APPROVED AND ACCEPTED BY THE CITY OF COLORADO SPRINGS, COLORADO (OWNER).

W. L. W. L.
MAYOR

APPROVED ON THE 30 DAY OF JULY 1952.

W. L. W. L.
STATE ENGINEER

FILE NO. _____ DEPUTY _____

LAKE GEORGE DIVERSION DAM
IRRIGATION DIVISION NO. 11 WATER DISTRICT NO. 23
PARK COUNTY



COLORADO SPRINGS, COLORADO
WATER SUPPLY DEVELOPMENT

TYPICAL DAM SECTIONS








BLACK & VEATCH
CONSULTING ENGINEERS, KANSAS CITY, MO.

DESIGNED BY: J. W. L. CHECKED BY: J. W. L. DRAWN BY: J. W. L. APPROVED BY: J. W. L. TRACED BY: J. W. L.

0-617

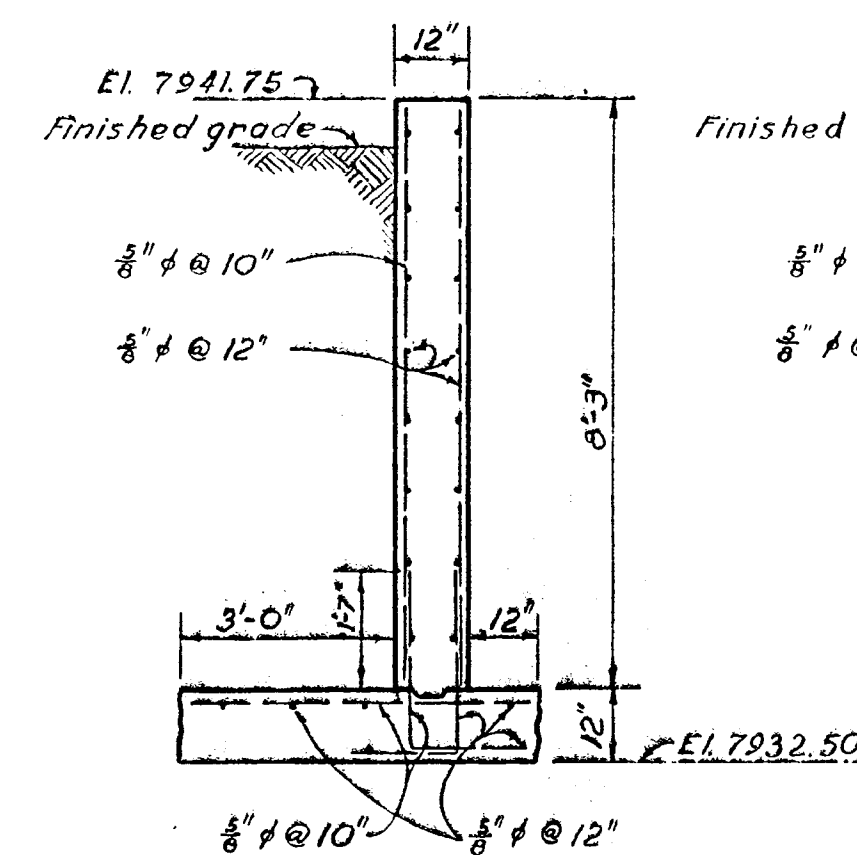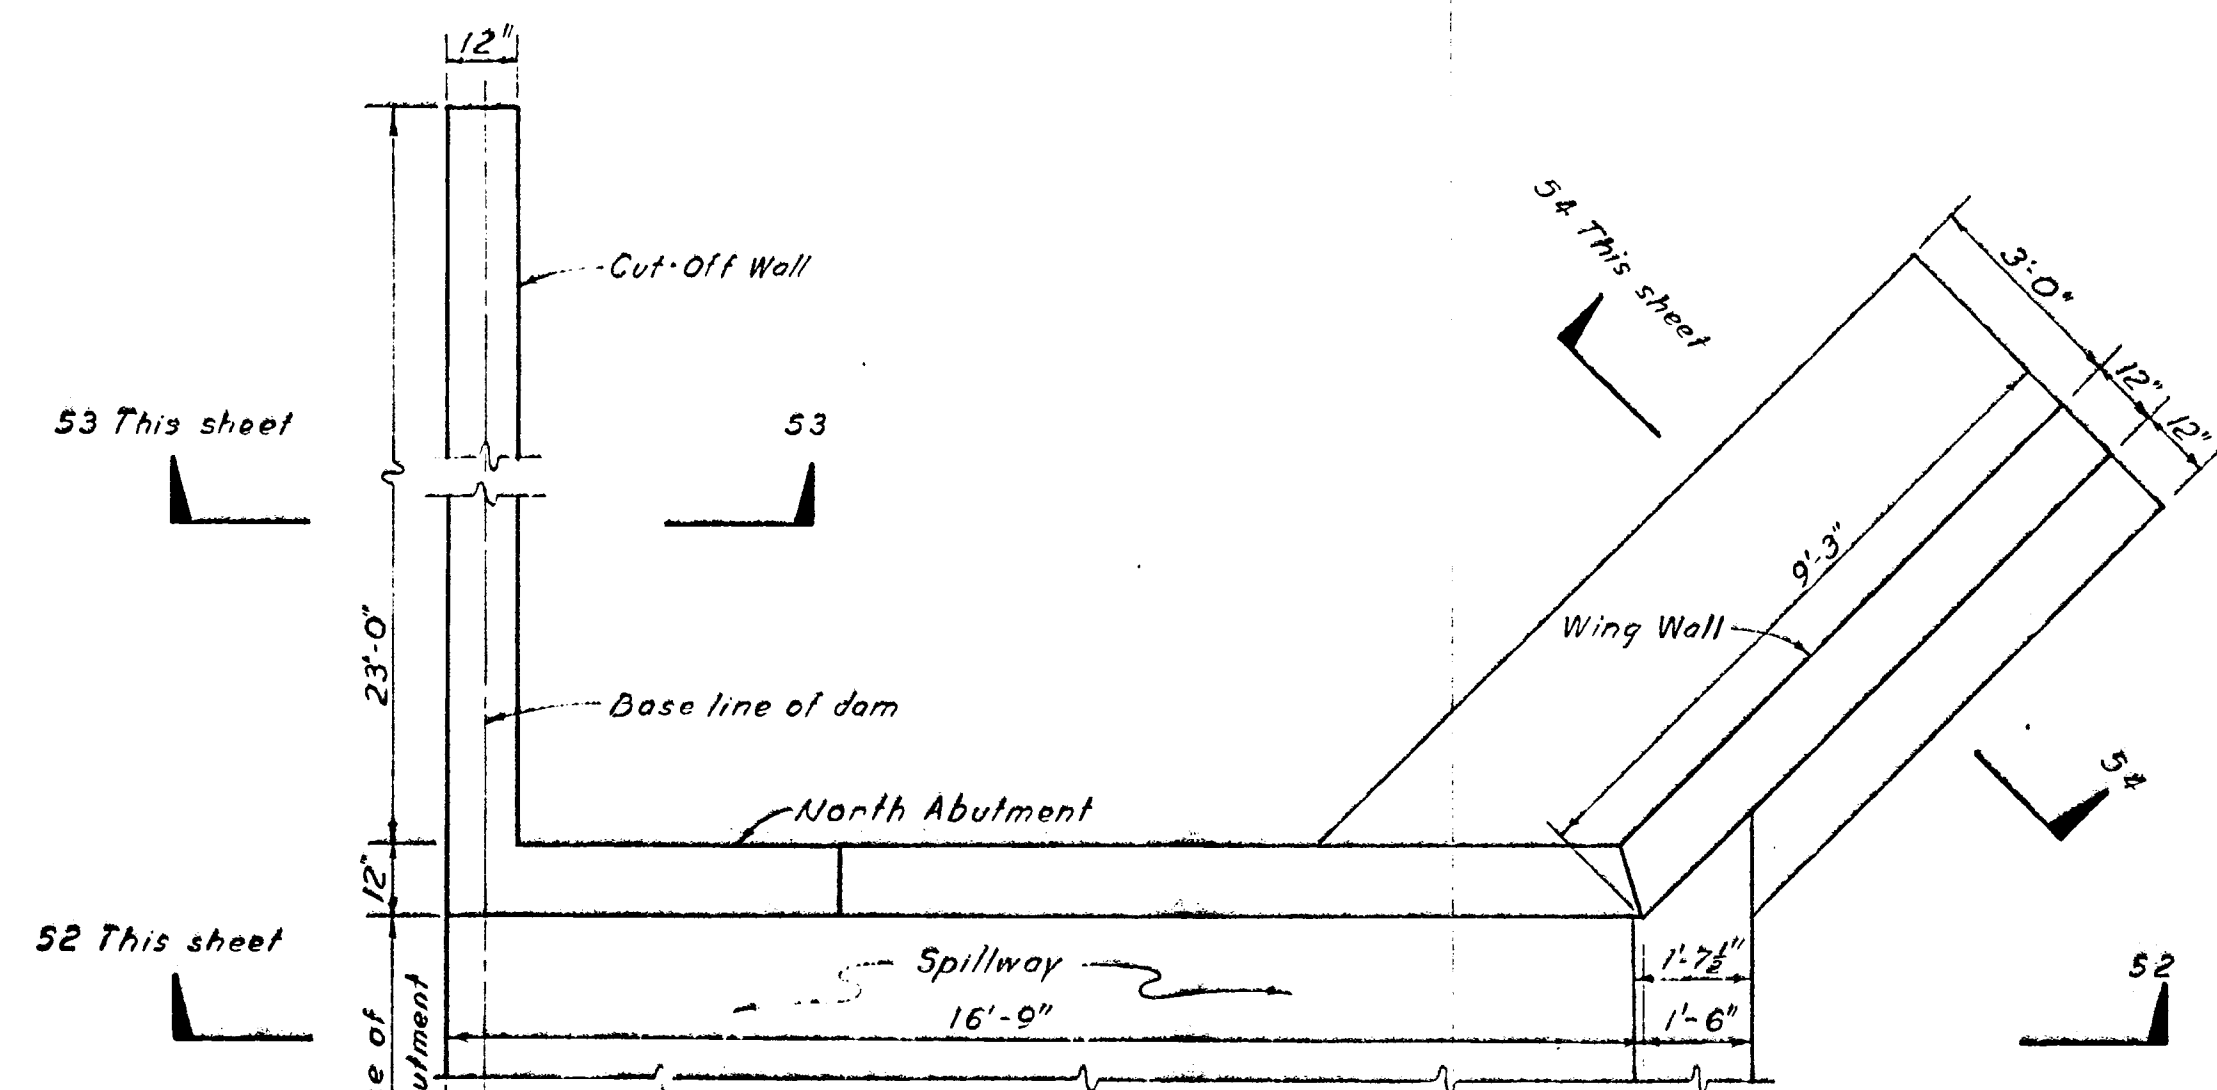

ALTERNATE WING WALL FOR ROCK
Scale $\frac{1}{8}$ " = 1'-0"

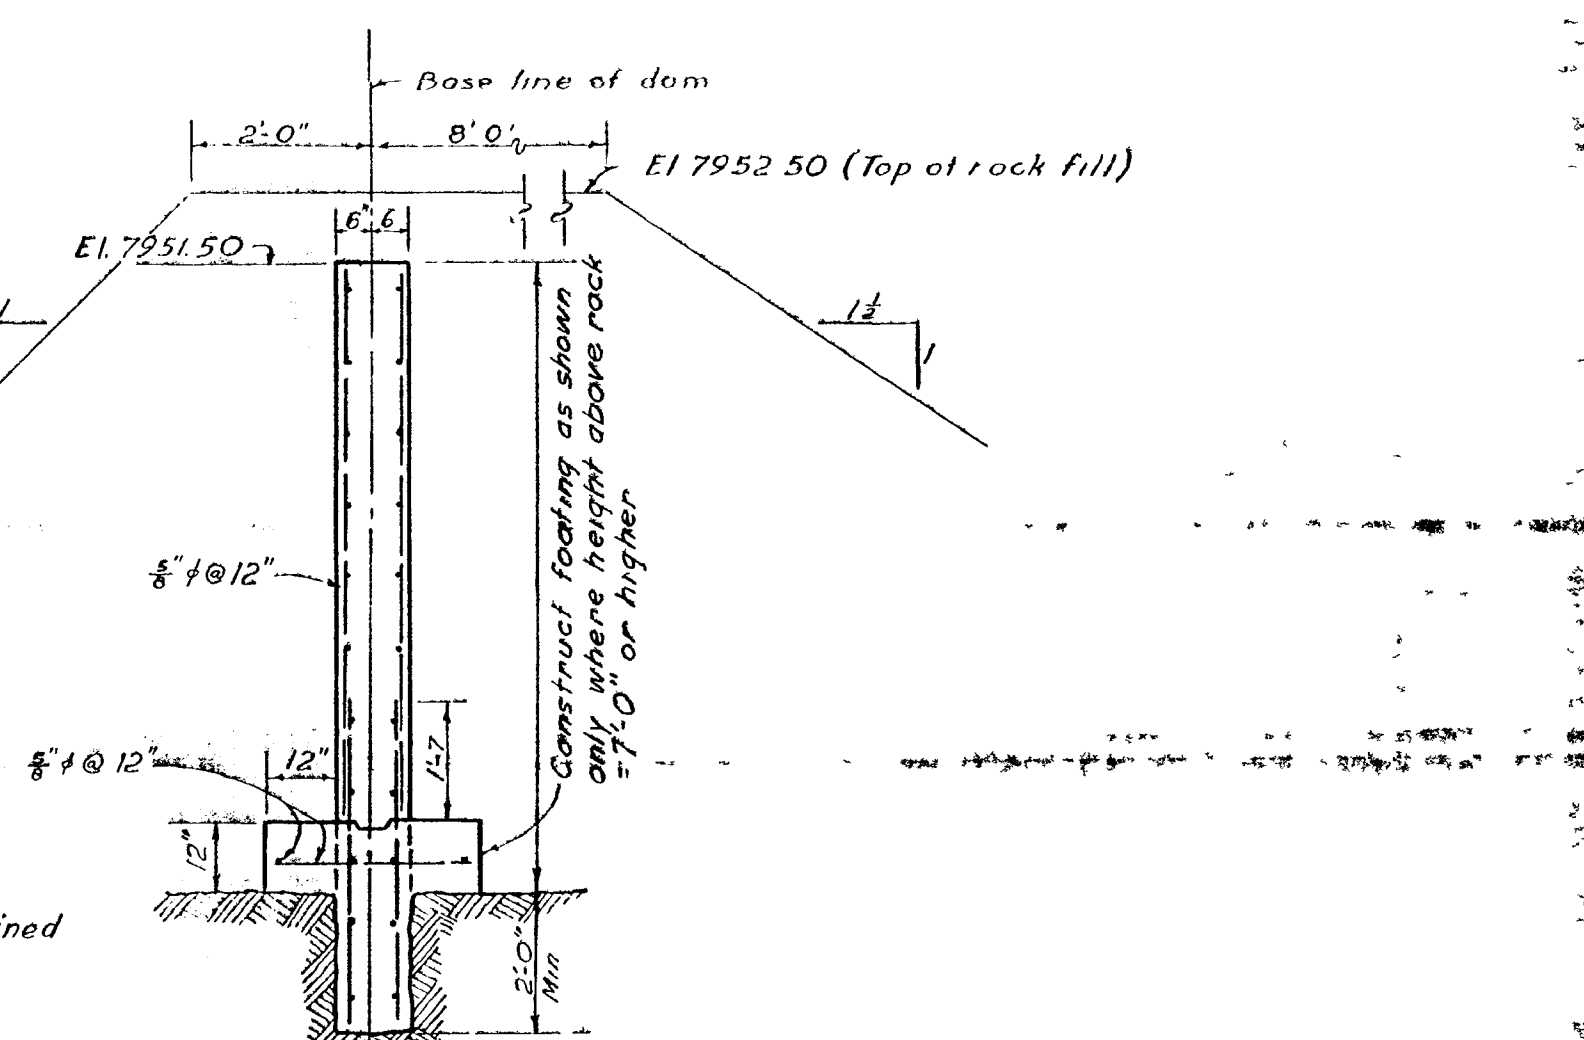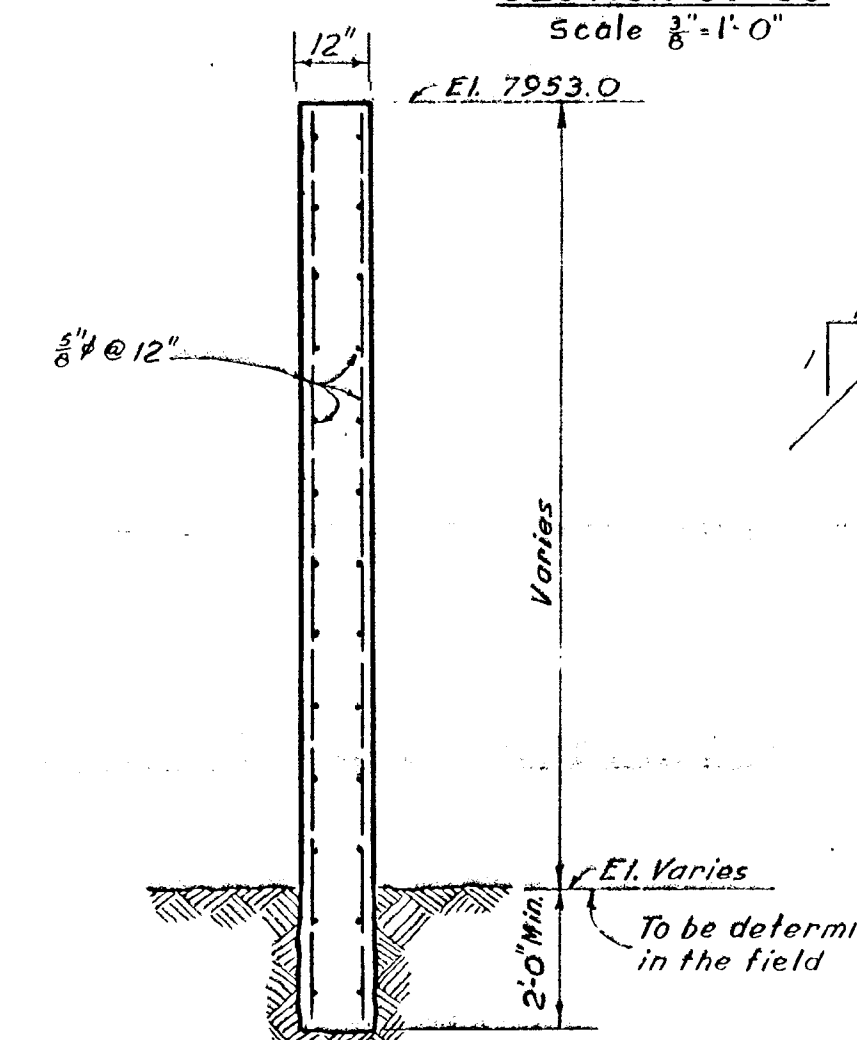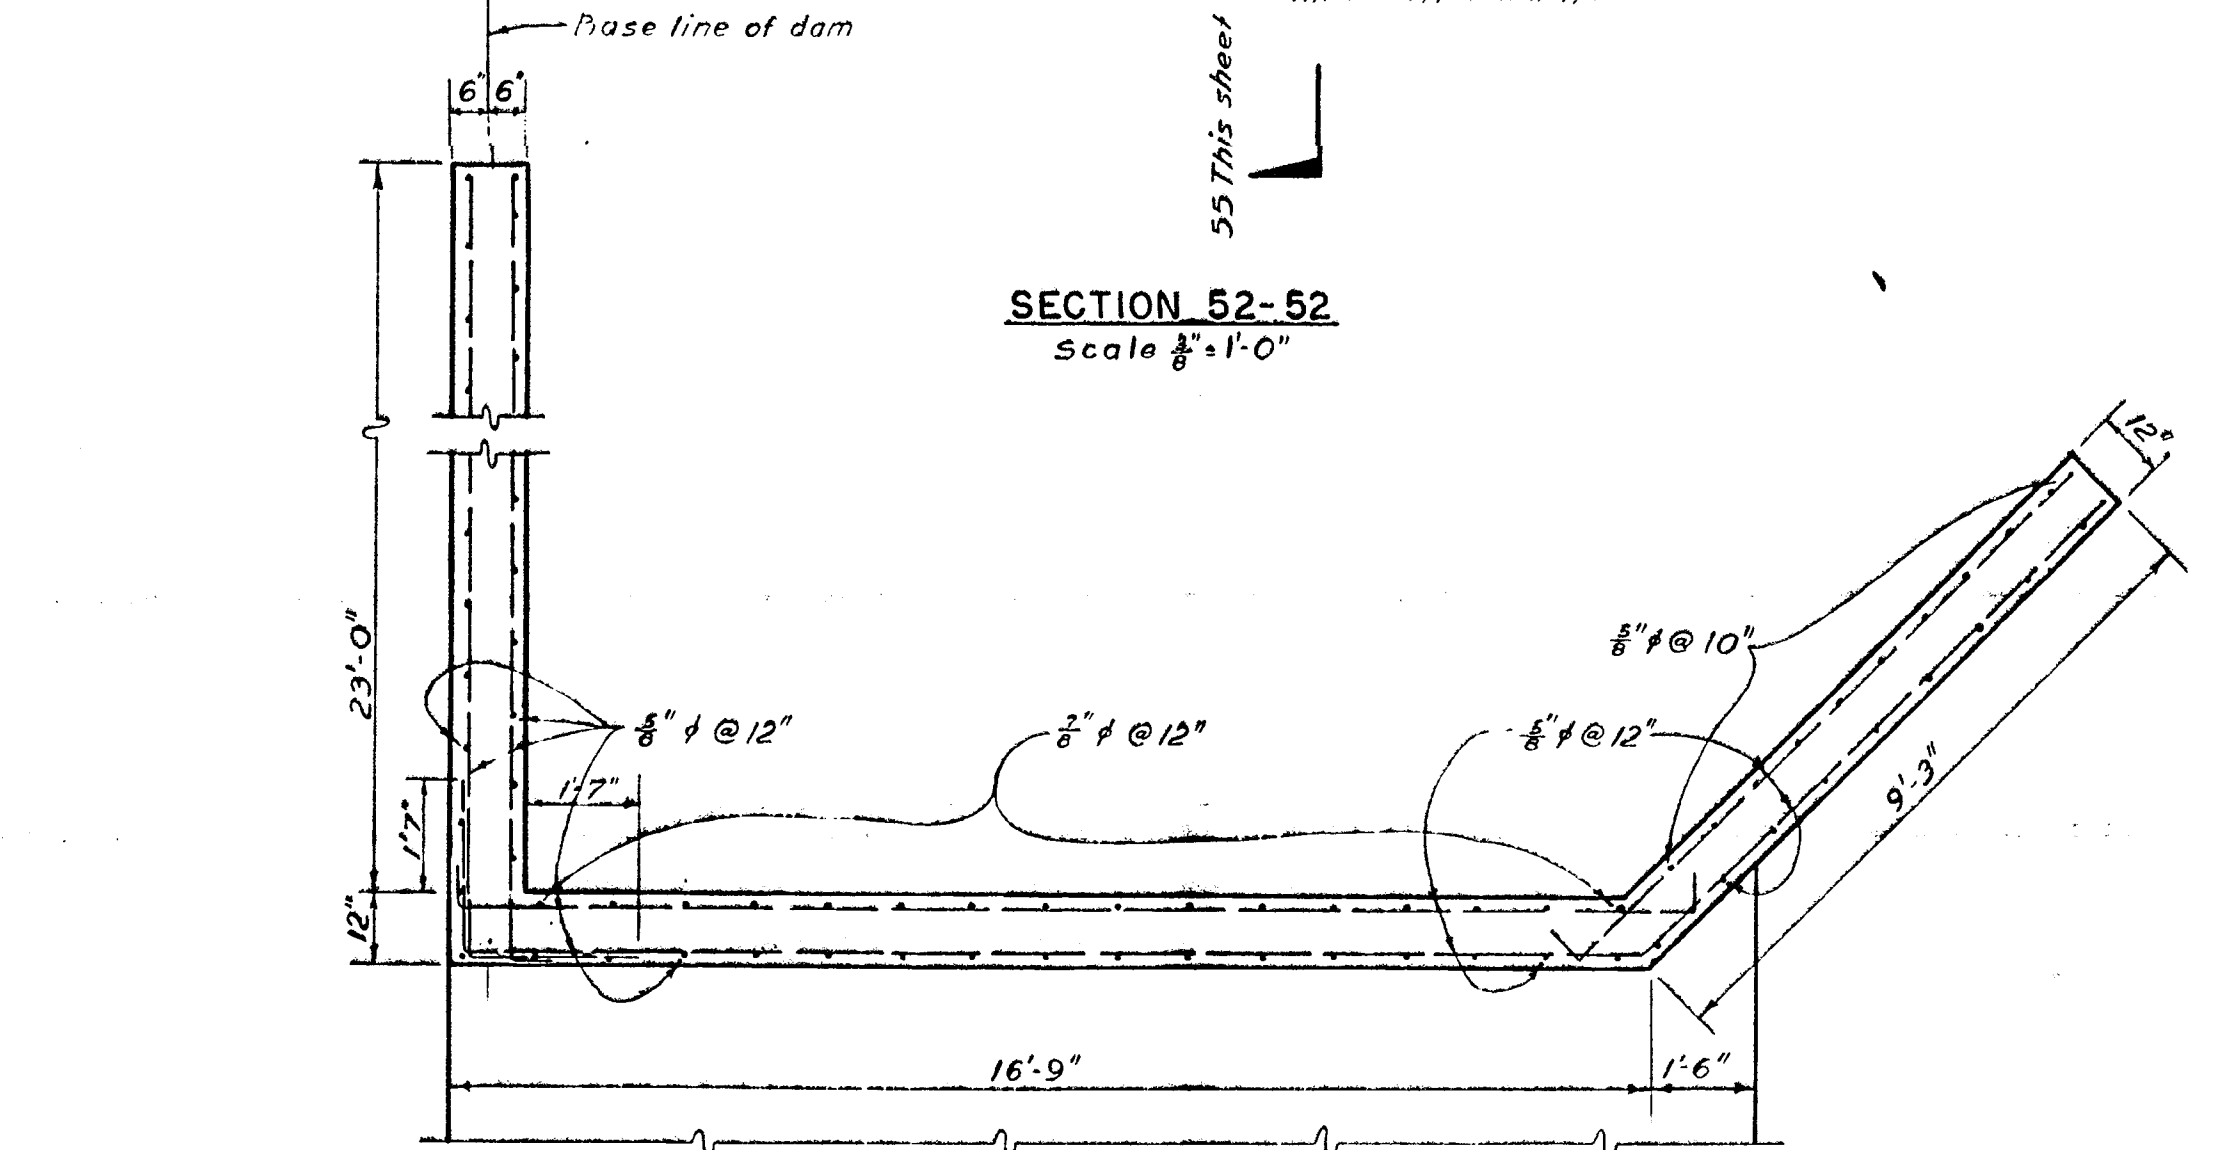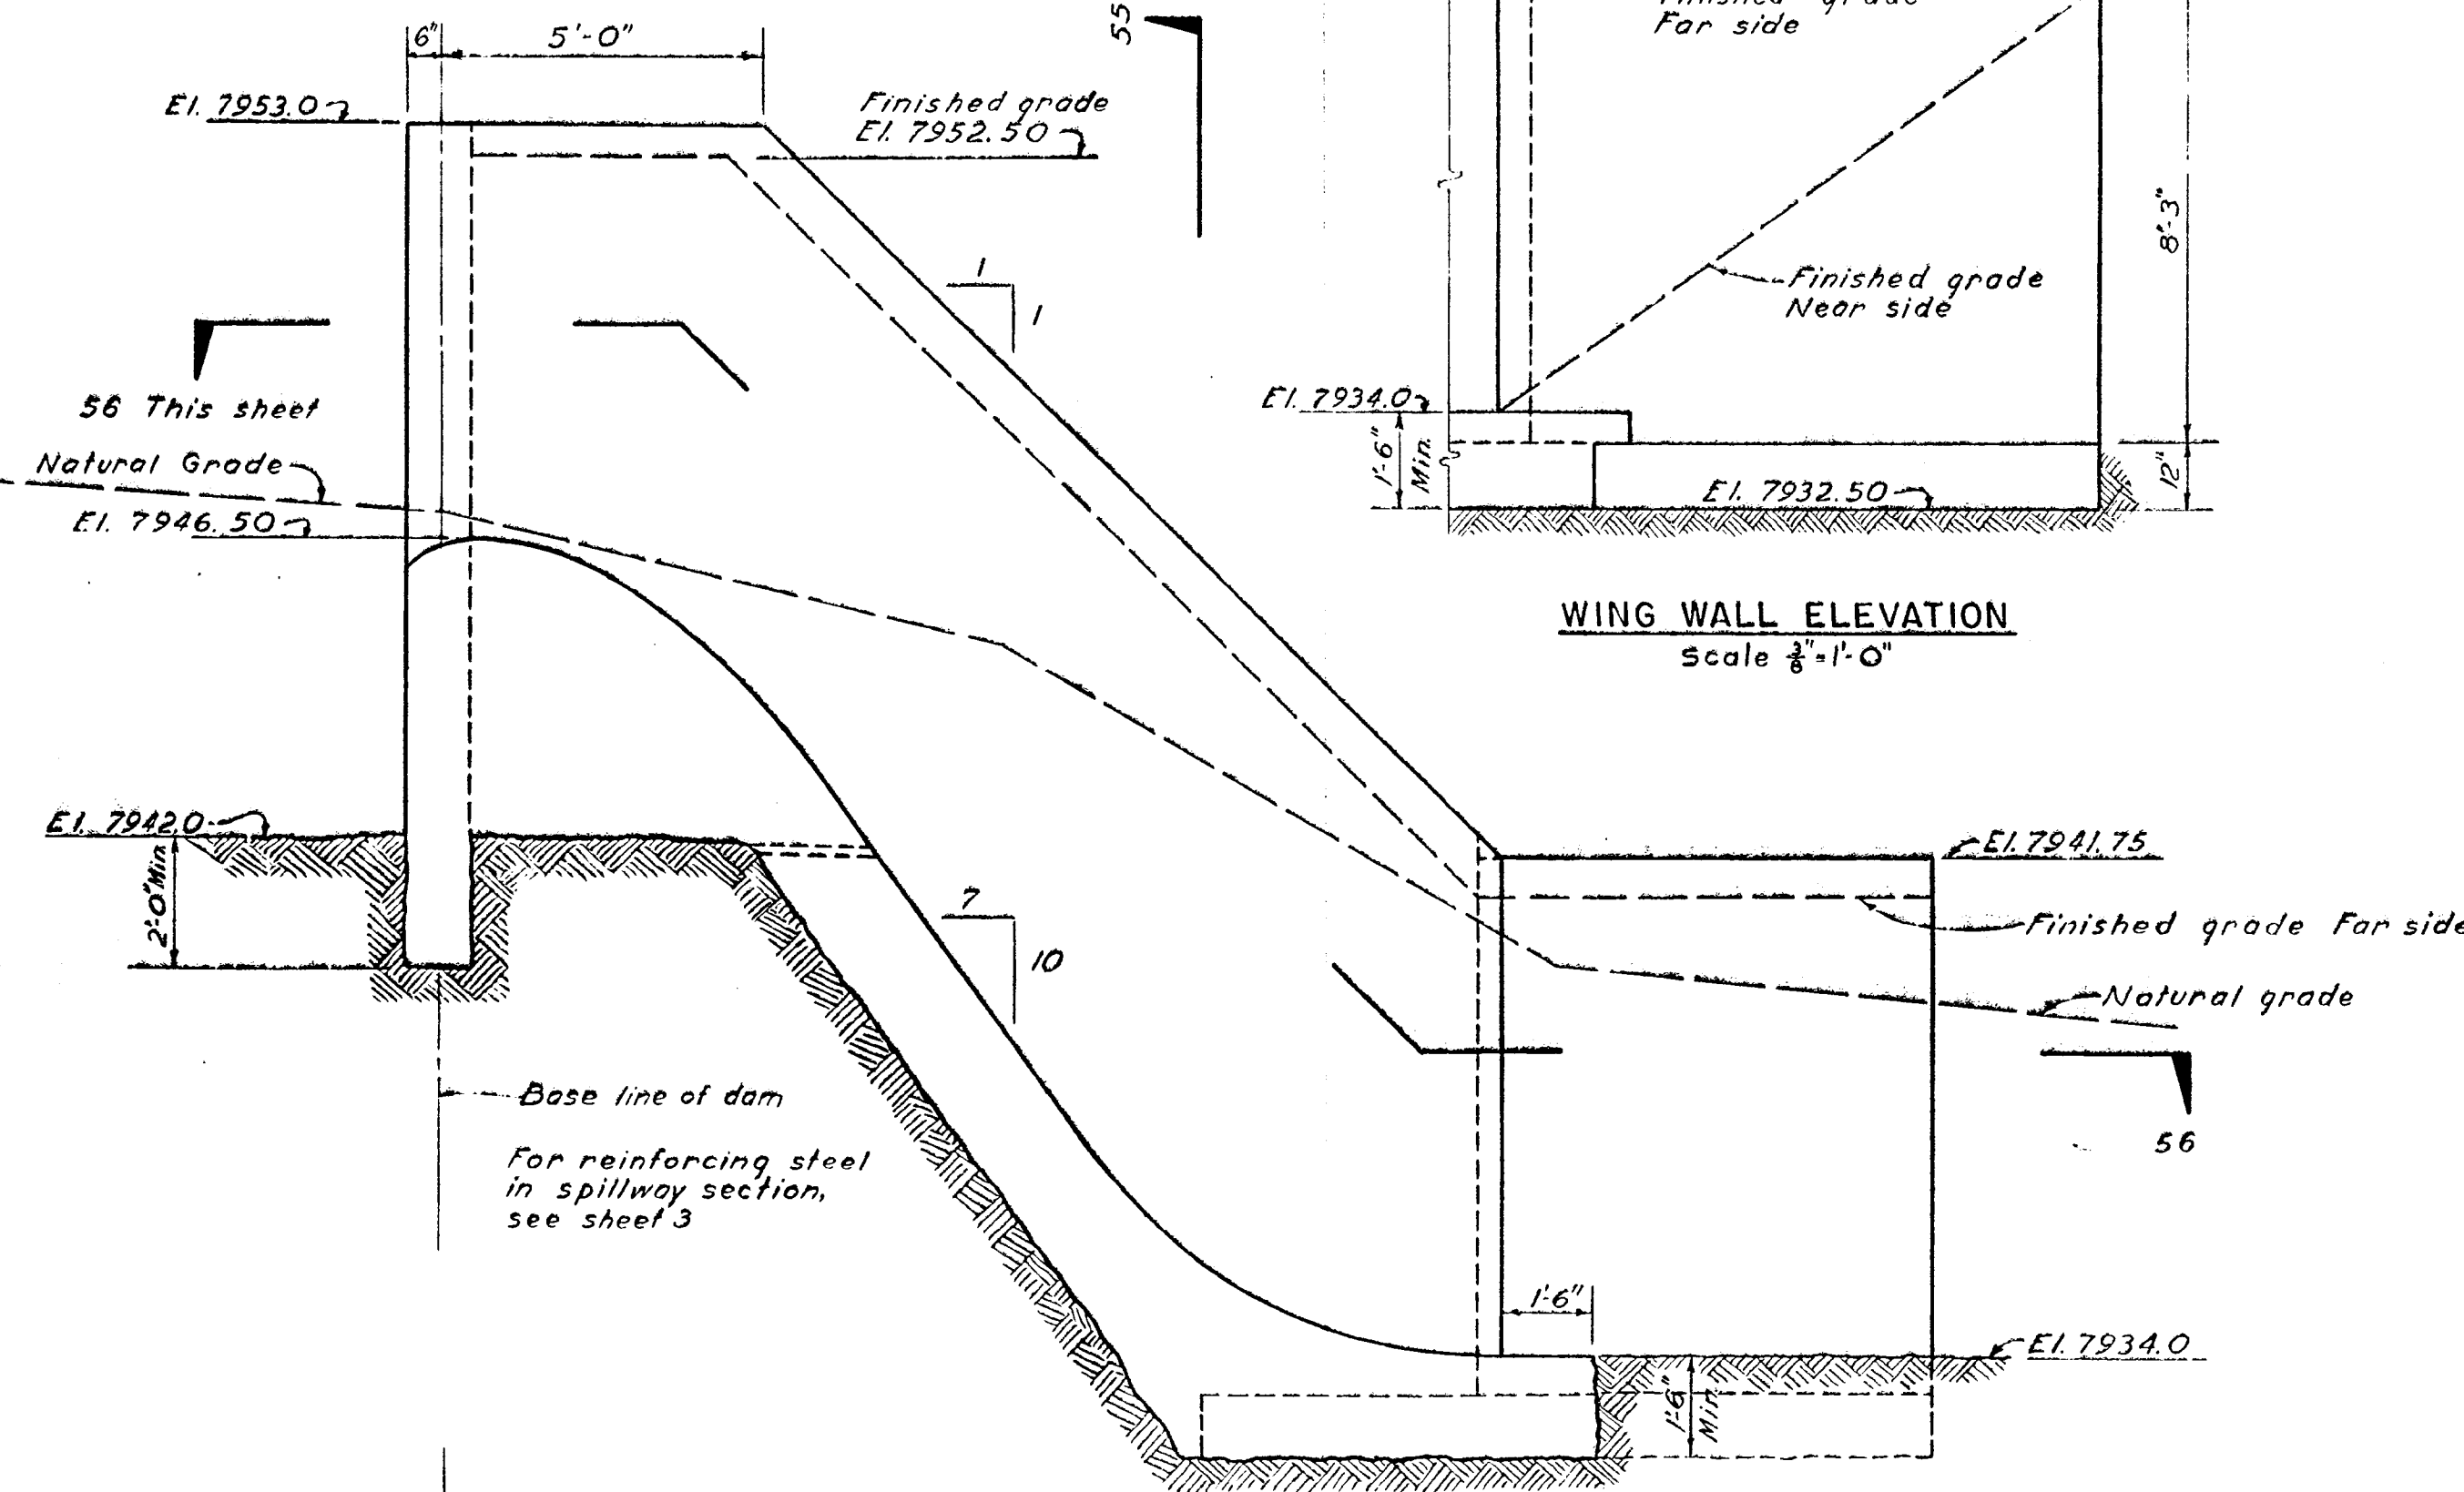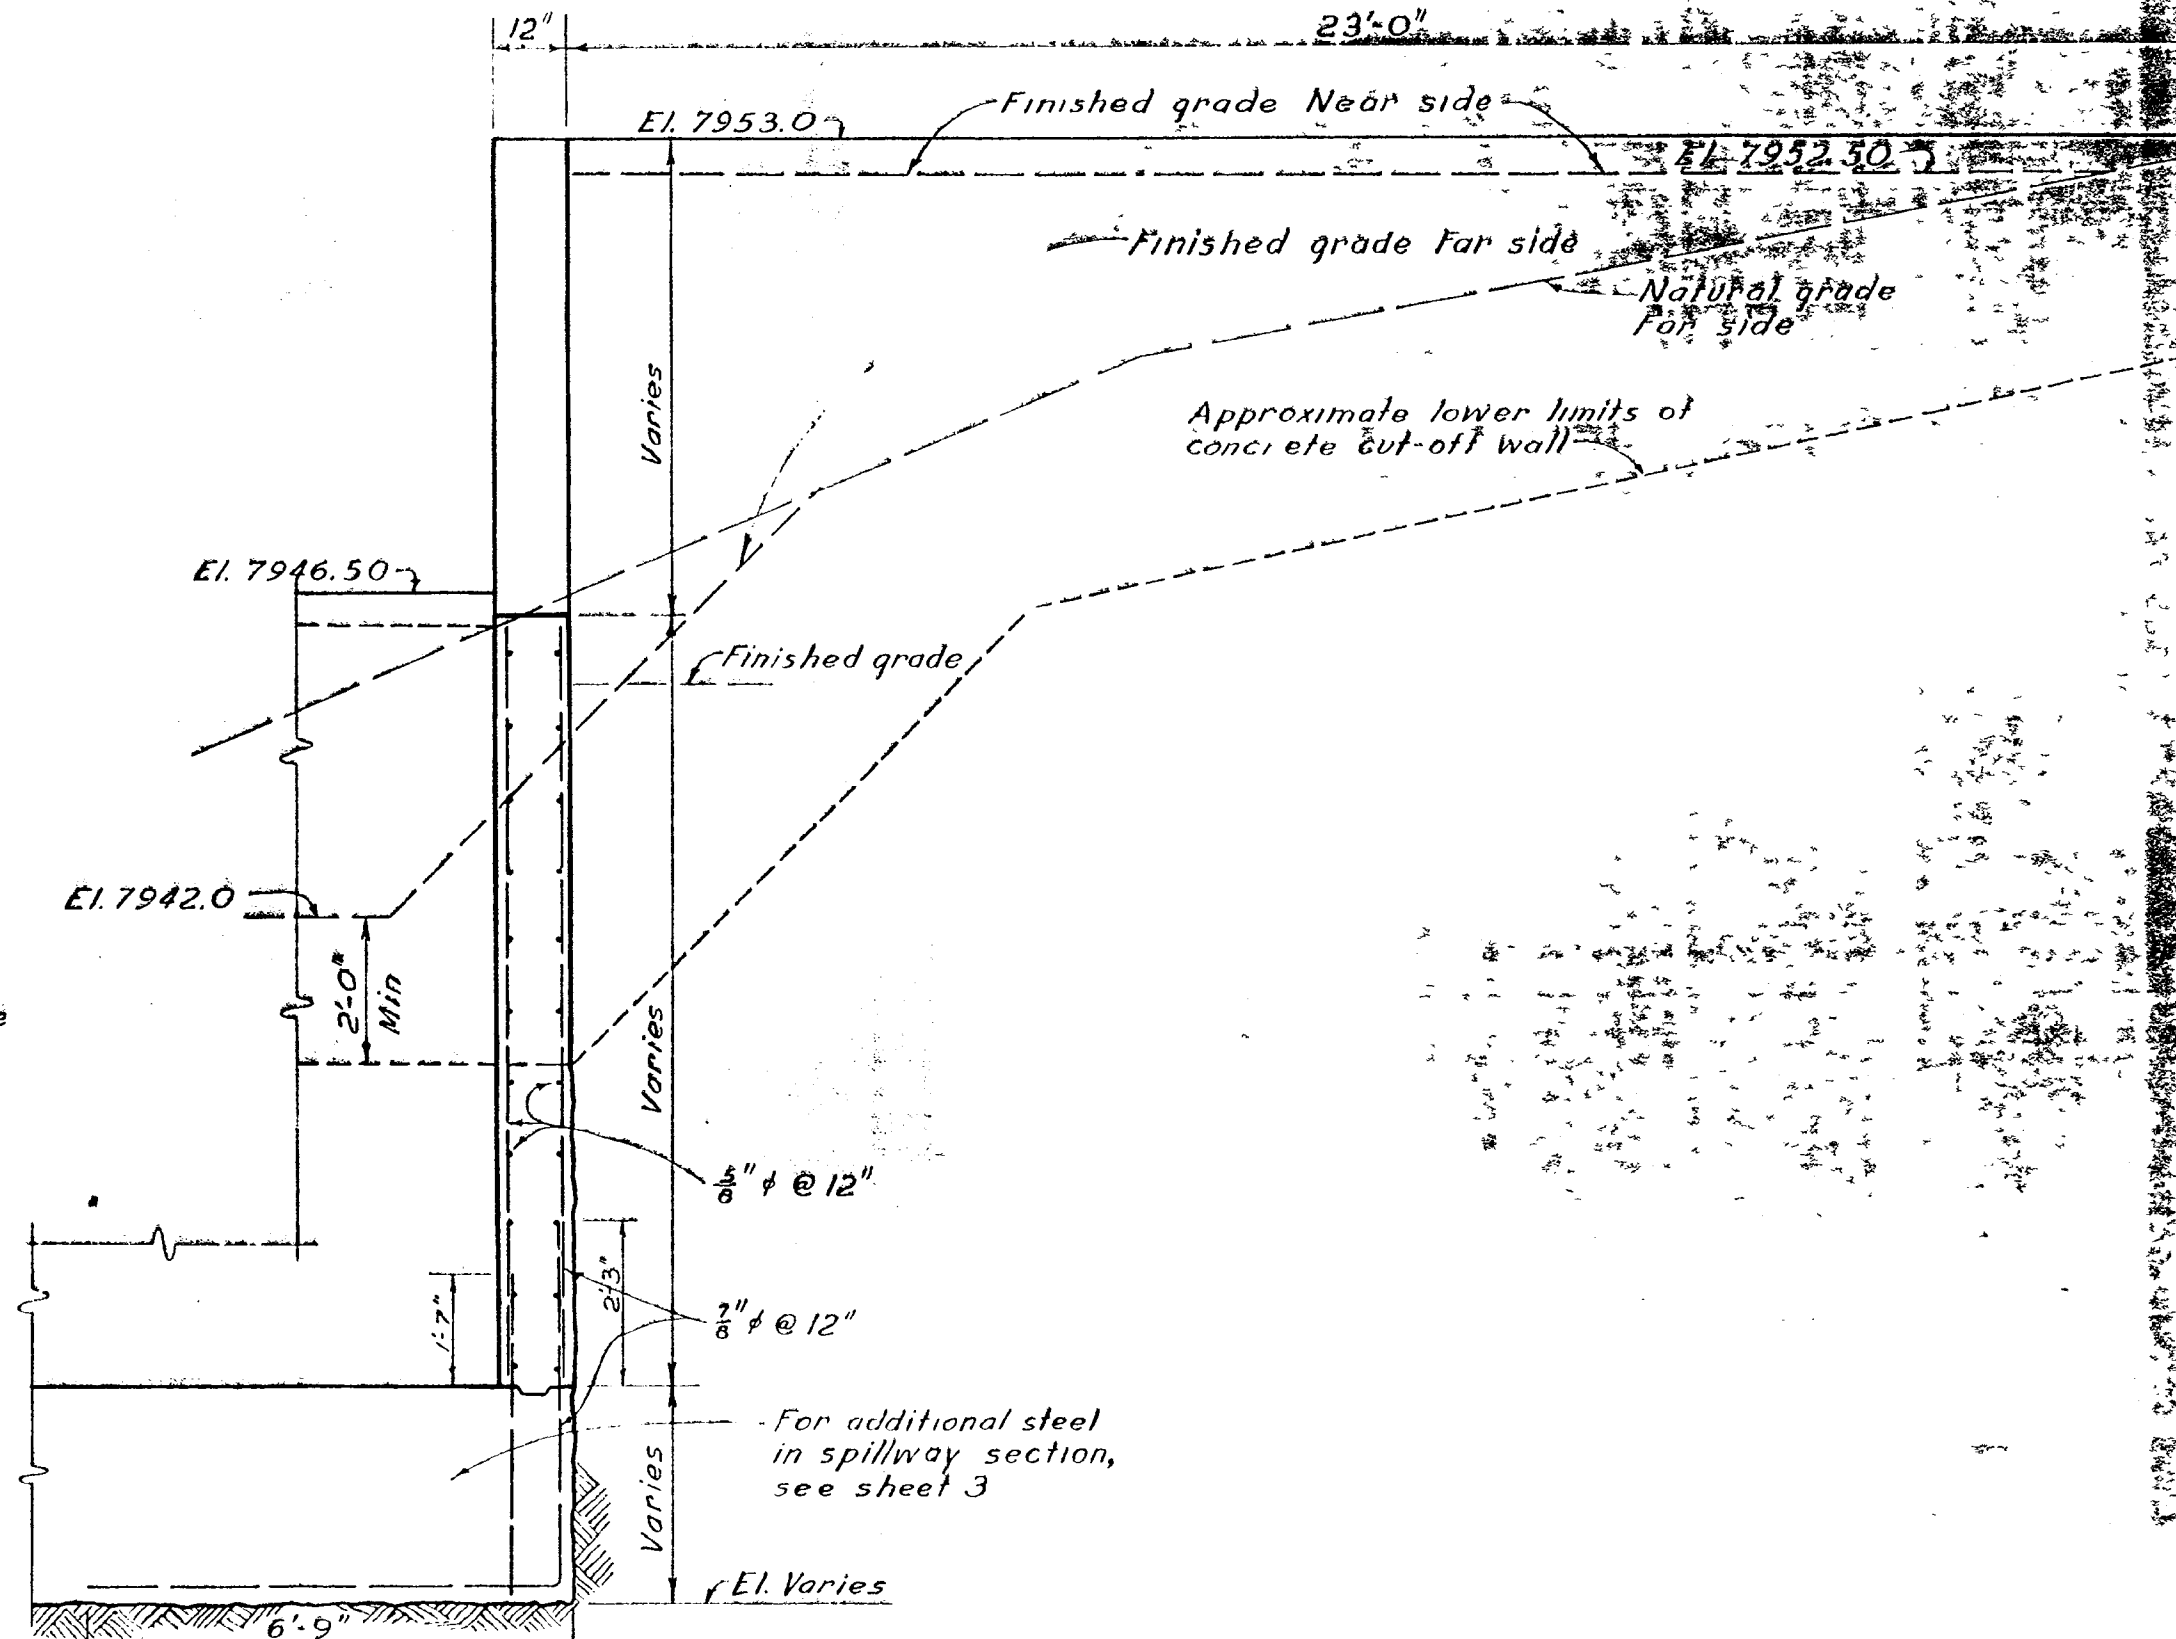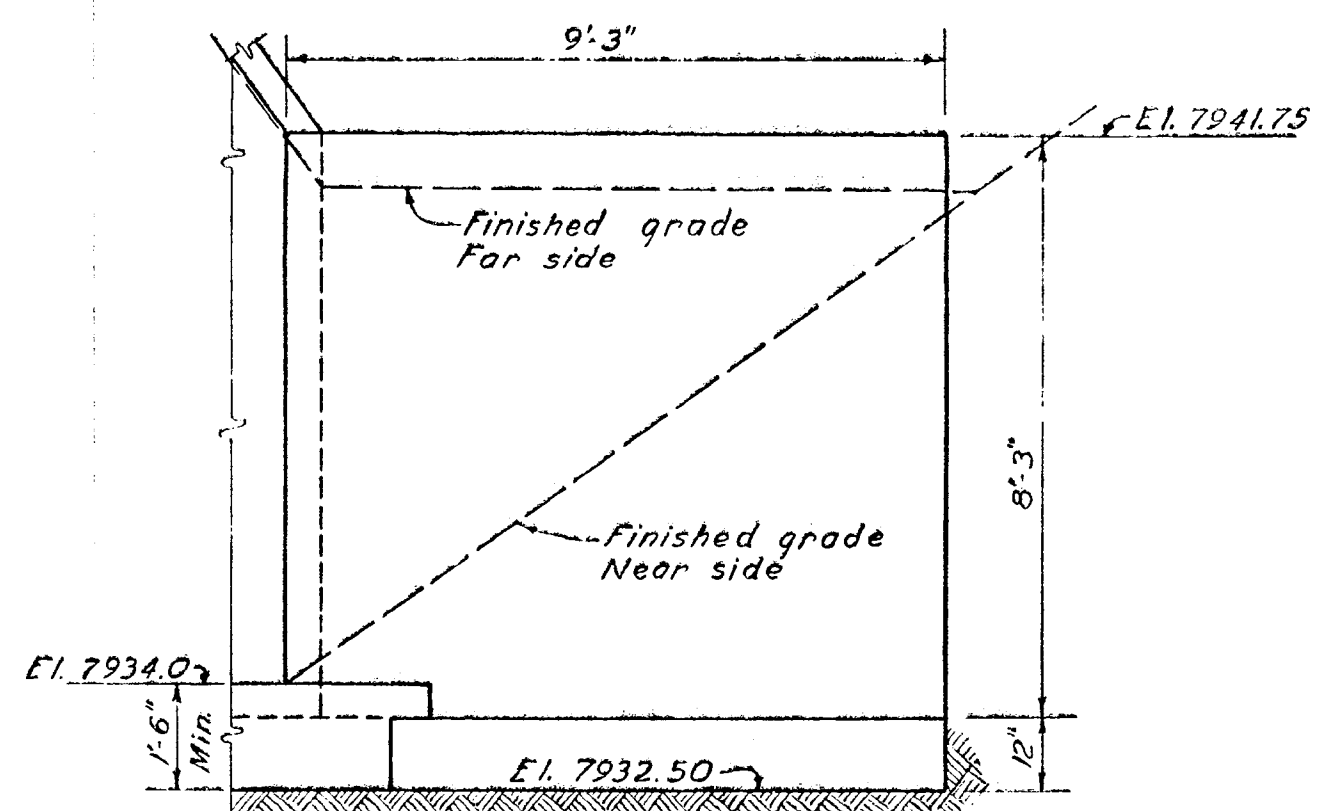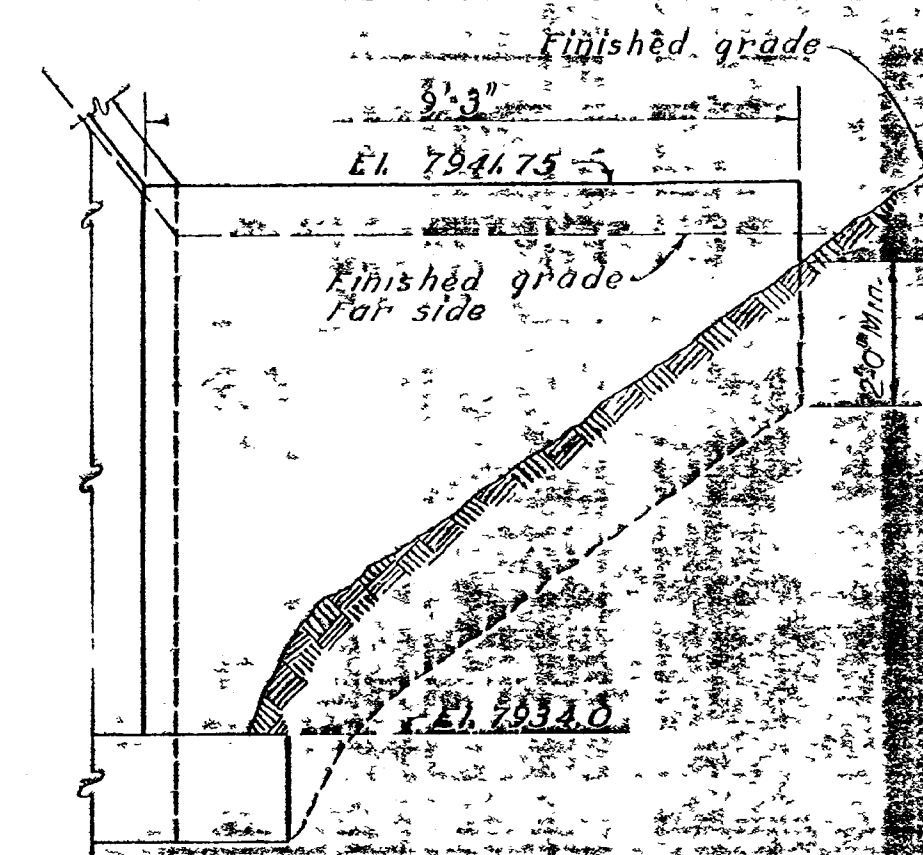

SECTION 56-56
Scale $\frac{1}{8}$ " = 1'-0"

LAKE GEORGE DIVERSION DAM
IRRIGATION DIVISION NO. 1, WATER DISTRICT NO. 23
PARK COUNTY, COLORADO

I HEREBY CERTIFY THAT THESE PLANS FOR THE CONSTRUCTION OF THE LAKE GEORGE DIVERSION DAM WERE PREPARED UNDER MY DIRECT SUPERVISION FOR THE OWNERS THEREOF.

[Signature]
(REGISTERED ENGINEER)

SUBSCRIBED AND SWORN TO BEFORE ME THIS 2 DAY OF *July* 1952.

[Signature]
(NOTARY PUBLIC)

MY COMMISSION EXPIRES ON THE 12 DAY OF *August* 1953.

THESE PLANS FOR THE CONSTRUCTION OF THE LAKE GEORGE DIVERSION DAM ARE HEREBY APPROVED AND ACCEPTED BY THE CITY OF COLORADO SPRINGS, COLORADO (OWNER).

[Signature] MAYOR
APPROVED ON THE 30th DAY OF *July* 1952.

[Signature] STATE ENGINEER

FILE NO. _____ DEPUTY

LAKE GEORGE DIVERSION DAM
IRRIGATION DIVISION NO. 1, WATER DISTRICT NO. 23
PARK COUNTY, COLORADO







COLORADO SPRINGS, COLORADO
WATER SUPPLY DEVELOPMENT

NORTH ABUTMENT & WING WALLS

BLACK & VEATCH
CONSULTING ENGINEERS, KANSAS CITY, MO.

DESIGNED BY *MMH* CHECKED BY *MMH*
DETAILED BY *MMH* APPROVED BY *MMH*
TRACED BY *MMH* DATE *7/10/52*

C-617

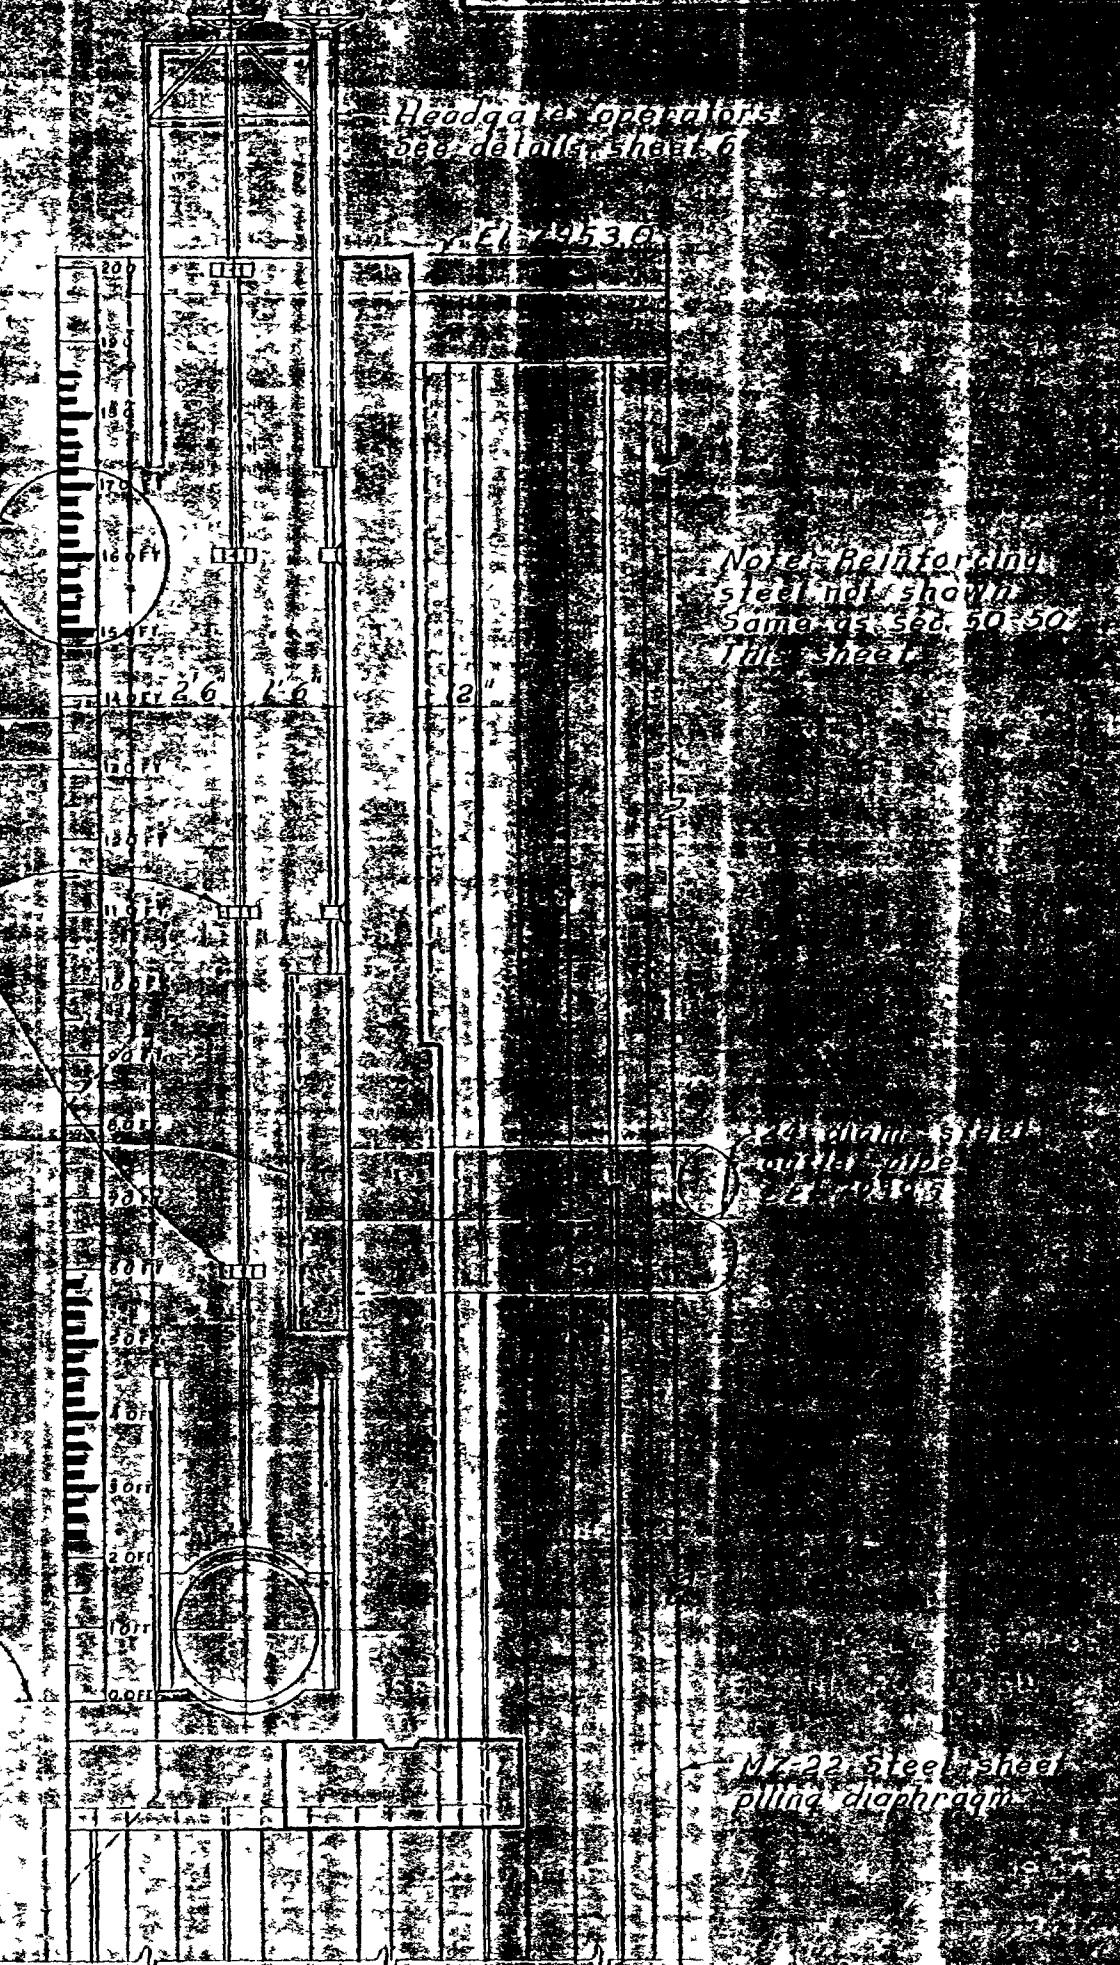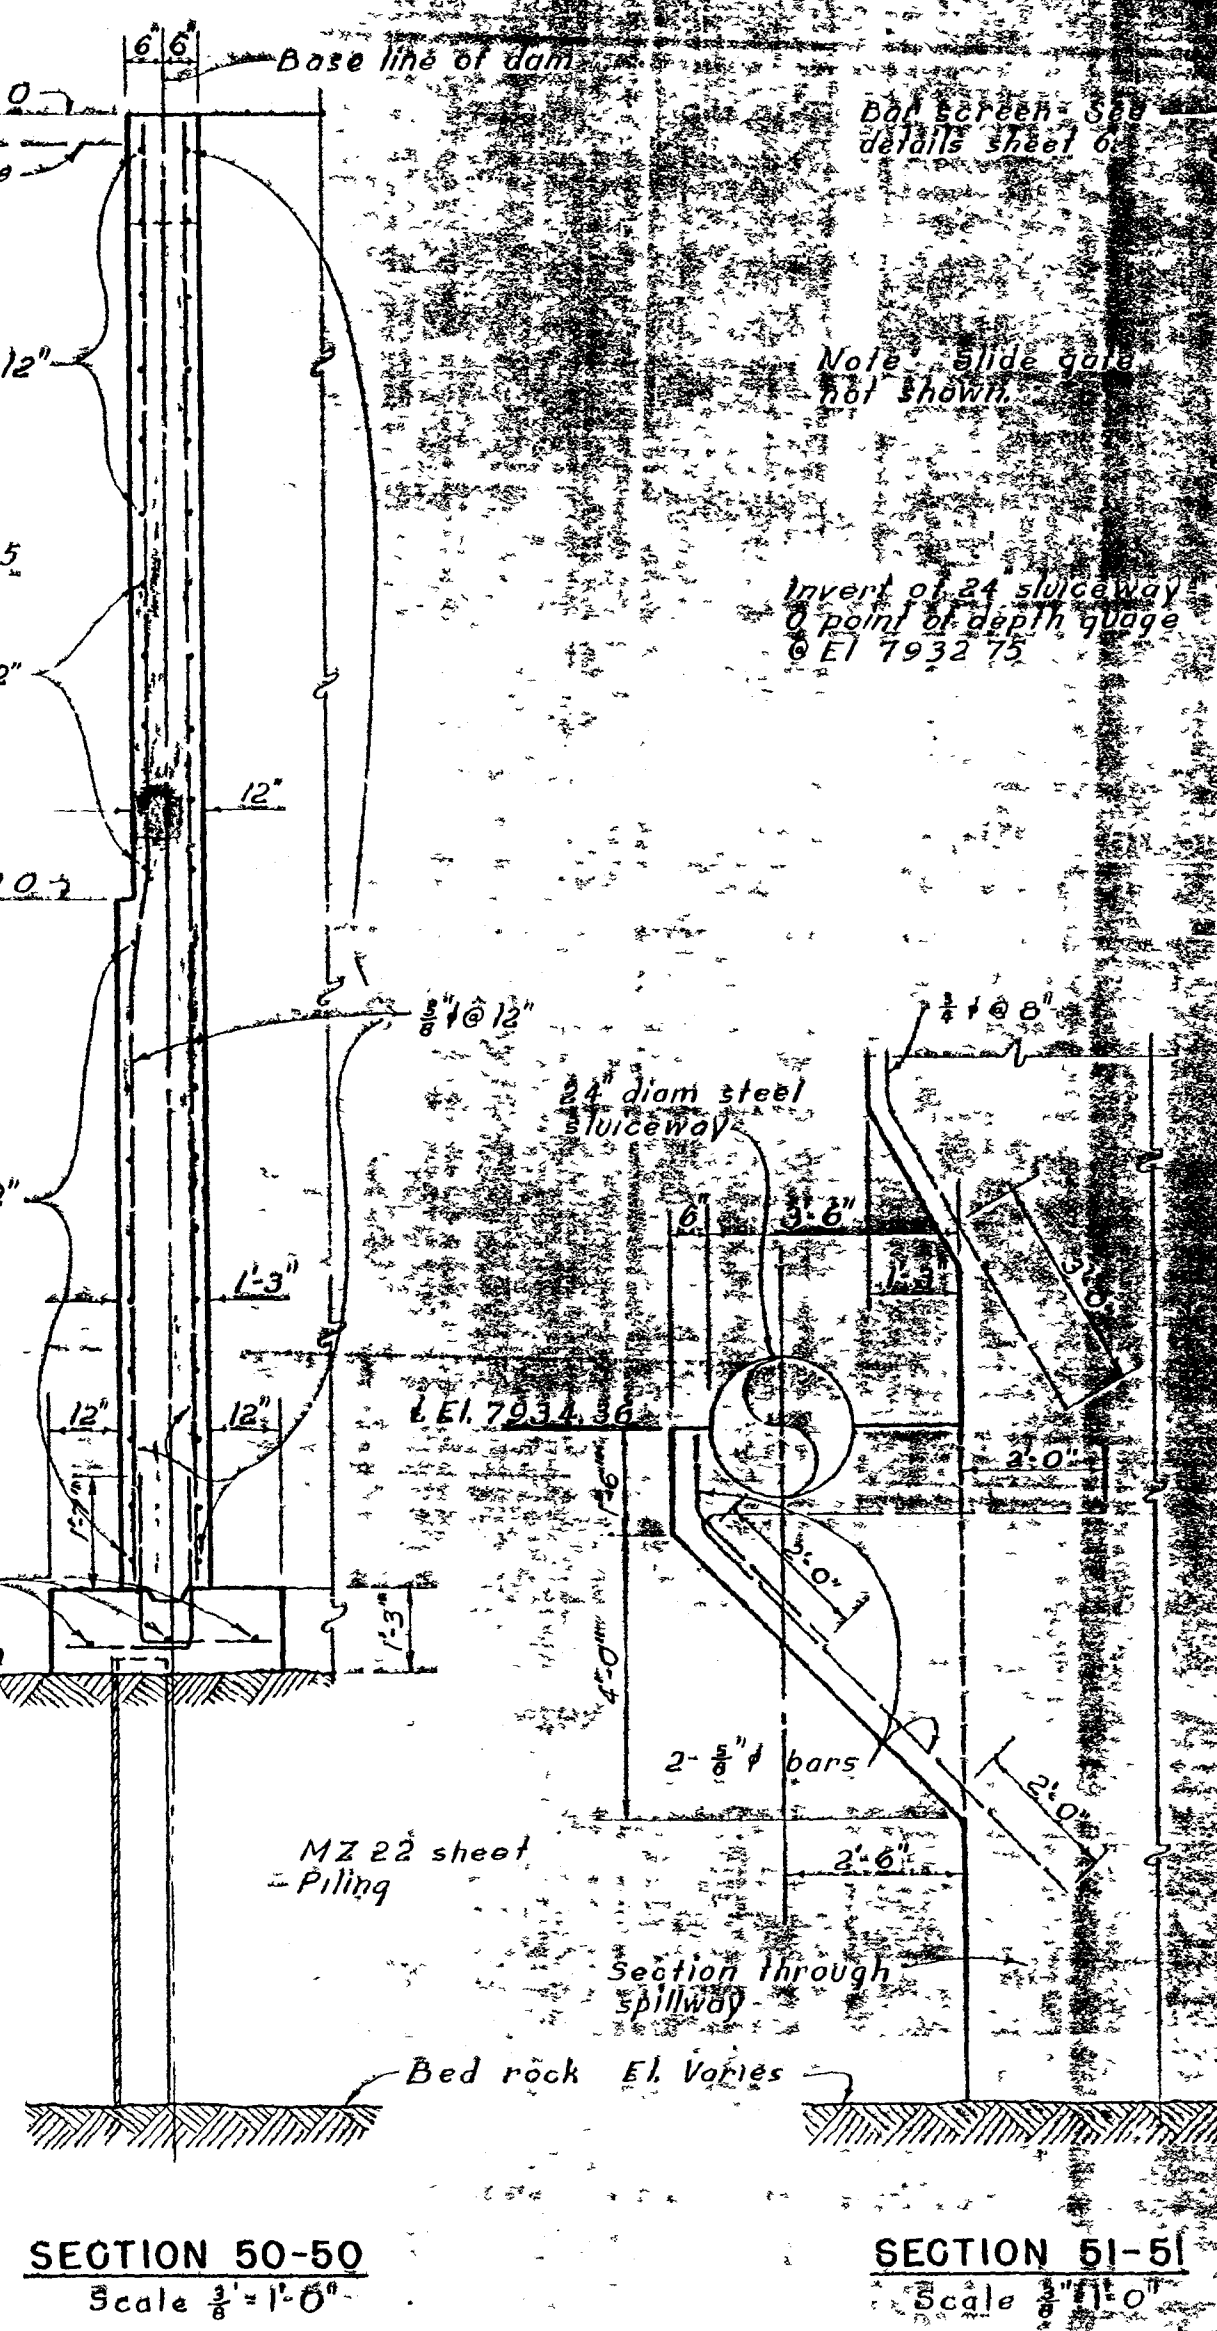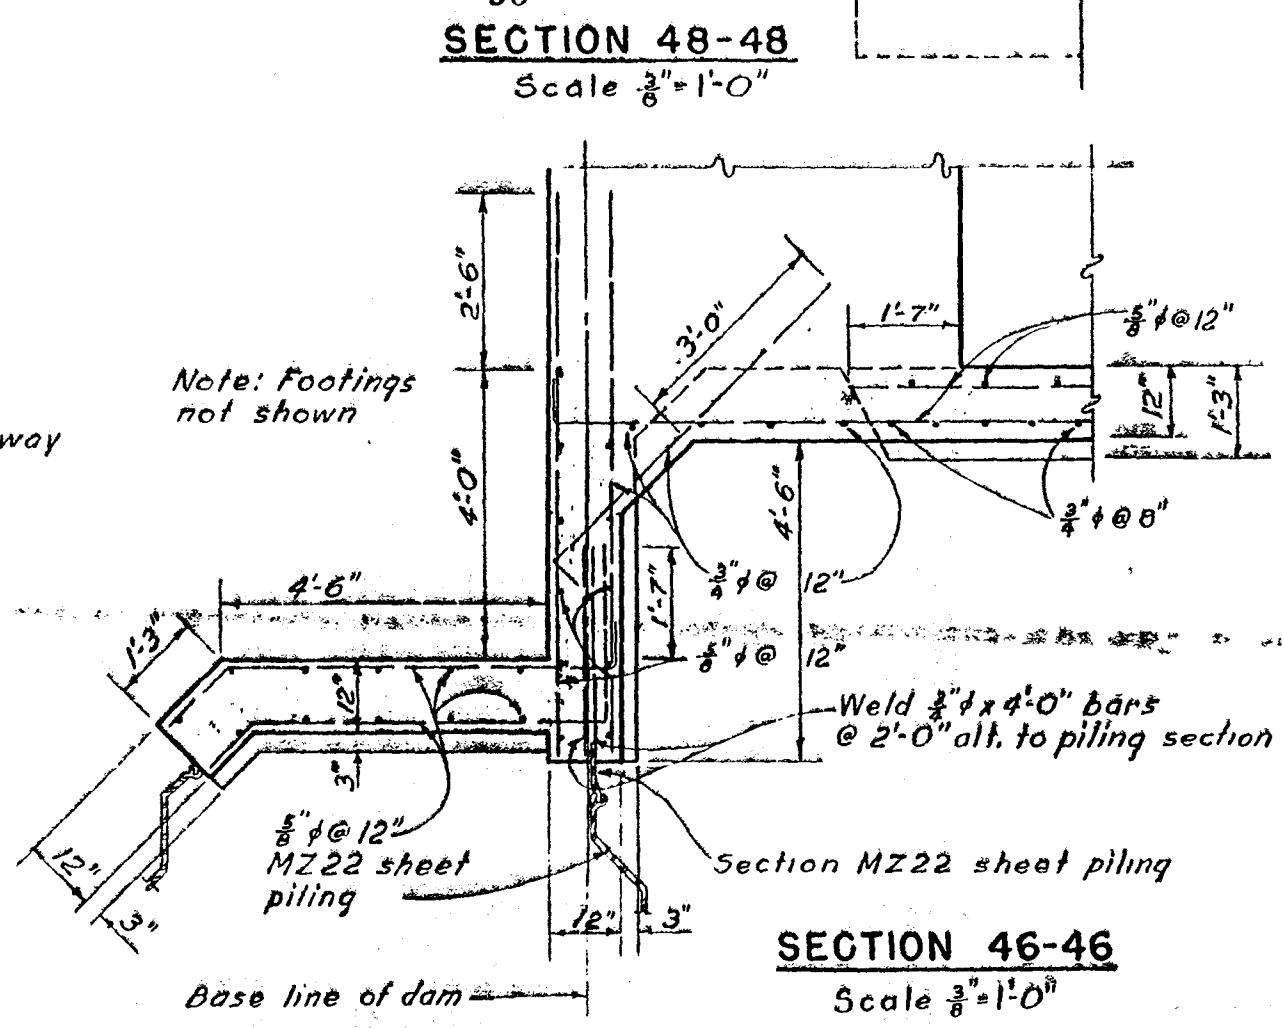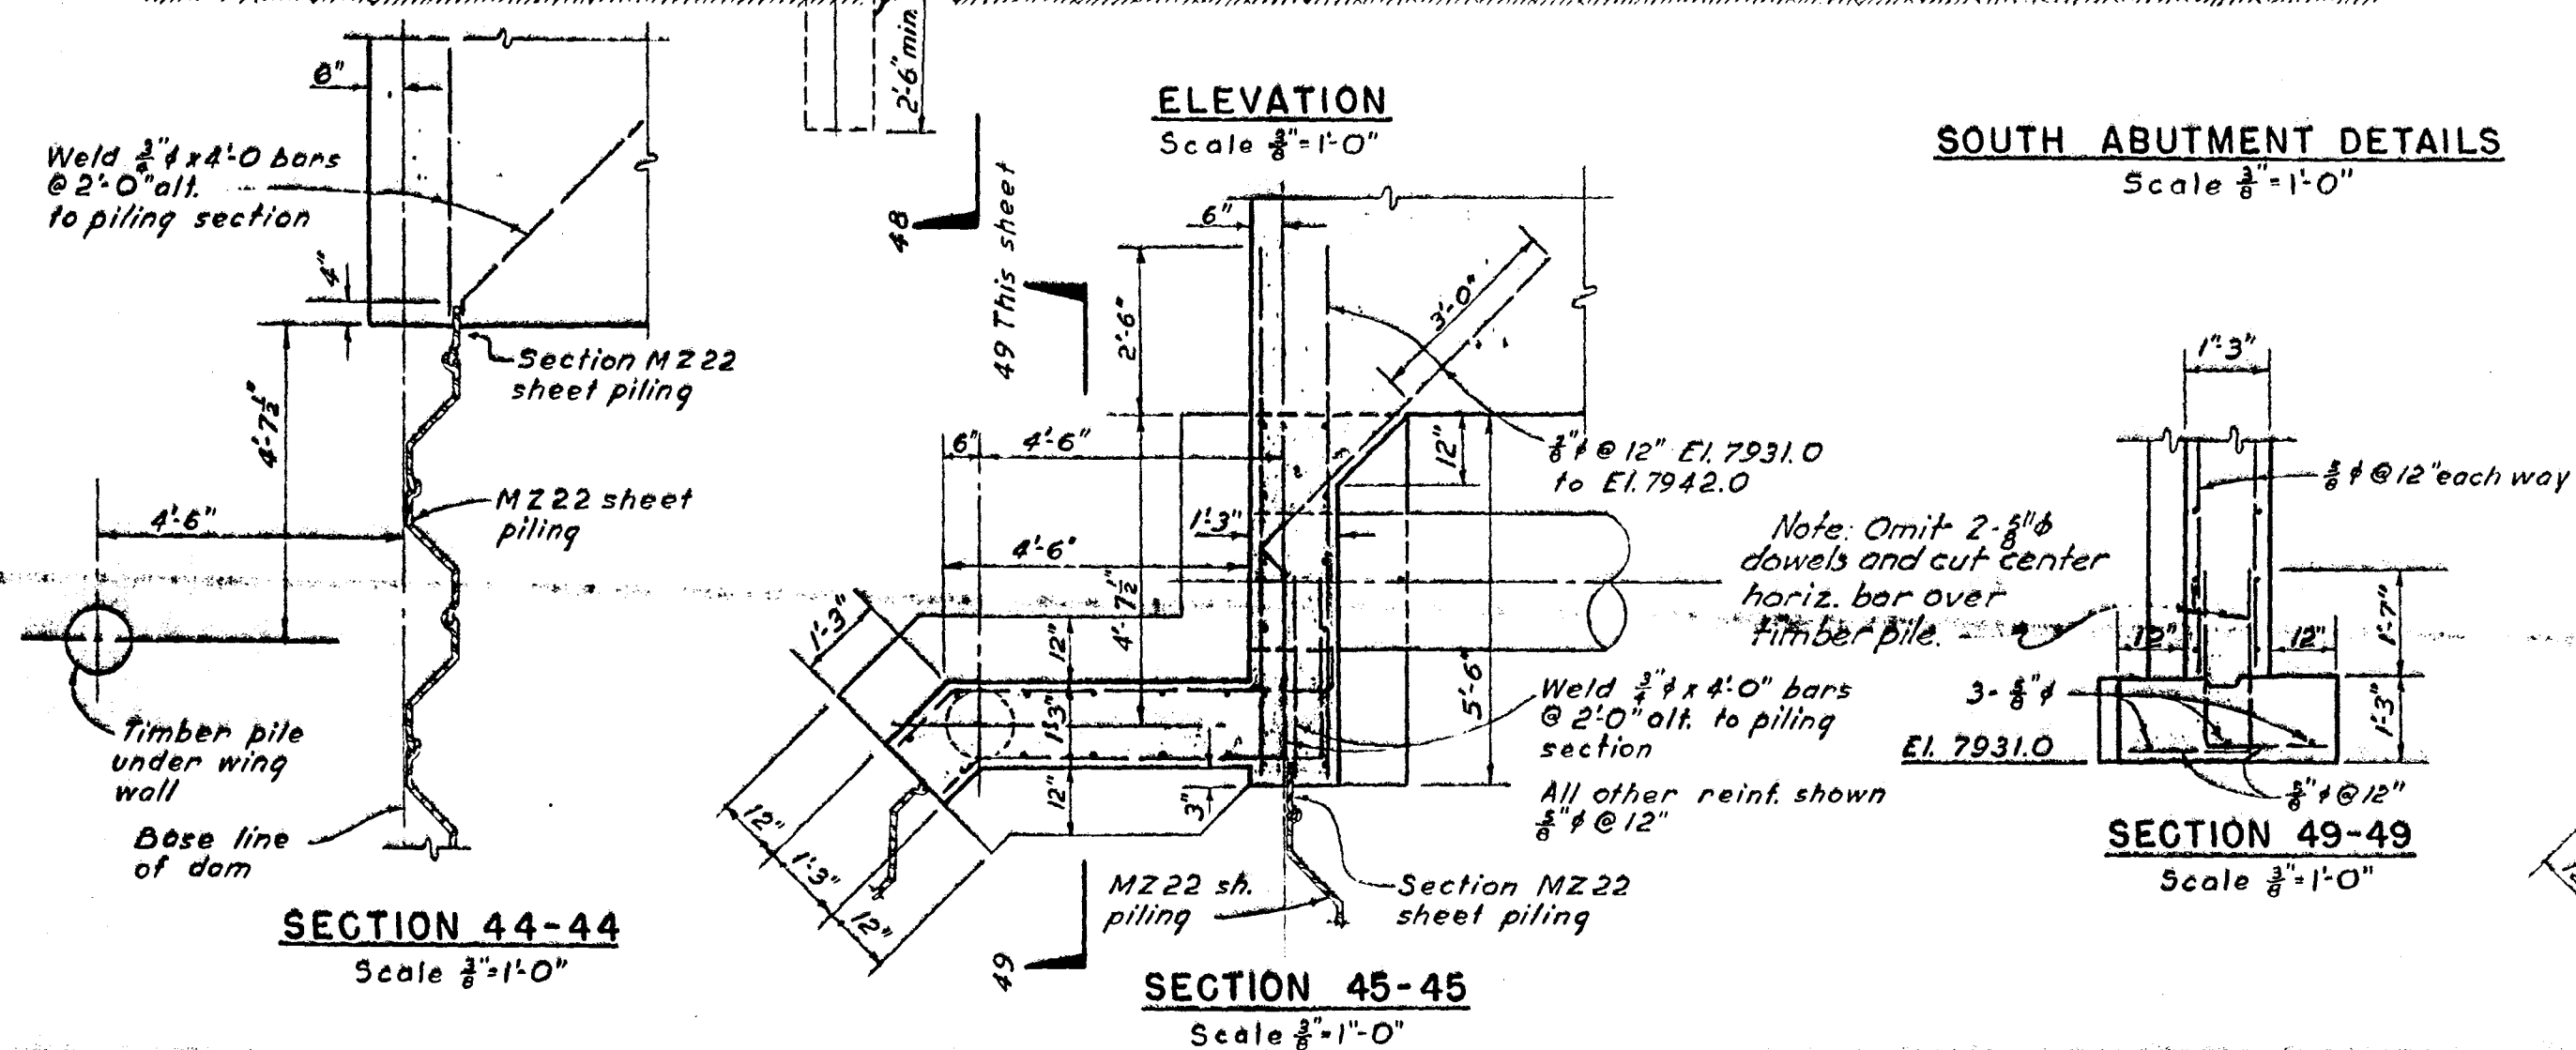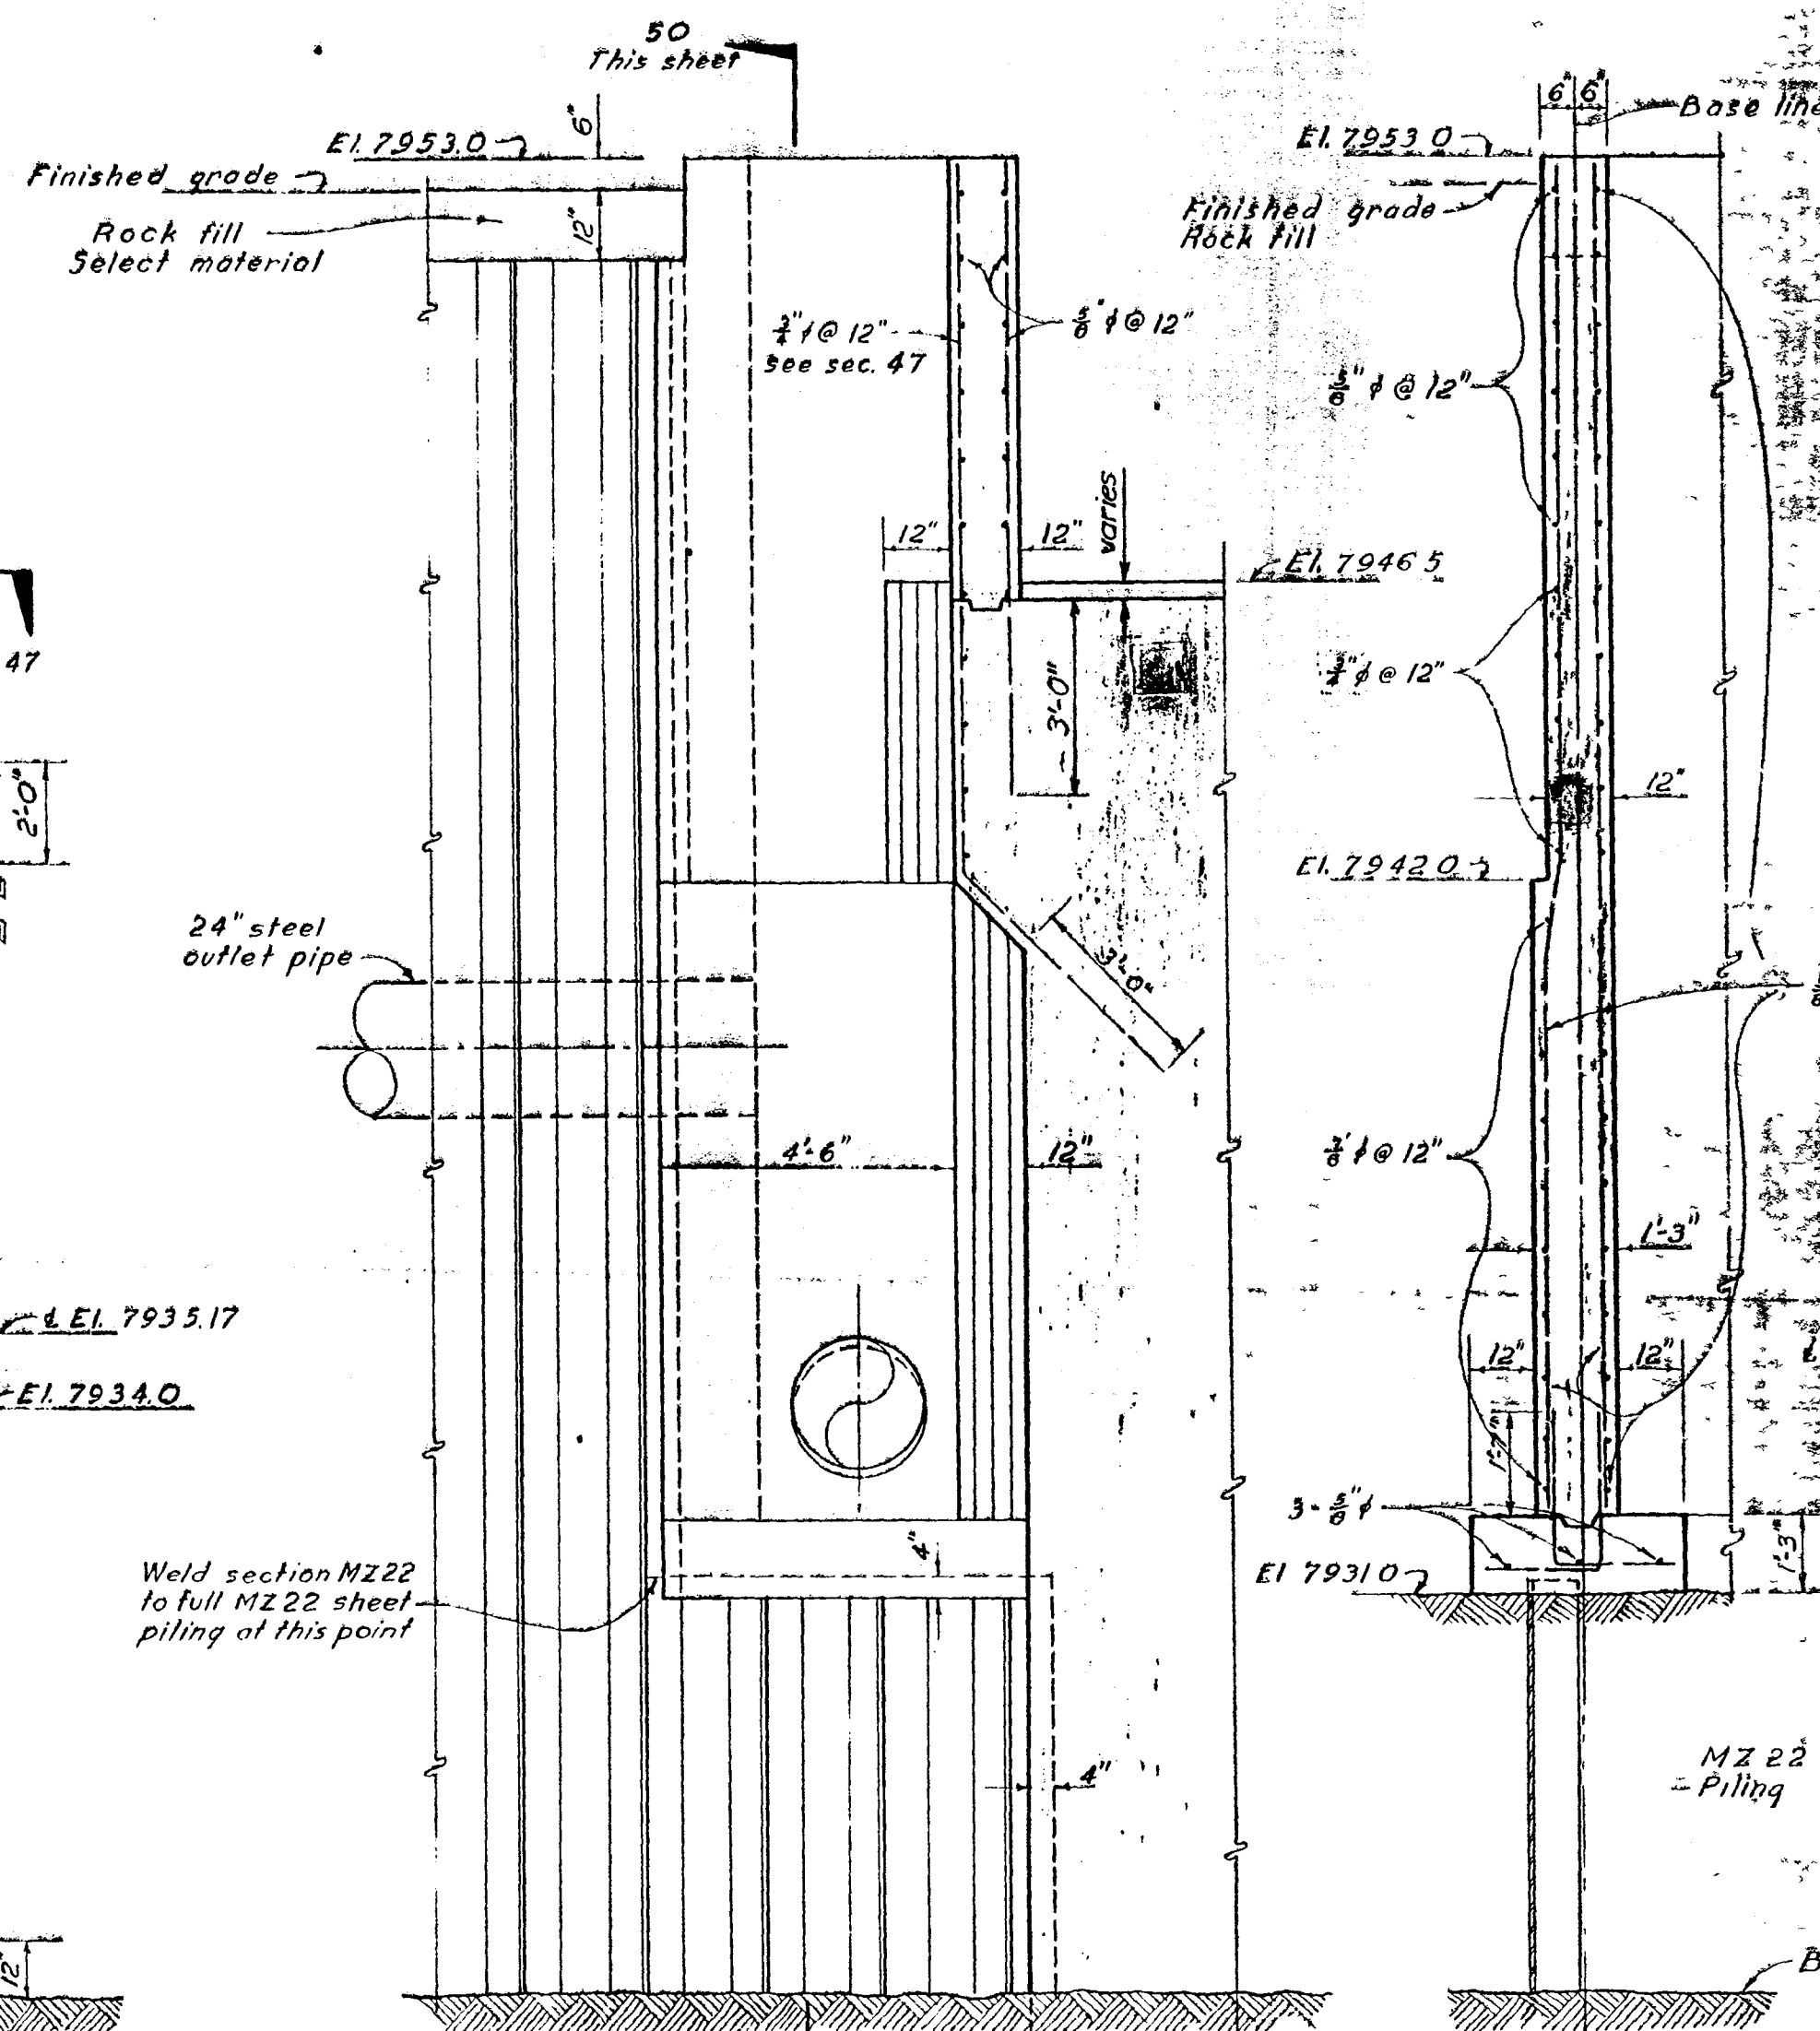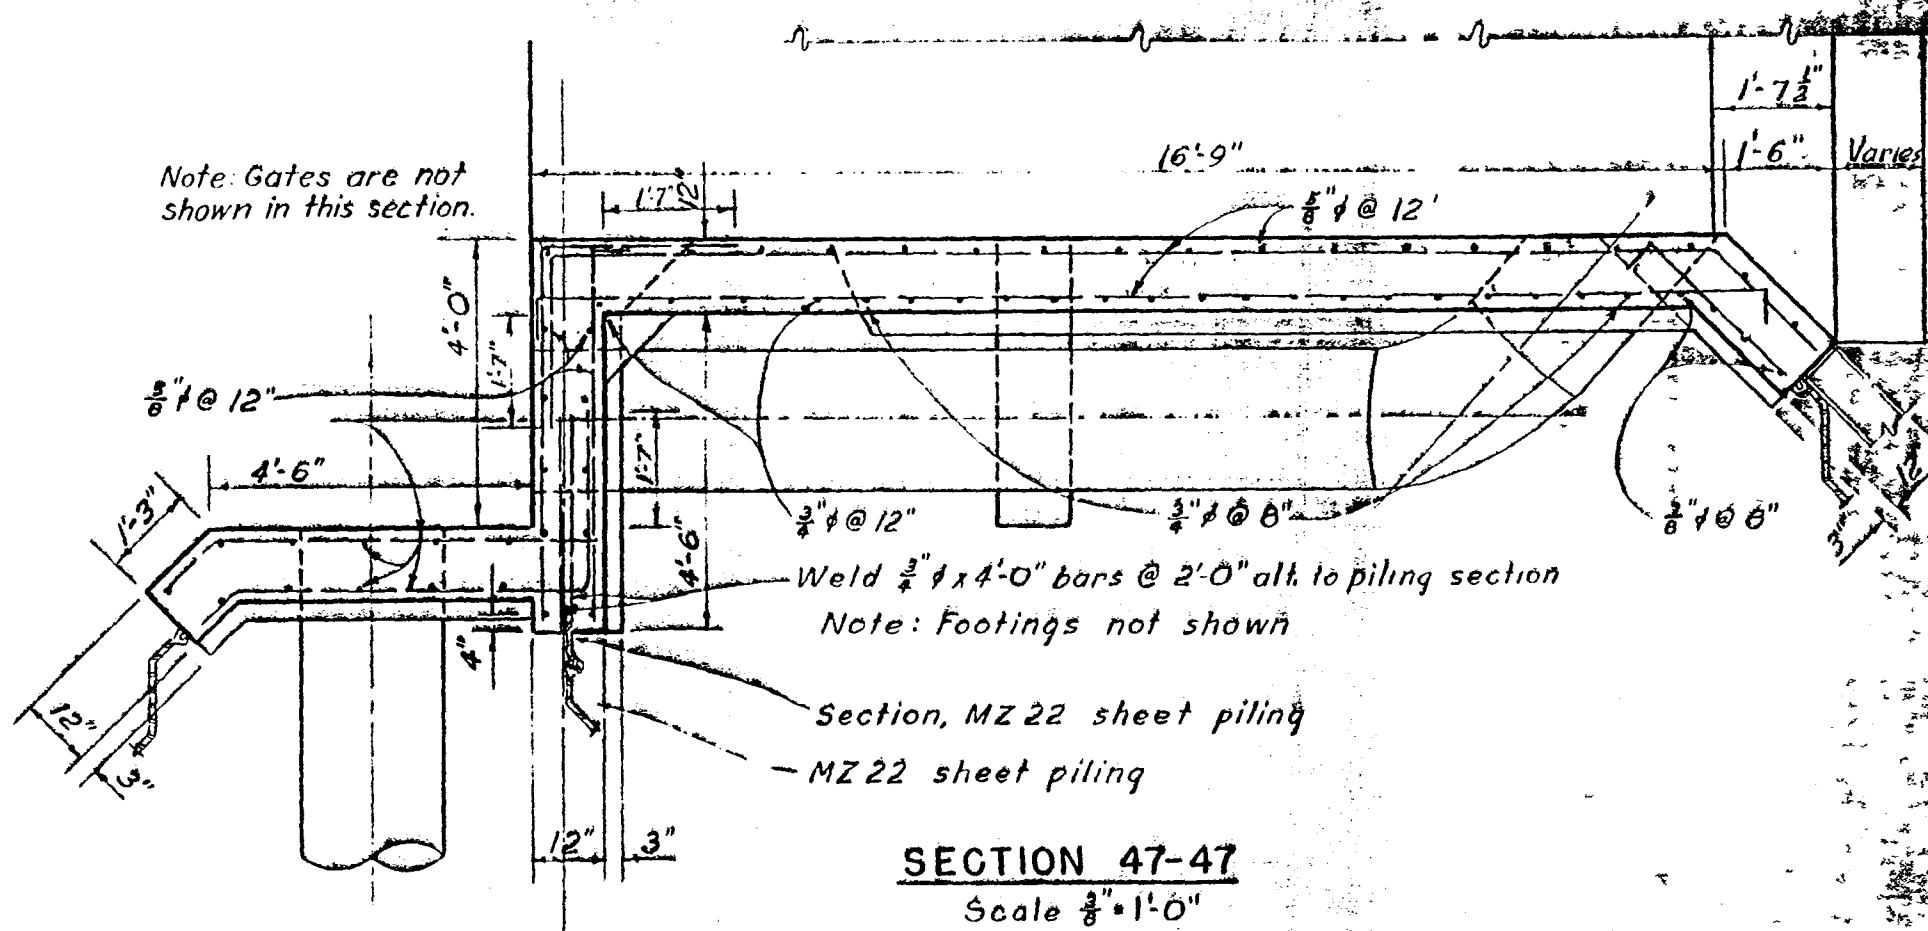

SECTION 70-70

LAKE CLOUVERSON DAM

HEREBY CERTIFY THAT THESE PLANS FOR THE CONSTRUCTION OF THE LAKE GEORGE DIVERSION DAM WERE PREPARED UNDER MY DIRECT SUPERVISION FOR THE OWNERS THEREOF.

(REGISTERED ENGINEER)

SUBSCRIBED AND SWORN TO BEFORE ME
THIS 2 DAY OF July, 1953

Signature
(NOTARY PUBLIC)

MY COMMISSION EXPIRES ON THE 12 DAY
OF September 1929.

THESE PLANS FOR THE CONSTRUCTION OF THE LAKE GEORGE DIVERSION DAM ARE HEREBY APPROVED AND ACCEPTED THE CITY OF COLORADO SPRINGS, COLORADO (OWNER)

APPROVED ON THE 30th DAY OF July 1952

M. C. Hingula
STATE ENGINEER

FILE NO _____ DEPUTY _____









LAKE GEORGE DIVERSION DAM
IRRIGATION DIVISION NO. 1 WATER DISTRICT NO. 23
PARK COUNTY

COLORADO SPRINGS, COLORADO
WATER SUPPLY DEVELOPMENT

SOUTH ABUTMENT & WING WALLS

BLACK & VEATCH
CONSULTING ENGINEERS, KANSAS CITY, MO.

DESIGNED DETAILED TRACED	DPM/HHM M/M RUS	CHECKED APPROVED DATE	U M W A 2/10/58 1/27/58	C-6
--------------------------------	-----------------------	-----------------------------	-------------------------------	-----

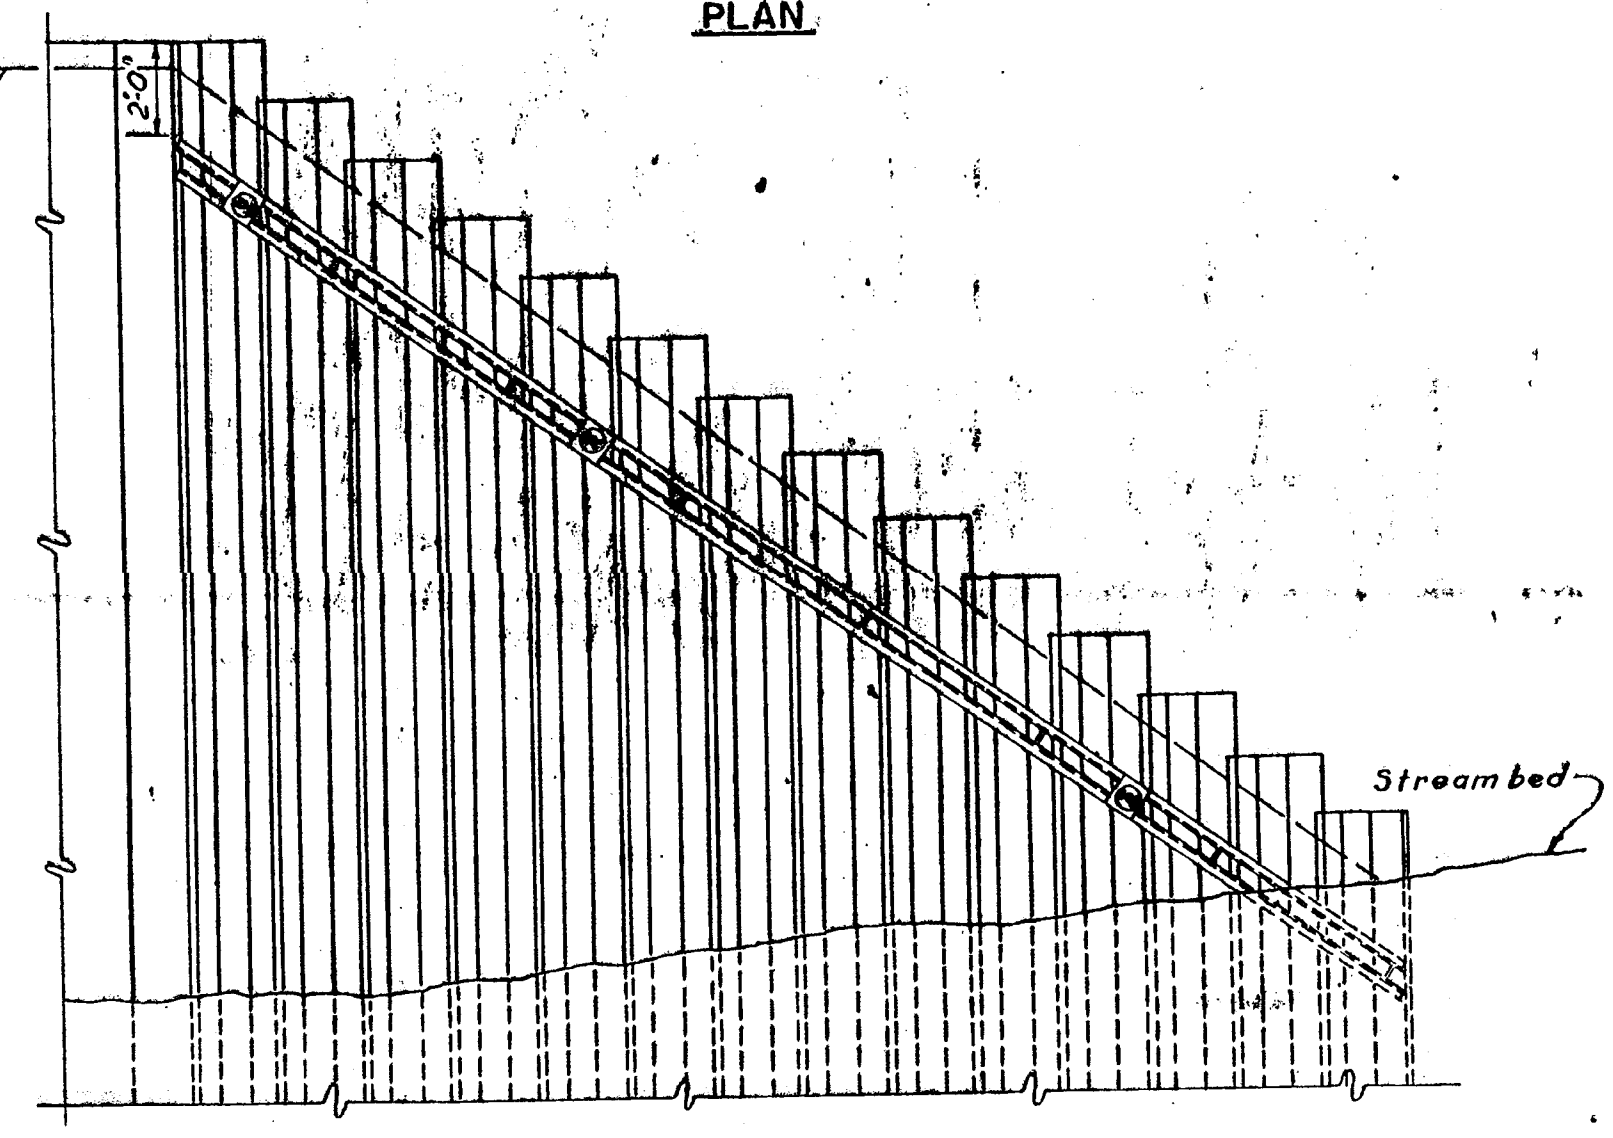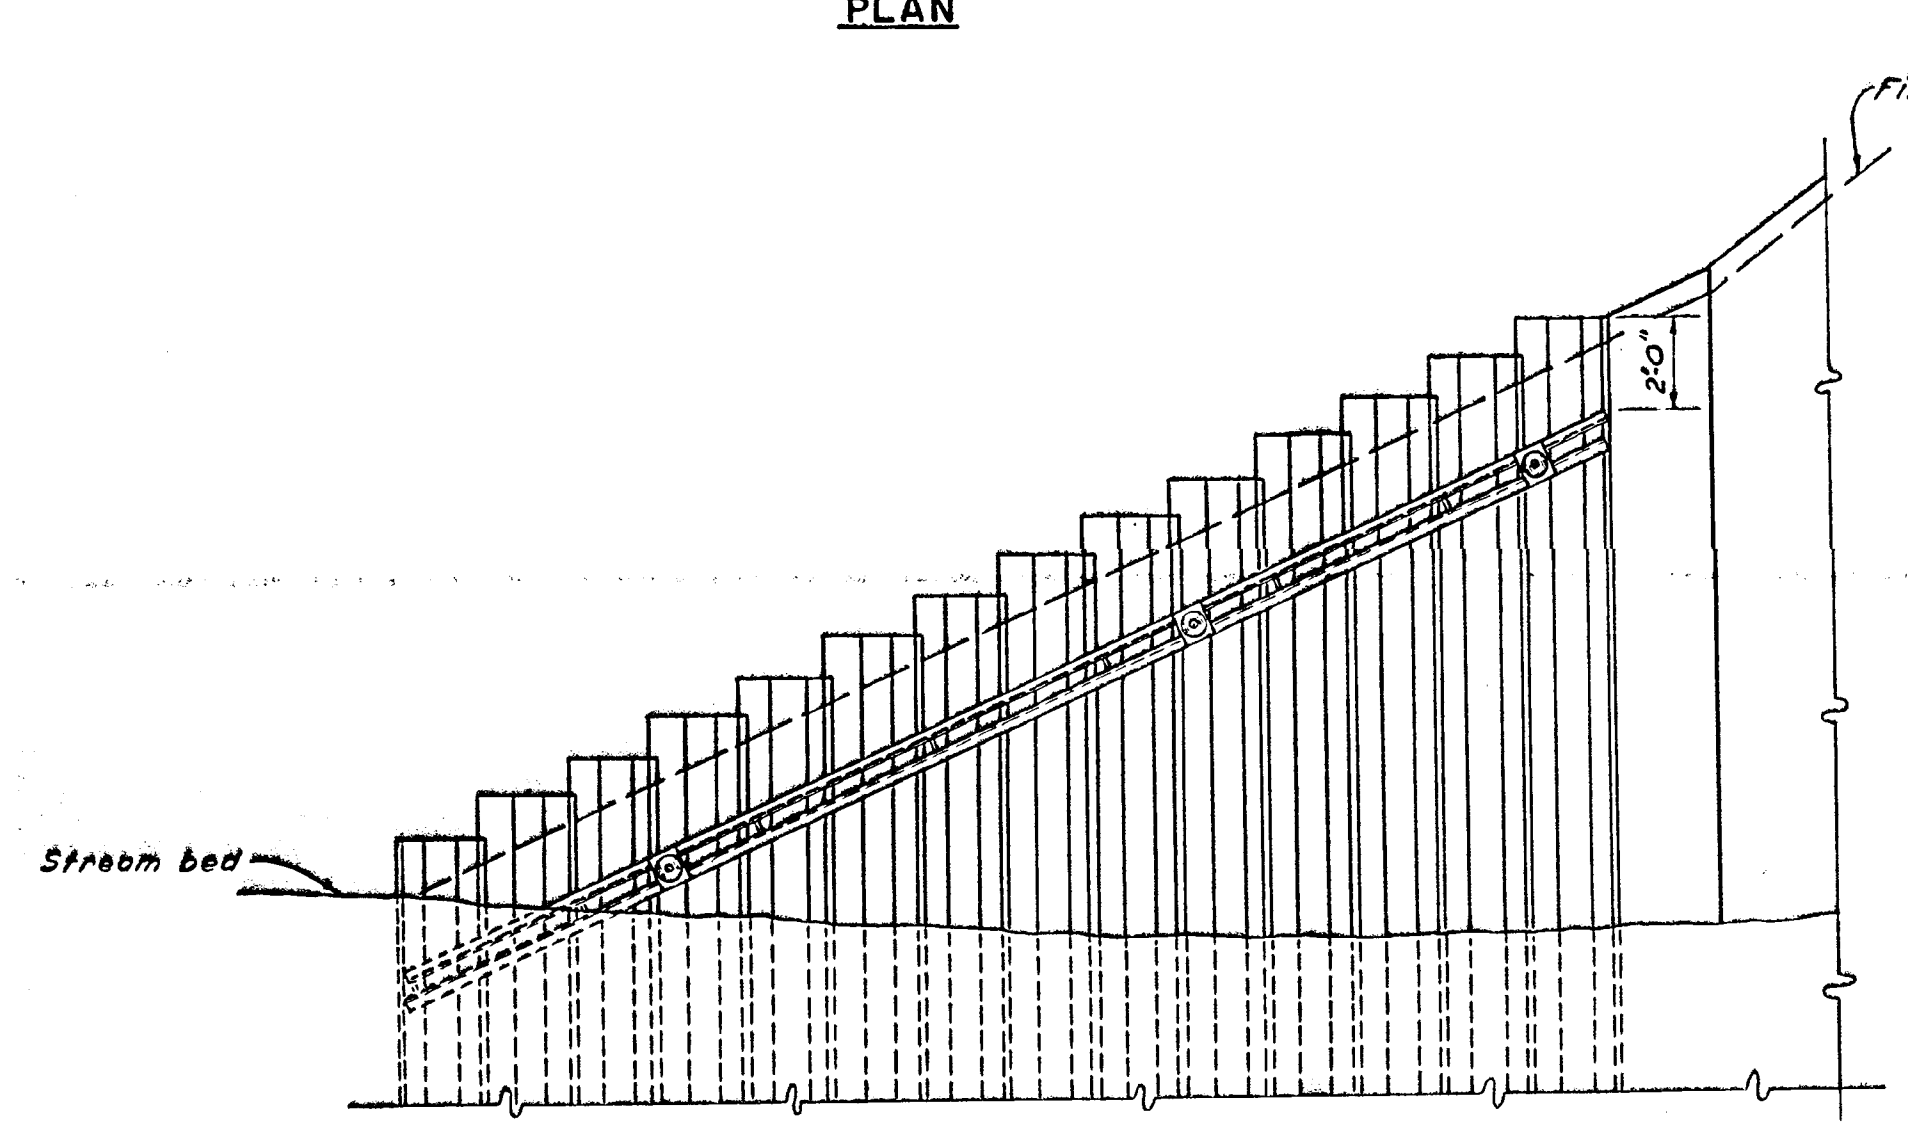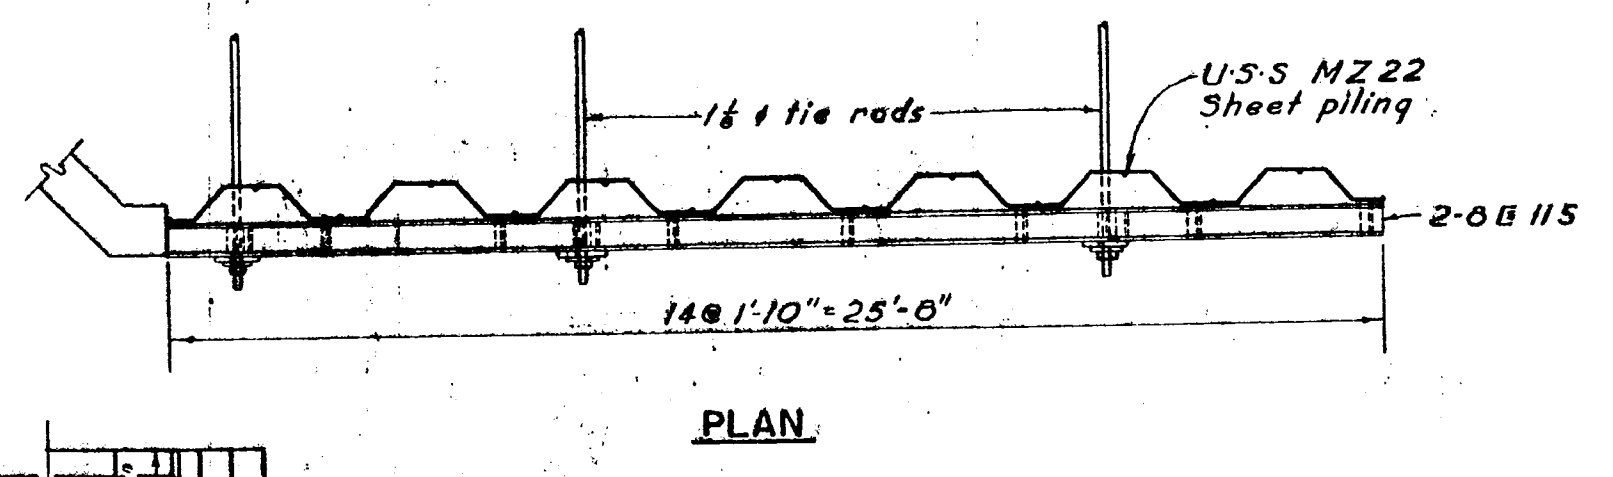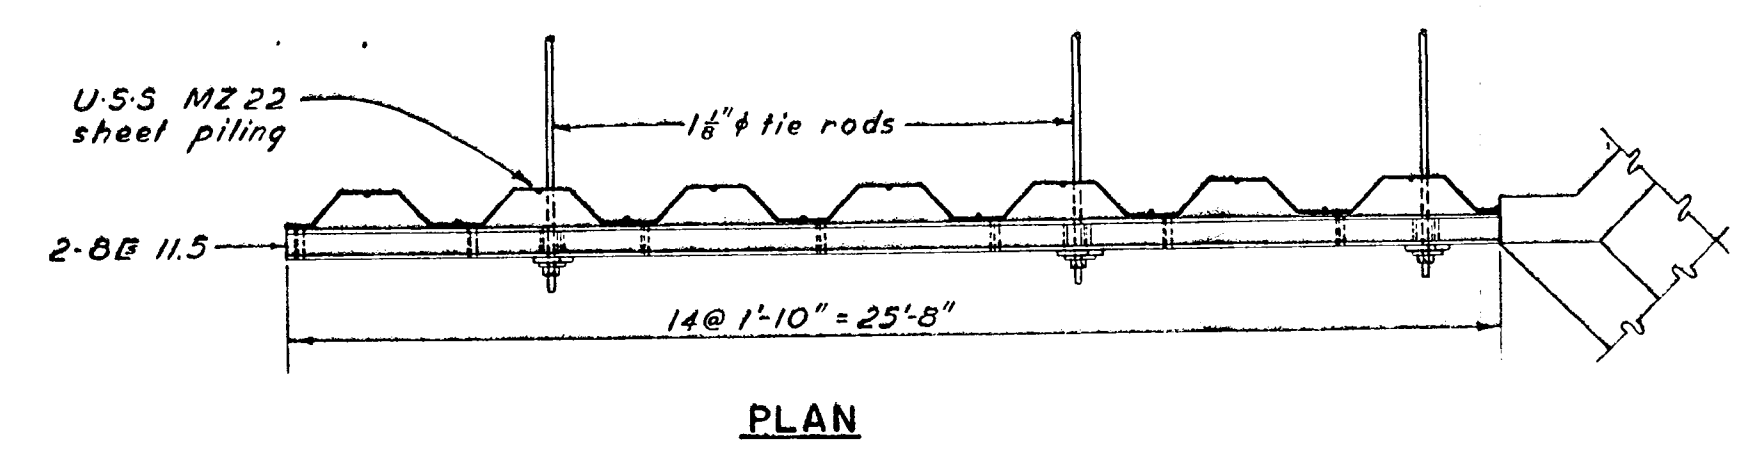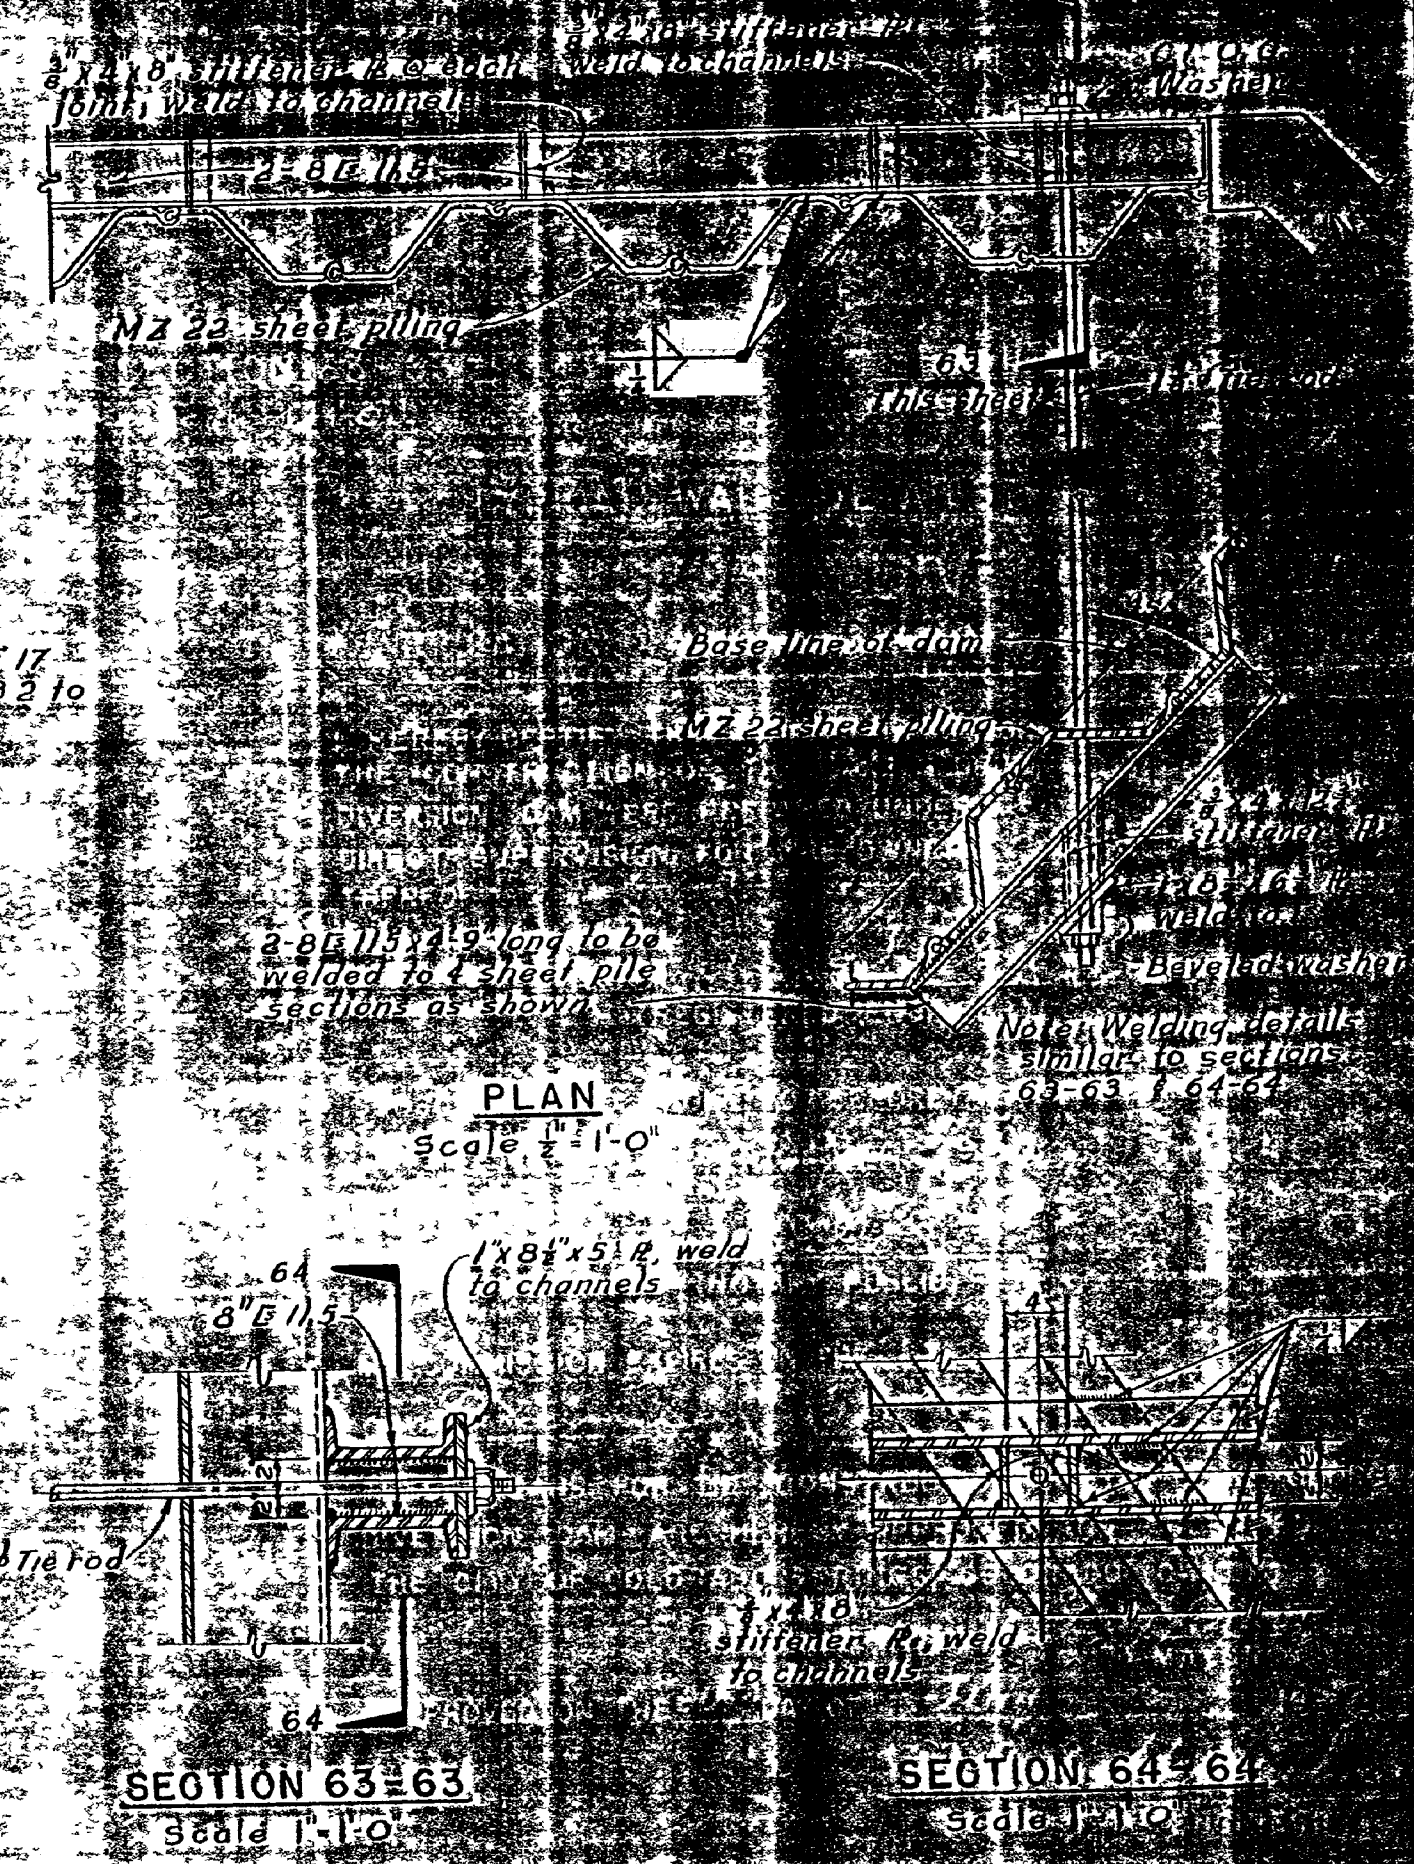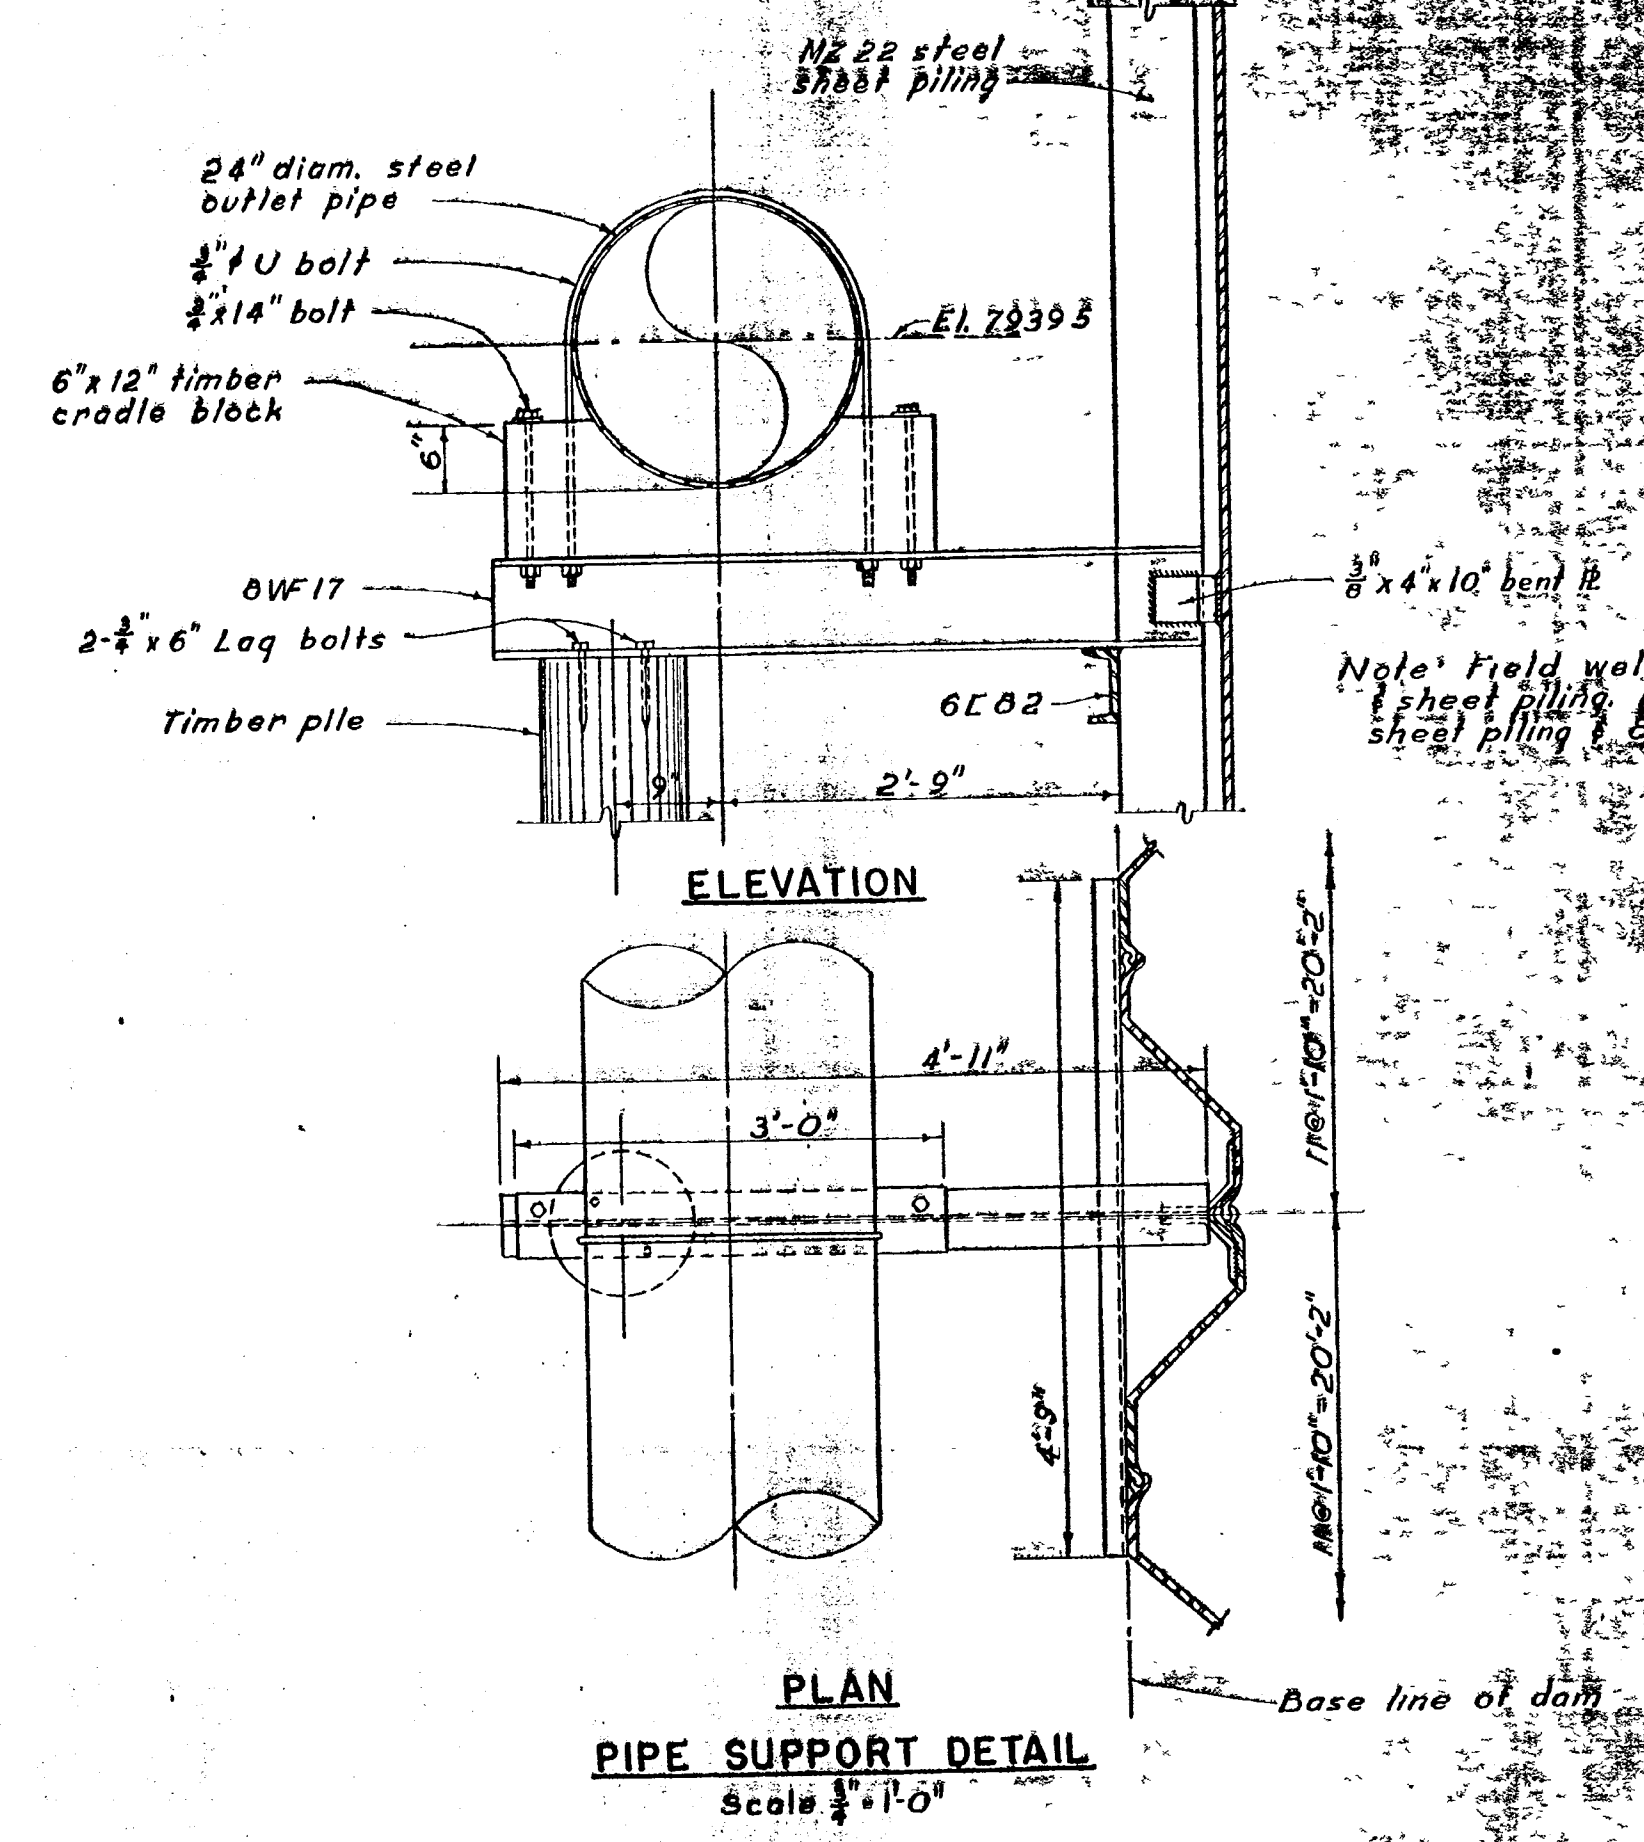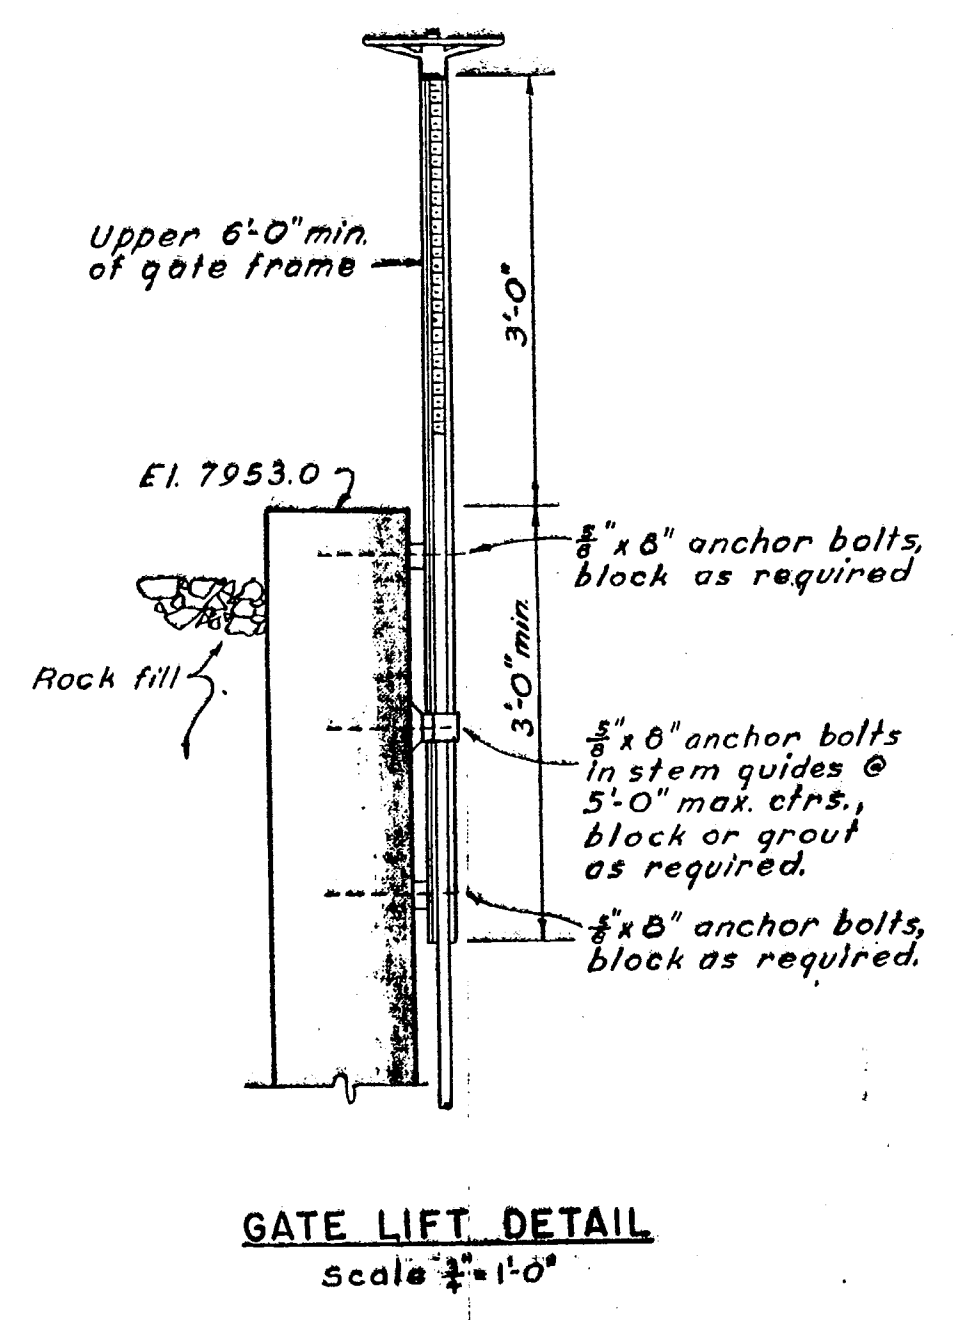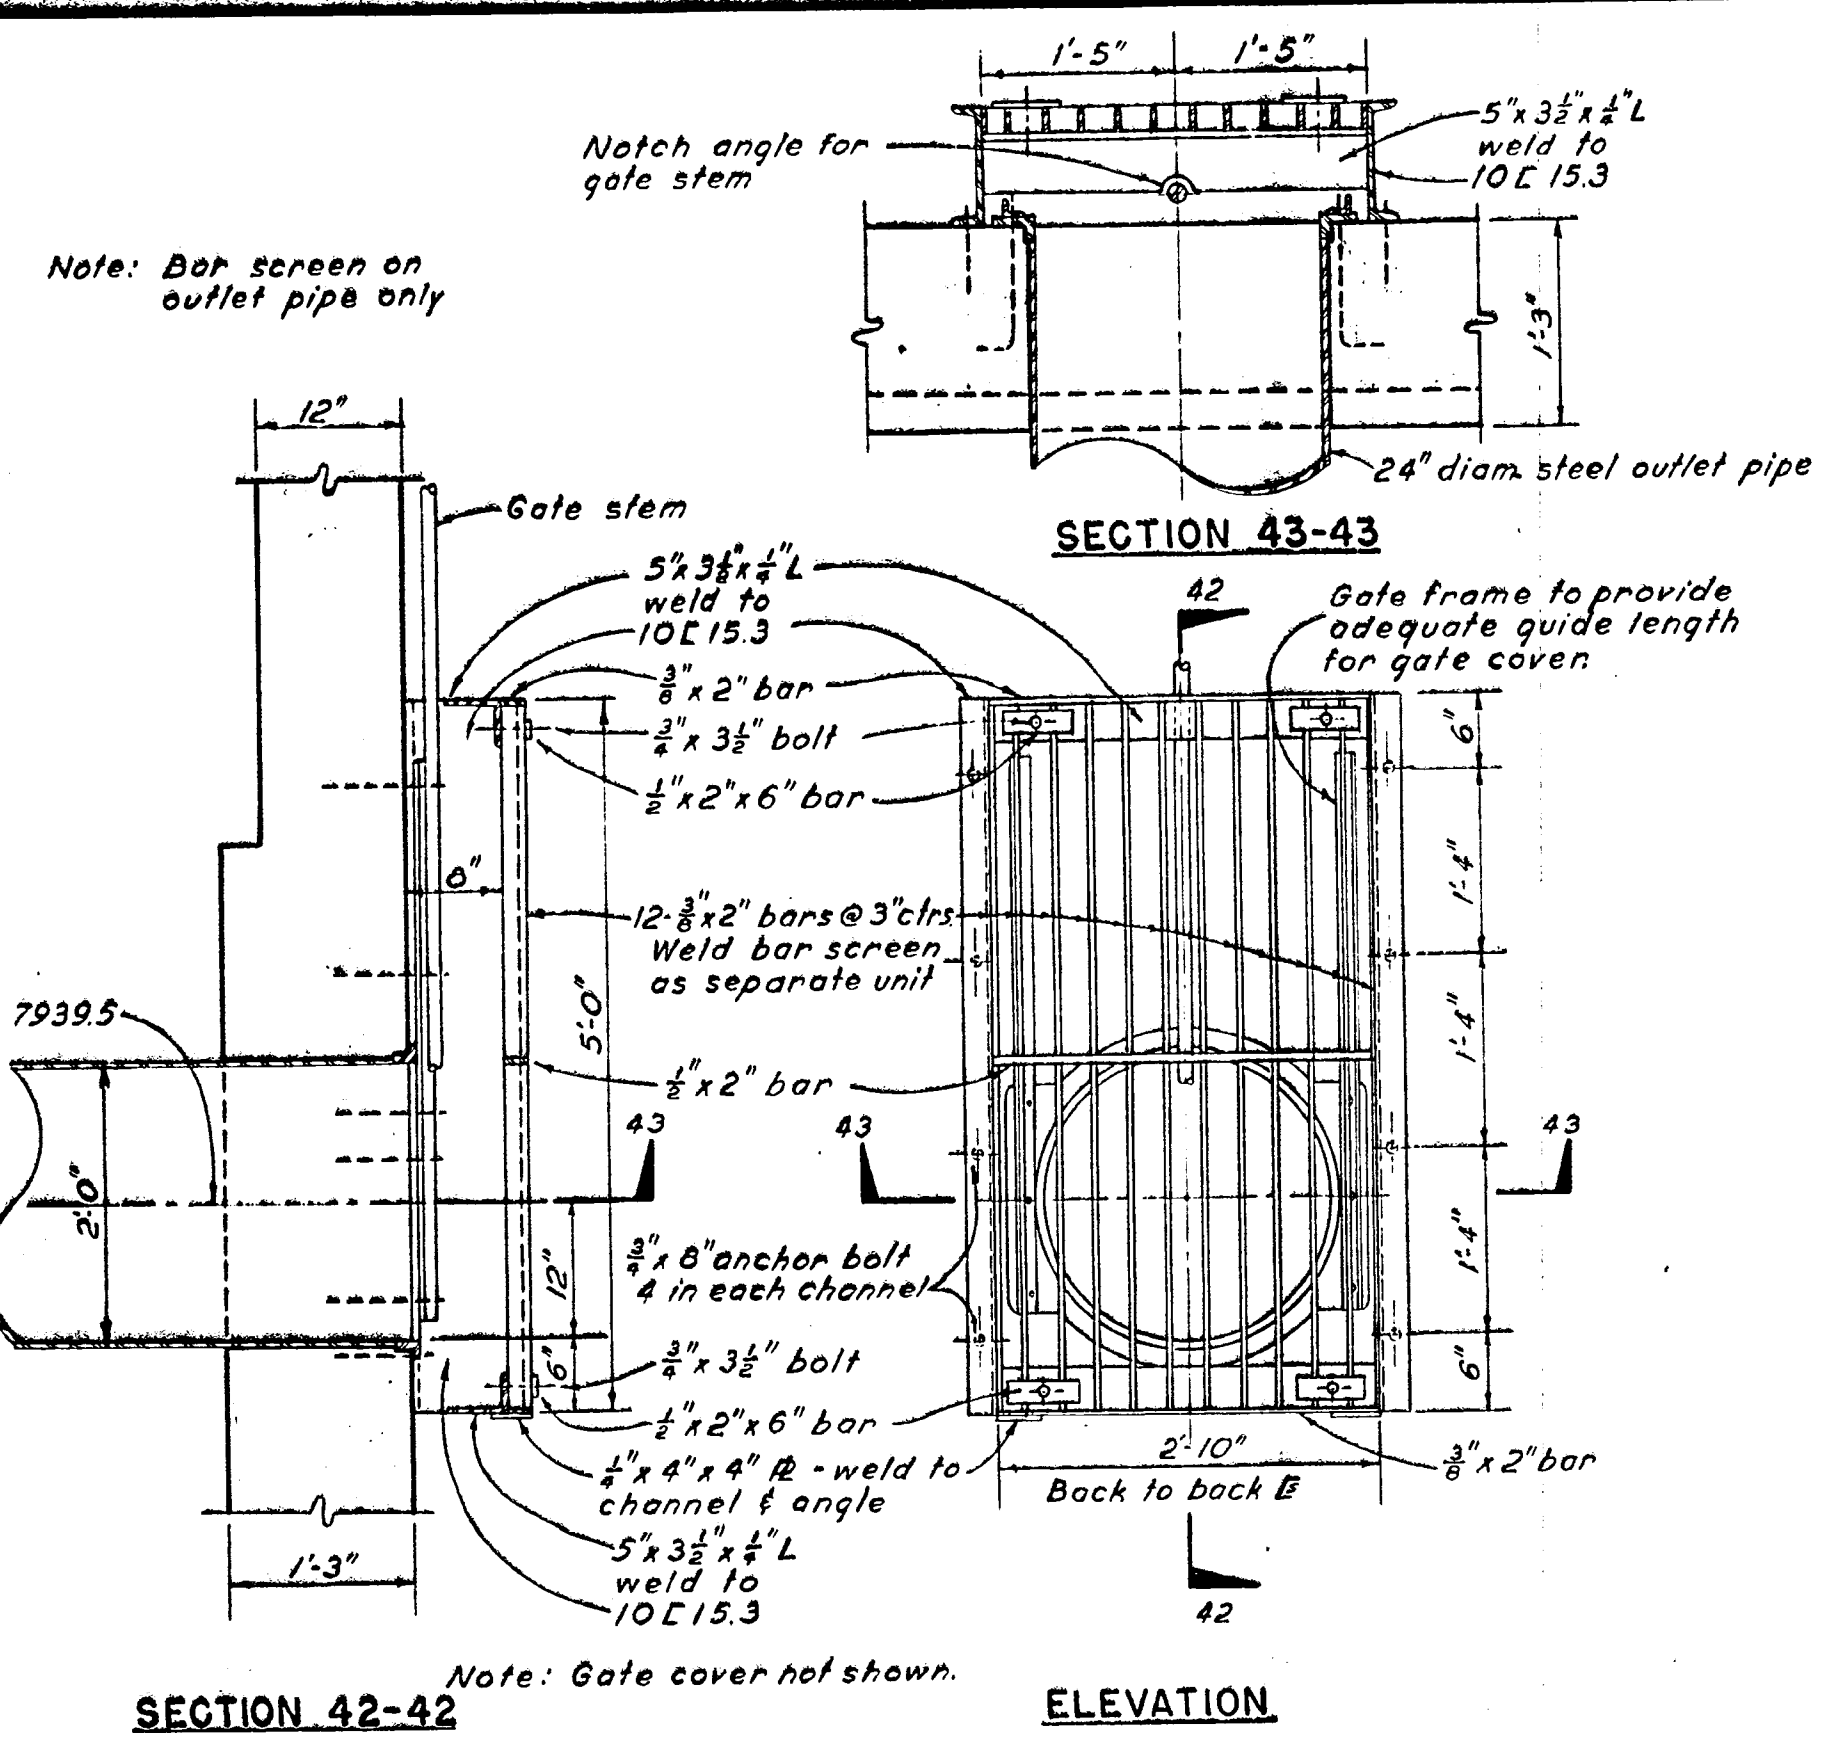

WING WALL ELEVATIONS

Scale: 1/2" = 1'-0"

TYPICAL WALE DETAILS

SECTION 63-63

SECTION 64-64

Scale: 1/2" = 1'-0"

I HEREBY CERTIFY THAT THESE PLANS FOR THE CONSTRUCTION OF THE LAKE GEORGE DIVERSION DAM WERE PREPARED UNDER MY DIRECT SUPERVISION FOR THE OWNERS THEREOF.

W. B. Veatch
(REGISTERED ENGINEER)

SUBSCRIBED AND SWORN TO BEFORE ME THIS 2nd DAY OF July, 1952.

W. B. Veatch
(NOTARY PUBLIC)

MY COMMISSION EXPIRES ON THE 12th DAY OF January, 1953.

THESE PLANS FOR THE CONSTRUCTION OF THE LAKE GEORGE DIVERSION DAM ARE HEREBY APPROVED AND ACCEPTED BY THE CITY OF COLORADO SPRINGS, COLORADO (OWNER).

W. B. Veatch
MAYOR

APPROVED ON THE 30th DAY OF July, 1952.

W. B. Veatch
STATE ENGINEER

FILE NO. _____ DEPUTY _____

LAKE GEORGE DIVERSION DAM

IRRIGATION DIVISION NO. 1 WATER DISTRICT NO. 25

PARK COUNTY

COLORADO SPRINGS, COLORADO

WATER SUPPLY DEVELOPMENT

MISCELLANEOUS DETAILS

BLACK & VEATCH

CONSULTING ENGINEERS, KANSAS CITY, MO.

DESIGNED BY *W. B. Veatch* CHECKED BY *W. B. Veatch*

DETAILED BY *W. B. Veatch* APPROVED BY *W. B. Veatch*

TRACED BY *W. B. Veatch* DATE *7-2-52*

C-617

ATTACHMENT 3

FISHING PIER AS-BUILTS (10 SHEETS)


FOR INFORMATION ONLY, SITE CONDITIONS MAY VARY



DRAWINGS FOR PROPOSED

NAME _____

PROJECT LOCATION

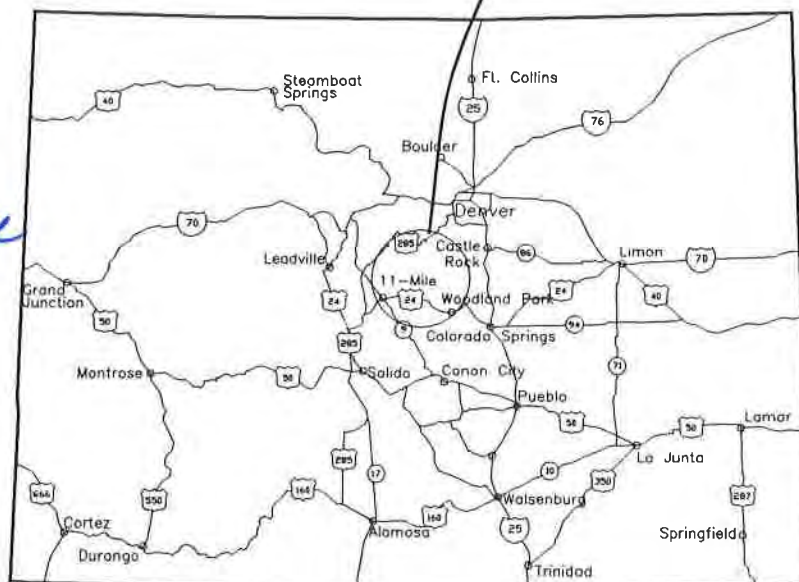

KEY MAP OF COLORADO SHOWING LOCATION OF PROJECT

PREPARED BY:

CIVIL ENGINEER

DATE _____

FOREST ENGINEER

DATE _____

DISTRICT RANGER

DATE _____

total sq yardage
of fuel.




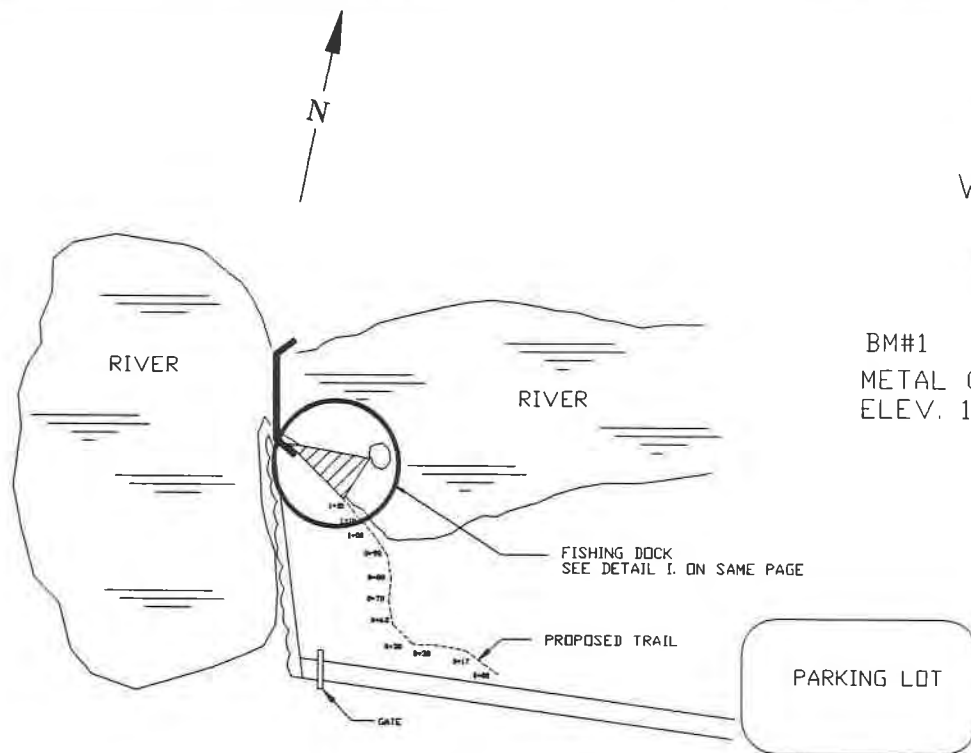


FIGURE 1. PLAN VIEW OF ELEVEN MILE FISHING DOCK SITE

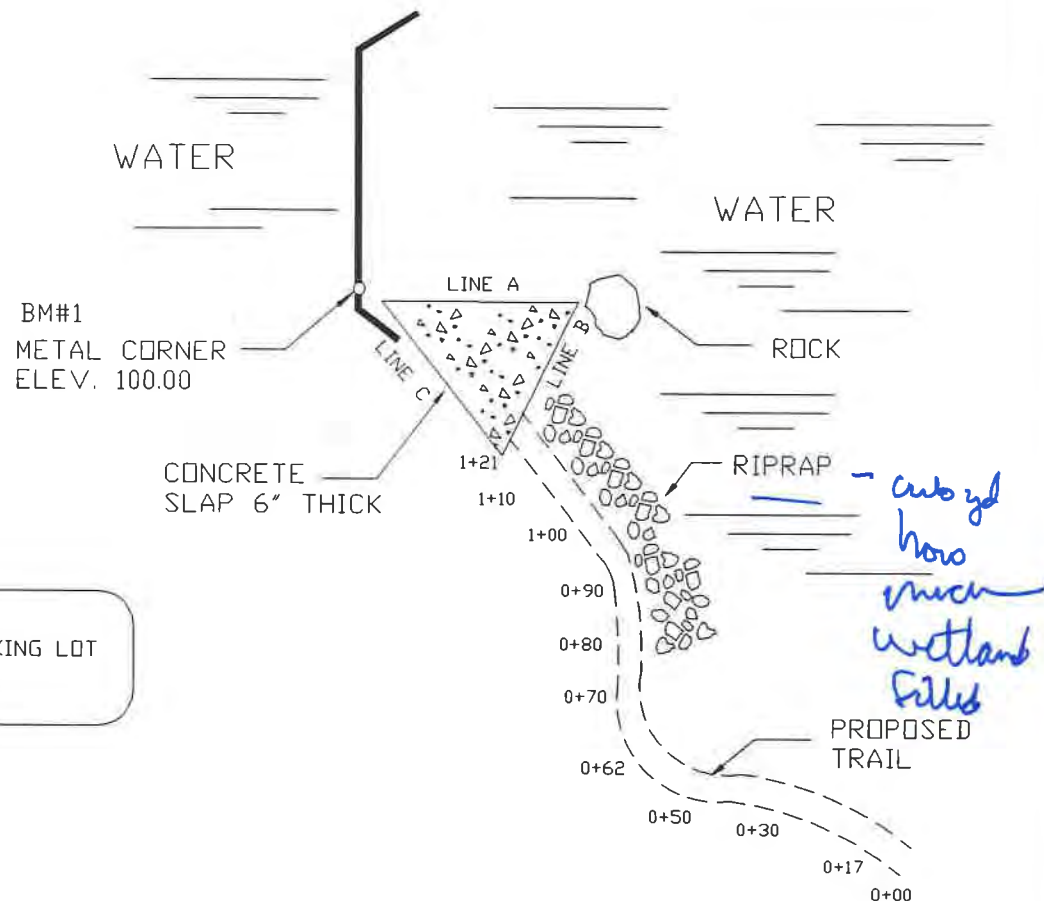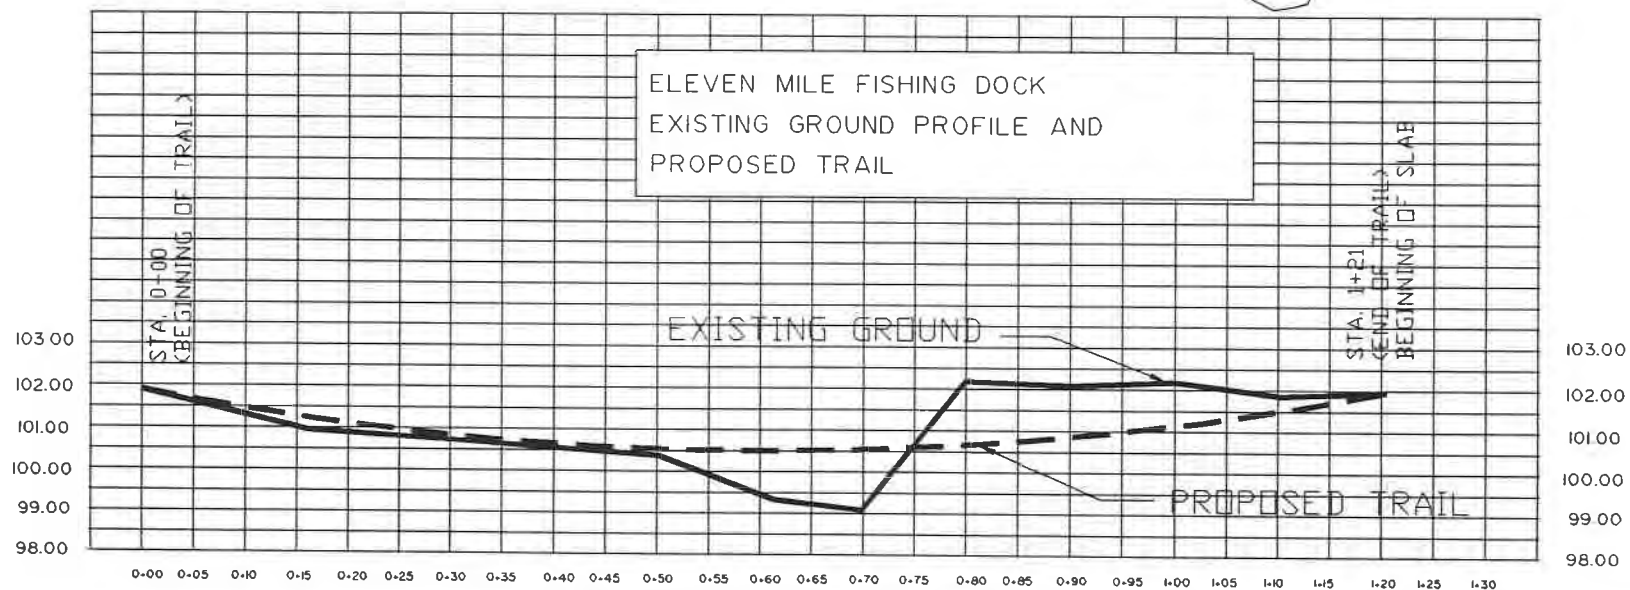

DETAIL I. PLAN VIEW OF PROPOSED TRAIL & CONCRETE FISHING DOCK

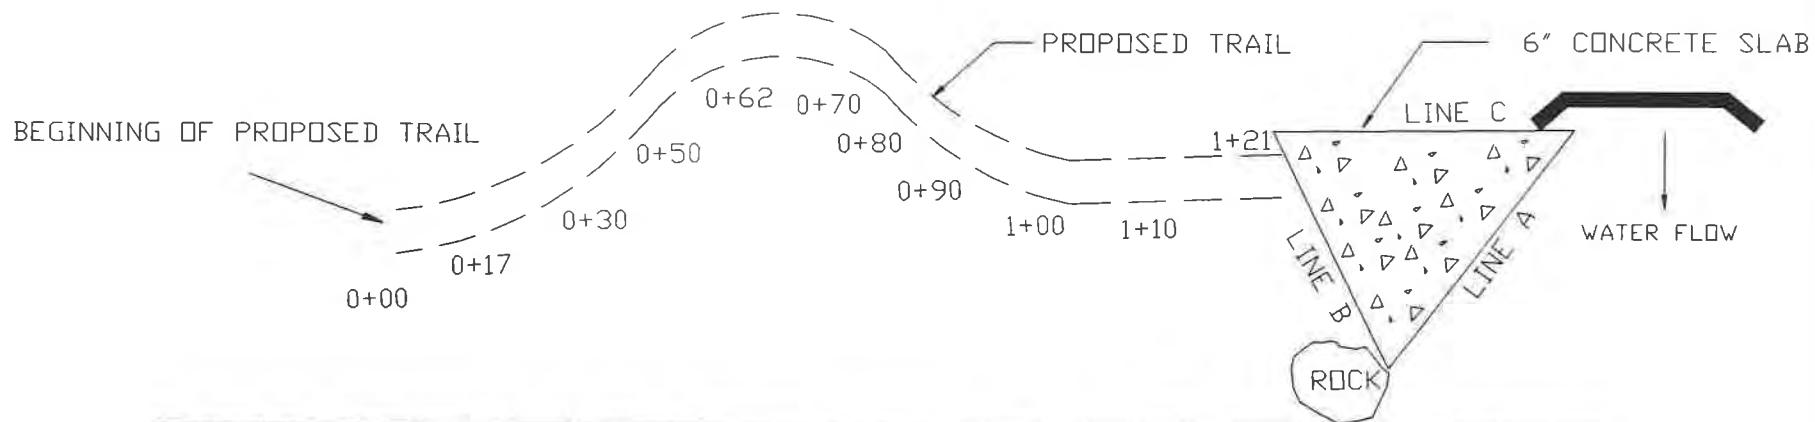


U.S. DEPARTMENT OF AGRICULTURE
FOREST SERVICE
R-2
ROCKY MOUNTAIN REGION


Drawn: M. GURULE
Design: M. GURULE
Checked: _____
Reviewed: _____

Forest: PIKE NATIONAL FOREST
Project Name: ELEVEN MILE FISHING DOCK


Sheet Title: D-2
PLAN/PROFILE/TRAIL
Scale: NO SCALE
Sheet: 3 of 10

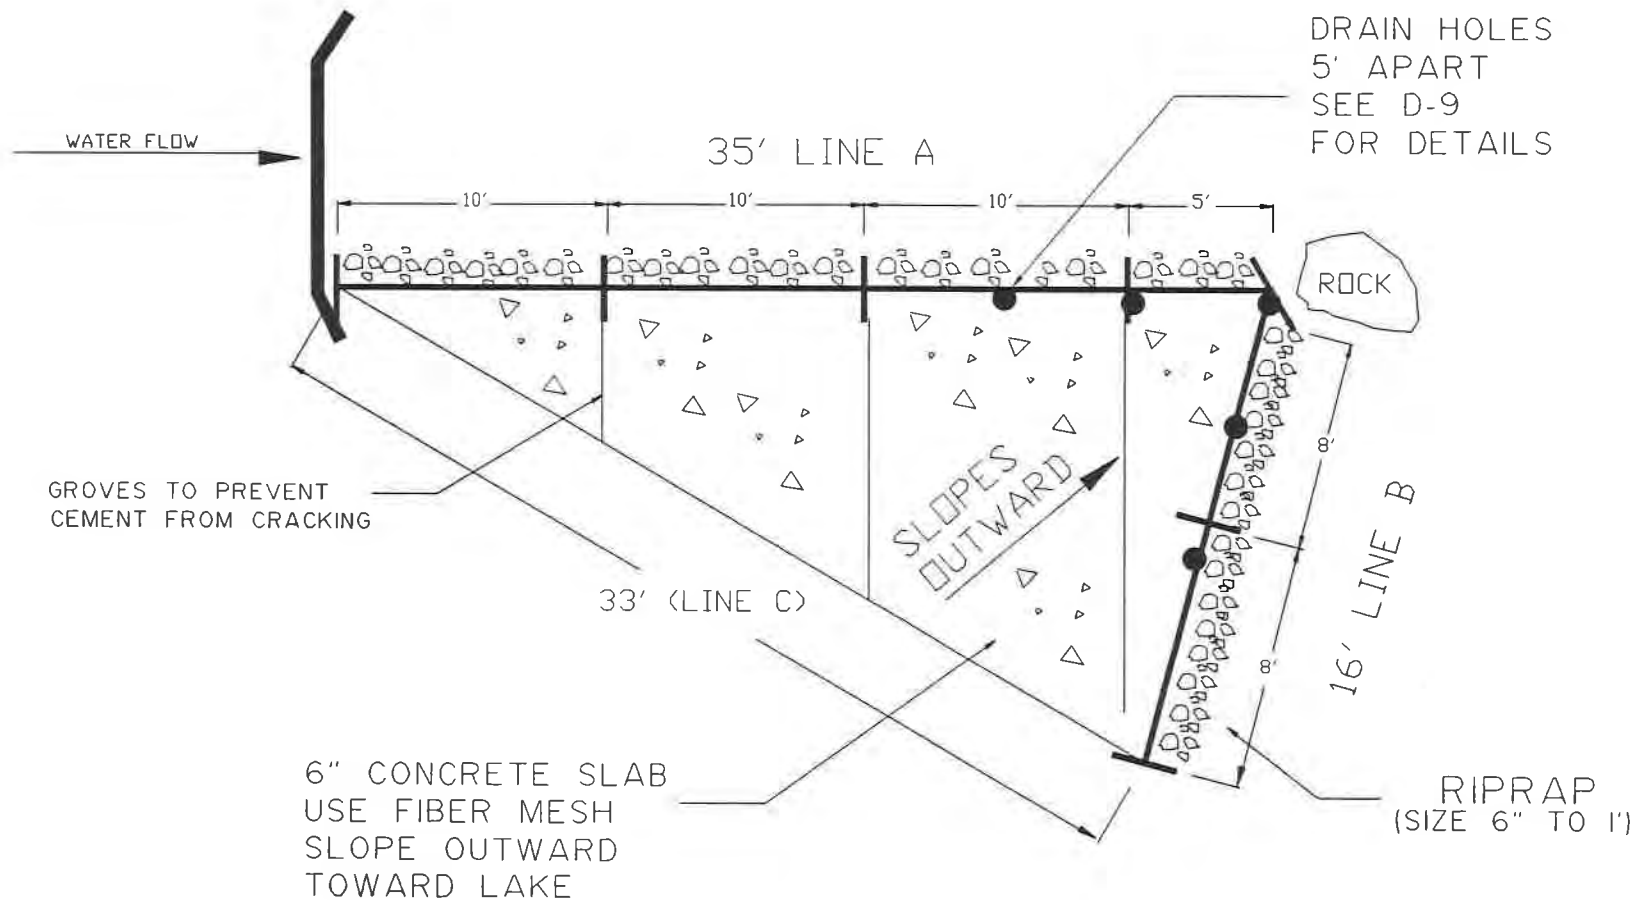


PLAN VIEW OF SLAB
(NOT TO SCALE)

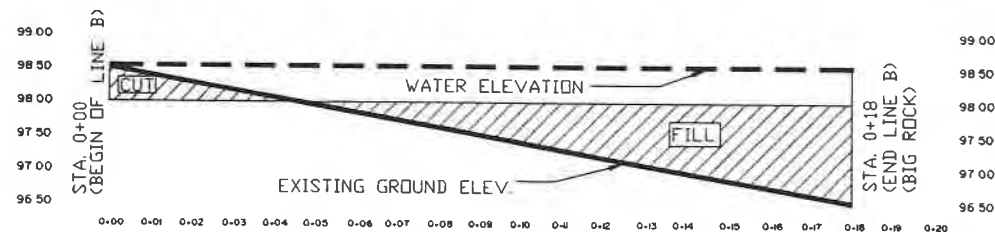

PROFILE OF LINE B
(DIFFERENT VERTICAL SCALE THAN PROFILE OF SLAB)

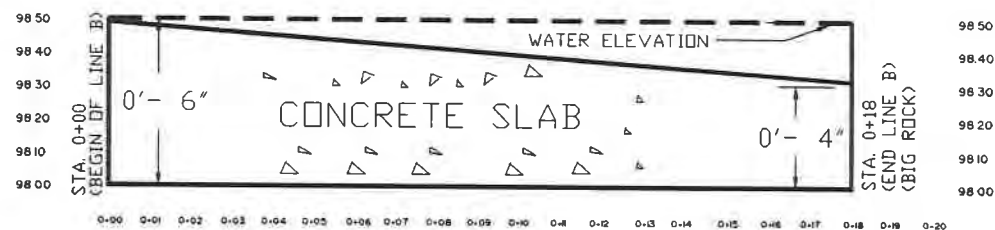


PROFILE OF CONCRETE
(DIFFERENT VERTICAL SCALE THAN PROFILE LINE B)

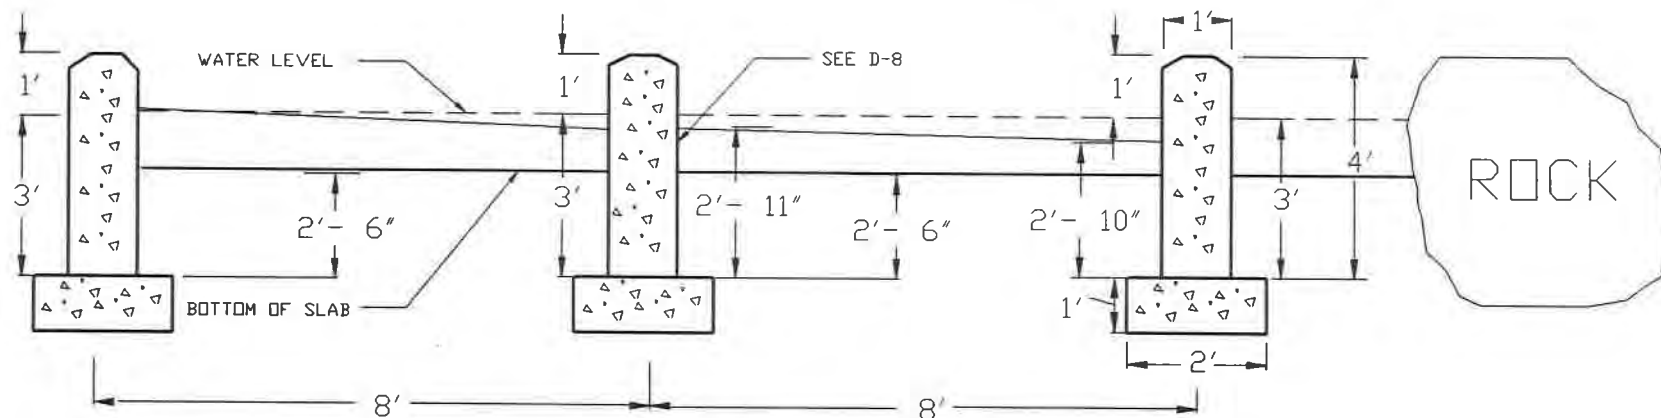


PROFILE OF FOOTERS FOR LINE B


(NOT TO SCALE)

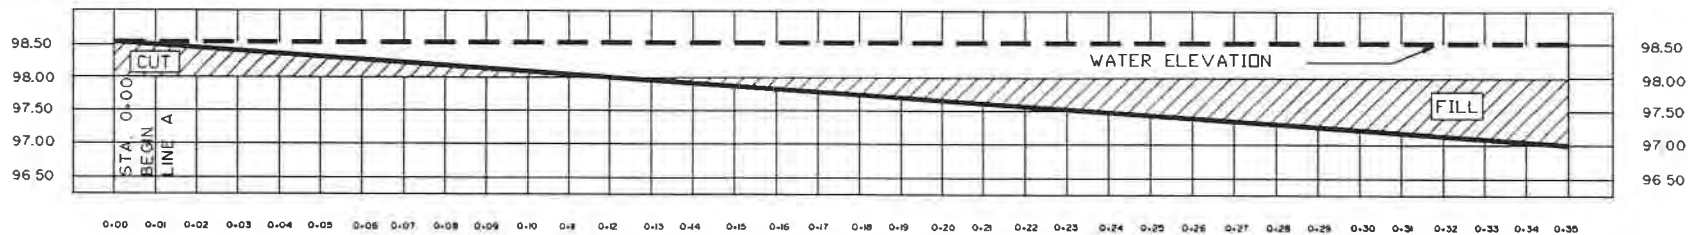


PROFILE OF LINE A
(DIFFERENT VERTICAL SCALE THAN PROFILE OF SLAB)

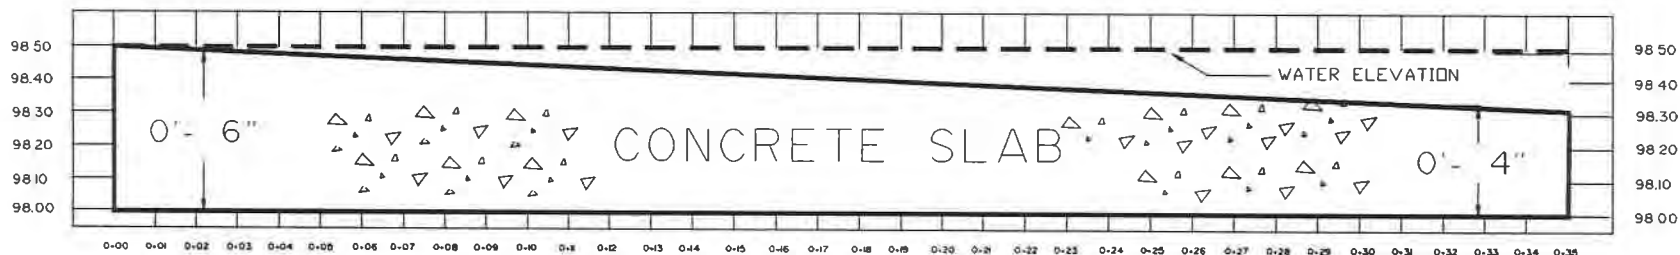


PROFILE OF LINE A
(DIFFERENT VERTICAL SCALE THAN PROFILE OF LINE A)

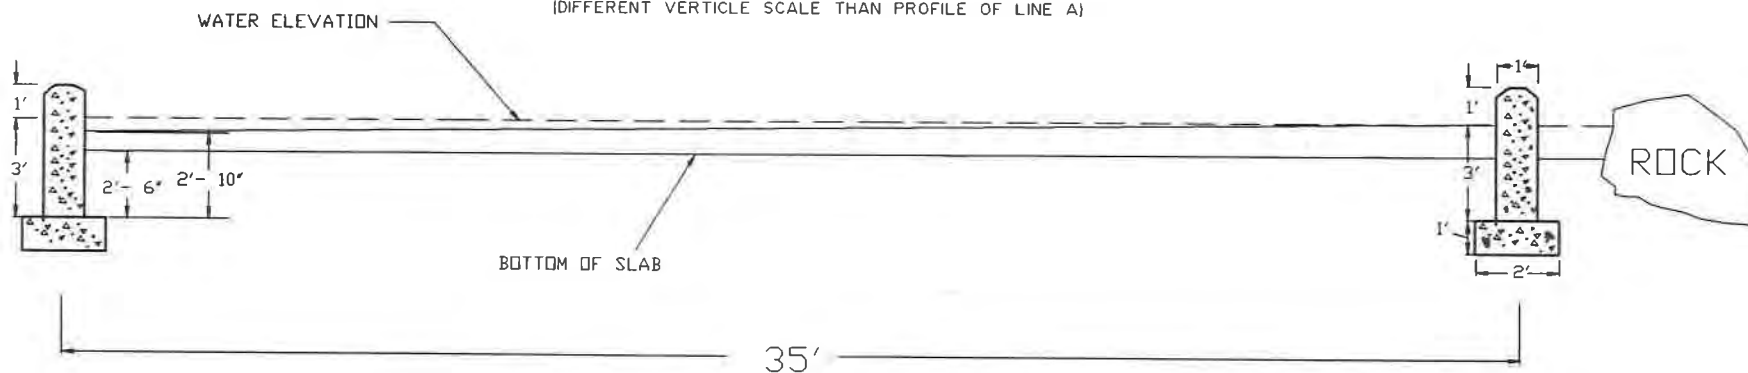


FOOTERS FOR LINE A
(NOT TO SCALE)

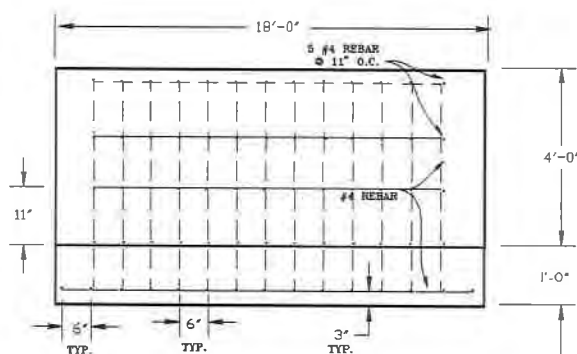

FOOTING/PIER
PROFILE FOR LINE B

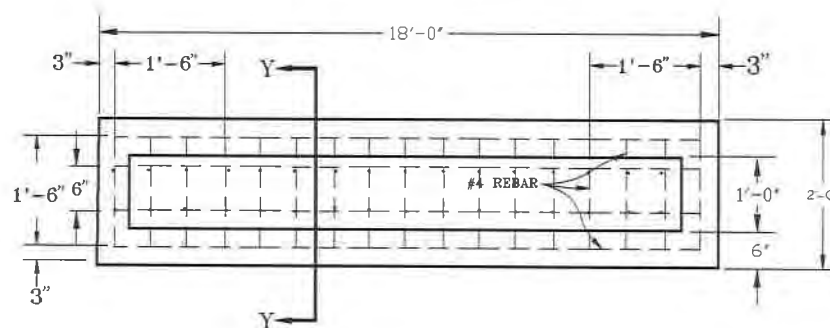

FOOTING/PIER
PLAN FOR LINE B

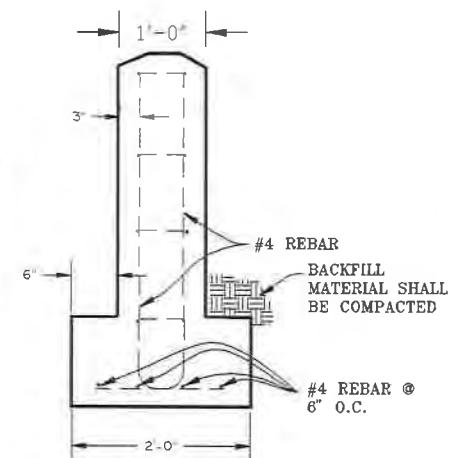

SECTION Y-Y


FISHING DOCK FOOTING/PIER PLAN AND PROFILE

U.S. DEPARTMENT OF AGRICULTURE
FOREST SERVICE
R-2
ROCKY MOUNTAIN REGION


Drawn M. GURULE
Design M. GURULE
Checked
Reviewed

Forest PIKE NATIONAL FOREST
Project Name ELEVEN MILE FISHING DOCK


Sheet Title D-8
FOOTING/PIER PLAN/PROFILE
Scale NO SCALE
Sheet 9
of 10

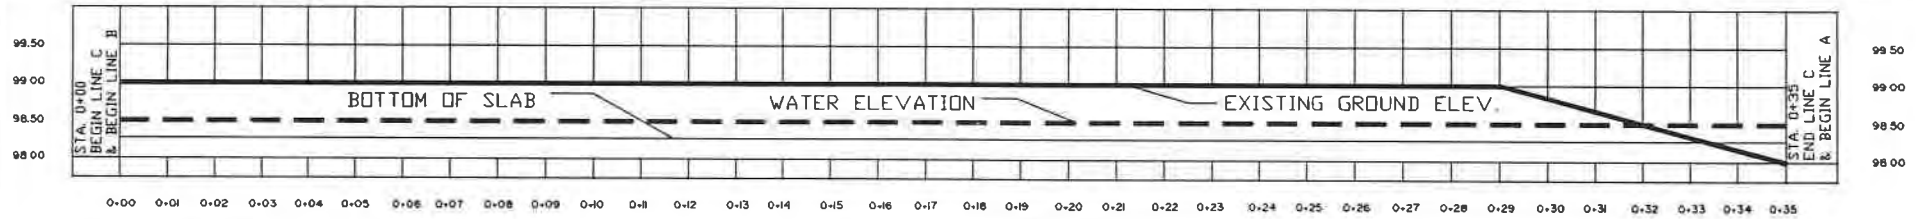

PROFILE OF LINE C
(DIFFERENT VERTICLE SCALE THAN PROFILE OF SLAB)

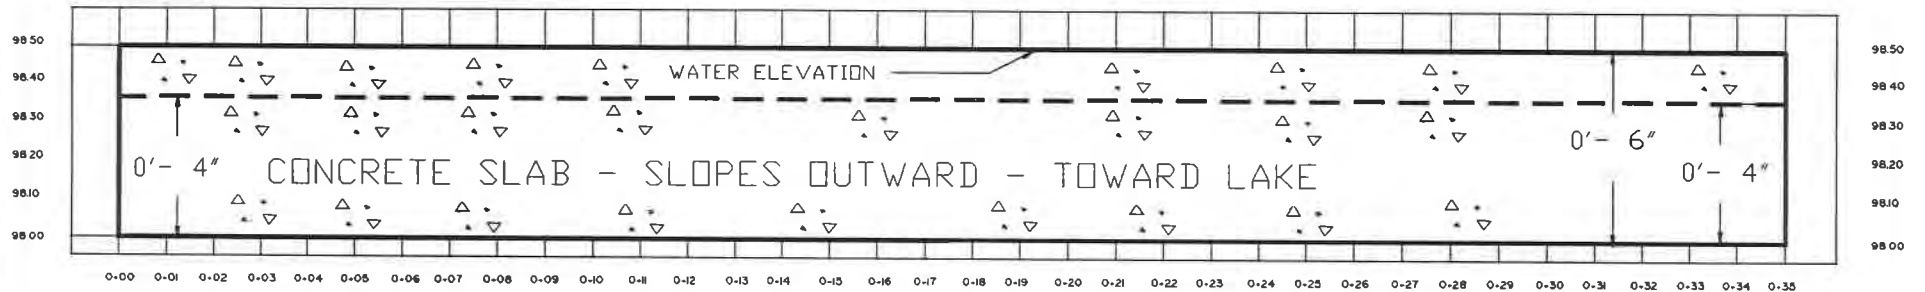

PROFILE OF SLAB
(DIFFERENT VERTICLE SCALE THAN PROFILE OF LINE C)

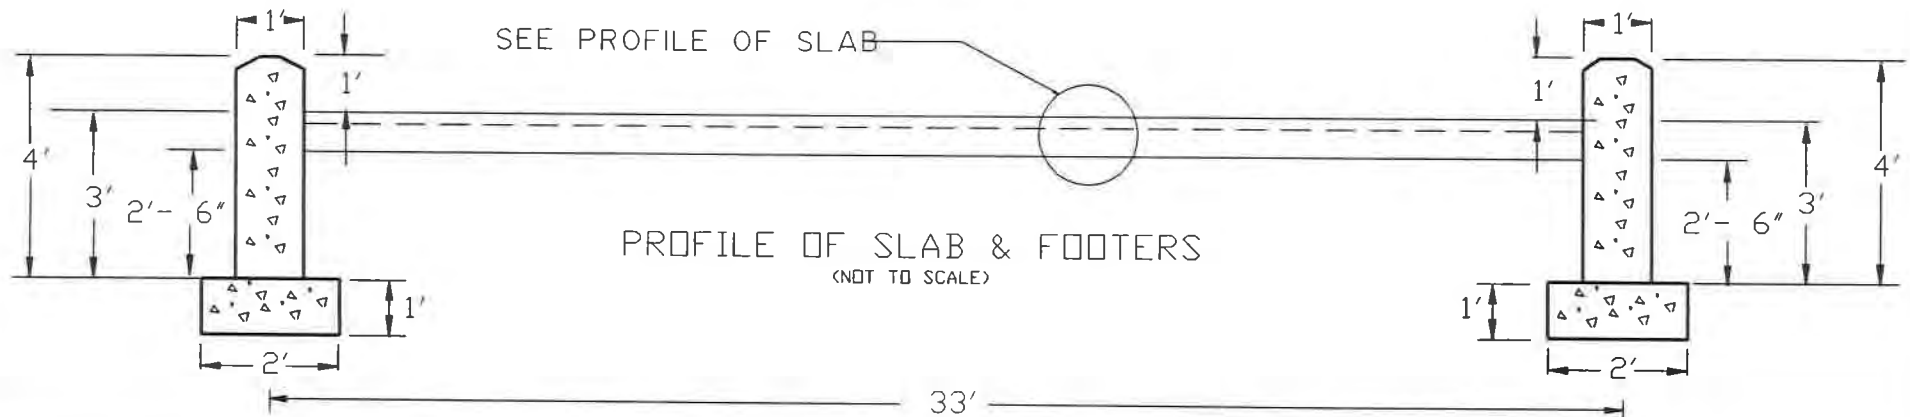


U.S. DEPARTMENT OF AGRICULTURE
FOREST SERVICE
R-2
ROCKY MOUNTAIN REGION


Drawn: M. GURULE
Design: M. GURULE
Checked:
Reviewed:

Forest: PIKE NATIONAL FOREST
Project Name: ELEVEN MILE FISHING DOCK


Sheet Title: D-7
PROFILE/PROPOSED/LINE C
Scale: NO SCALE
Sheet: 8
of: 10

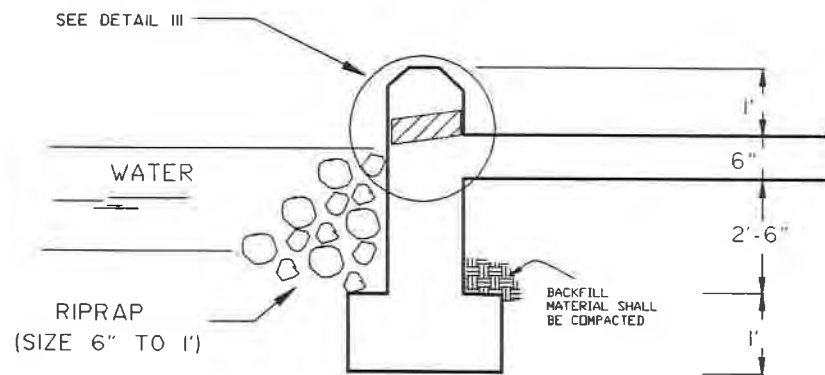


DETAIL I. CROSS-SECTION OF FOOTER & SLAB

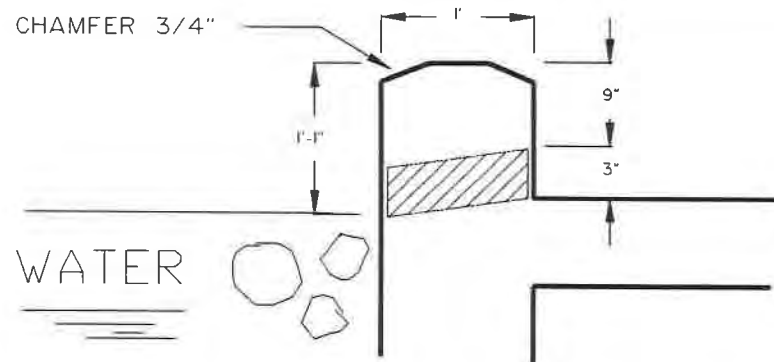

DETAIL III. CROSS-SECTION OF DRAIN PIPE

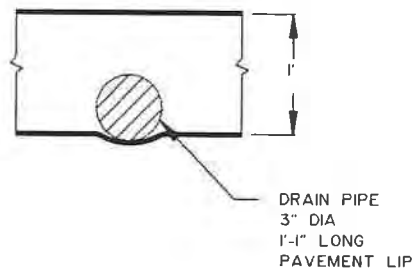

DETAIL II. FRONT VIEW OF DRAIN PIPE

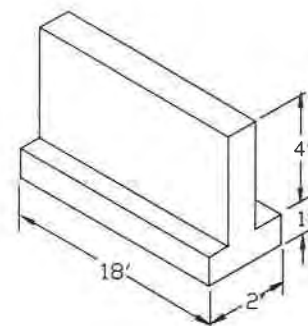

DETAIL IV. ISOMETRIC OF FOOTER FOR LINE B

NOTE: DRAIN PIPES INSTALLED EVERY 5' REFER TO D-4

