

SOUTH PLATTE RIVER RESTORATION PROJECT: HAPPY MEADOWS & SPORTSMEN'S PARADISE

Final Report 2012

PROJECT SUPPORTERS

This project is the result of hard work and committed support from many individuals and agencies.

Our thanks go out to all our partners, including our funding and implementing partners.

Aurora Water Department

Coaltion for the Upper South Platte

Colorado Department of Public Health & Environment 319 Nonpoint Source Program

Colorado Parks & Wildlife

Colorado Water Conservation Board

Denver Water Board

Park County Land & Water Trust Fund

South Platte Enhancement Board

Sportsmen's Paradise

U.S. Forest Service Pike National Forest

Our Contractors:

Fin-Up Habitat Consultants Crane Associates, LLC Chapparel Construction

The hundreds of volunteers who helped, including:

Catamount Institute Yes Clubs Colorado College Cripple/Creek Victor School Fountain Valley School Trout Unlimited — Cheyenne Mountain & Cutthroat Chapters Woodland Park High School — Environmental Science Class

Special thanks goes to the following Individuals: With CUSP:

Jonathan Bruno, Carol Ekarius, Lisa Patton, Theresa Springer

With the Pike National Forest

Dana Butler, Denny Bohon, Sara Mayben, Kris Sexton, Mike Welker

With Sportsmen's Paradise

Eric Hendrickson, Dennis Linn, Rob Nuss, Tedd Stiles, Matt Walter and Bob Winckler

All the partners are especially proud of the fact that this project won the U.S. Forest Service's Rise to the Future Award. This is the top annual recognition that the Forest Service gives to any project around the nation related to aquatic fisheries. This distinction is shared by all those entities, organizations, and individuals who helped make the project happen!

Note: This publication is available for free on Apple iBooks with interactive features not provided in the PDF version.




1

BACKGROUND

The South Platte Habitat Restoration Project worked on both Pike National Forest lands and private lands of the Sportsmen's Paradise HOA. This was a large-scale project that took several years of planning prior to implementation, and due to river flows and regulatory requirements, took two years for implementation. Planning began in 2007. The partners implemented part of the project in August of 2011, and wrapped up the remaining work in September of 2012. The project begins about 2.5 miles NW of the town of Lake George, Park County, CO, and covers approximately four miles of river. The river is accessible by Park County Road #112, which follows the river throughout the reach on the left (west) bank. The project area is bounded by private property and USFS lands. The upstream reach, designated Reach 22, is located on U.S. Forest Service under management by the Pike & San Isabel National Forests, Cimarron & Comanche National Grasslands, specifically under the management of the South Park Ranger District. The downstream reaches, Reach 20 & 21, are located on private lands immediately downstream of the USFS Happy Meadows Reach. The specific location is seen on the map at right.

The Happy Meadow's/Sportsman's Project was a river restoration and streambank/upland stabilization project that was designed to reduce adverse effects caused by excessive sediment. This segment (designated as 1A of the South Platte River, or COSPUS01A, by the Colorado Department of Public Health & Environment Water Quality Control Division), was identified in Colorado's 303d list of impaired waters that fail to meet water quality standards. In the case of segment 1A, the listing was specifically for failure to meet the State's narrative standard for sediment, which has resulted in the segment's failure to support its "Aquatic Life Cold 1, Recreation 1a,

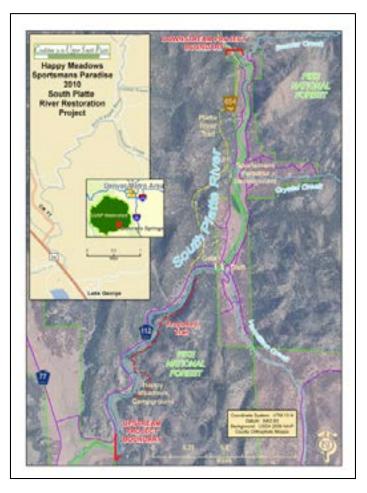

Water Supply, and Agriculture" designations. A planning process that was spearheaded by the State Health Department resulted in the creation of a TMDL, or Total Maximum Daily Load plan, for the river through this area in 2002 to address the elevated sediment pollution; however, the 2002 Hayman Fire, which added significantly increased sedimentation within this stretch, occurred after the TMDL was completed. The TMDL identified roads, campgrounds, picnic areas, livestock grazing, and other disturbed areas as the pre-fire concerns that were causing the river to not meet its water quality targets.

The river area addressed in this project was aggrading, or storing the excessive sediment within the channel. This caused significant channel migration with increased bank erosion, increased bed deposition, loss of substrate habitat (or pebbly eral large gullies had formed on the large alluvial fans, or natural drainages above the river, on the burned side of the river. These gullies were contributing significant quantities of sediment to the reach, dramatically effecting habitats and water



Overwidening of river, shown above, left, in a pre-project photo. Note on the photo at right, the channel has been narrowed by rebuilding the right bank, and a log and rock j-hook vein concentrates the energy of the river in the middle of the channel to protect the banks.

and small rock features on the bottom of the channel that are crucial for trout reproduction) and loss of riparian vegetation. Shifting fine and coarse materials were prominent over much of the stream substrate. The area at the boundary of the Forest Service and the private lands was affected by a large low-head diversion structure, or dam, on the Sportsman's Paradise property that caused dramatic overwidening the river and excessive deposition of sediment on the National Forest portion immediately upstream of the dam. It also caused the river to threaten the adjacent road with significant bank failure. Additionally, sevquality throughout the project area.

The project, which was spearheaded by the Coalition for the Upper South Platte (CUSP) and staff of the Pike National Forest. CUSP is a nonprofit watershed group that works in and around the 2,600 square mile Upper South Platte Watershed. We work to bring a wide variety of partners together to complete projects across property boundaries.

This project was designed to:

1. Reduce sediment entering the river.

2. Improve geomorphology so that the river both moves and stores sediment in a more appropriate manner. 3. Improve habitat for fish, benthic community, and other species, including birds and mammals.

4. Increase trout production within this stretch of river.

5. Provide aquatic species passage (currently blocked by the Sportsman's Paradise diversion).

6. Develop restoration design concepts and alternatives that meet broad constituent objectives while meeting environmental goal.

7. Coordinate, with partners, all restoration implementation objectivesenvironmental goals.

8. Measure the effectiveness of restoration in achieving environmental goals.

9. Account for and report on all project functions. We accomplished the goals we set forth, and more, but we'll use the words of U.S. Forest Service Regional Aquatic Biologist, Dave Winters (who was not part of the project team) to describe the overall outcome:

Last Friday I drove to Happy Meadows to see the restoration efforts that Pete Gallagher [CUSP's Contractor from Fin-Up Habitat Consultants] and his staff have been working on this summer. It was their last day and I got a tour of the 4.5 mile project that was funded by numerous partnerships. This is the most thought out and successful project of it's kind I have seen. The South Platte River has been damaged throughout most of it's length due to highly fluctuating flows from upstream reservoirs. The result has been an over-wide, sand bed chan-






The channel behind the dam at Sportsmen's caused significant overwidening as seen above left. This threatened the road. Post project (above right), the channel is narrowed through backwater area of old dam, and has a meander bend. nel with very little habitat for trout and other aquatic animals in this section. In addition to the Forest Service land, a private "Home Association" called Sportsmen's Paradise also received the benefits of this effort. I suspect that in 1 year people will not be able to recognize the changes in stream morphology, revegetation and habitat work that was successfully completed throughout the section. In addition, a channel crossing diversion dam that was blocking upstream movement of fish was removed and barriers were placed to keep vehicles out of the riparian areas. Word has gotten out, as there were several anglers already taking advantage of the work (I saw 3 trout caught while I was there). Anglers are seeking high quality waters like this, and the local economy will no doubt benefit greatly.

Plans are to continue this effort in the historic South Platte River where there was once a train called the "Fish train" that dropped fisherman off throughout it's mountainous length. I've attached a few of the photo's I took, but they really don't do justice to the work that was completed in less than 4 months of actual construction time. It seems like we should have some kind of celebration!







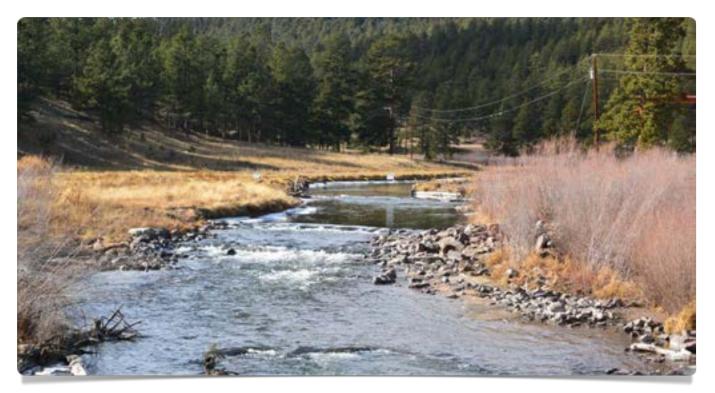

Looking upstream where the dam once blocked the river.



2

PROJECT IMPLEMENTATION

Construction began in early September, 2011, with the removal of the low-head dam & diversion structure at the USFS / Sportsmen's Paradise Property boundary. The dam was removed in segments to limit sediment movement downstream and to maintain the bed elevation upstream. The structure was replaced by three large boulder cross-vanes spanning the full width of the channel along a three hundred foot length of river channel to tie upstream and downstream bed elevations together in a stable form, and to allow for aquatic organism passage through the segment. Once the channel bed sta-

bilization was completed, a new concrete headgate structure was built on the north side of the river immediately adjacent to the upstream most boulder cross-vane. In addition to the headgate structure, 270 feet of 24" HDPE pipe was buried on the left side of the river to connect the new headgate structure with the existing diversion ditch. The new diversion structure effectively delivers up to 10 cubic feet per second (CFS) to the ditch at base river flows of <100 CFS.

Following construction of the new headgate and diversion structure, habitat enhancement and channel realignment work commenced upstream along approximately 1,500 ft of Reach 22, the lower portion of the USFS Happy Meadows reach. The objective of this work was principally narrowing the river where it had become braided and overwidened as a result of sediments accumulating behind the low-head dam. Multi thread channels were closed and bankfull channel width was significantly reduced utilizing large wood and sedge mats to create new river banks throughout this segment. Pre-project width/ depth ratios of <100 were reduced to a range of 20-40 within the segment.

Once the short segment of Reach 22 was complete, the crews moved downstream to Sportsmen's Paradise Reach 21, beginning construction of habitat enhancements immediately below the former dam site, and progressing downstream. All of the remaining perennial channel work in Reach 21 was completed on September 29, just before the CPW spawning restrictions went into effect. An additional 4 days were then needed to complete work on the ephemoral draws on the east side of the river in the Happy





Meadows reach (Reach 22).

Top Photo: The dam at beginning of the project. Bottom Photo: New Cross-Vanes below prior dam are used to change elevation across approximately 1500 feet from old dam to existing channel, and to provide flow to the new headgate (photos on next page).








Construction of new headgate top two photos. New headgate at left.

stream. All of the remaining perennial channel work in Reach 21 was completed on September 29, just before the Colorado Parks & Wildlife (CPW) seasonal spawning restrictions went into effect. An additional 4 days were then needed to complete work on the ephemeral draws on the east side of the river in the Happy Meadows reach (Reach 22). Following the end of the spring trout hatchling restriction period in early June of 2012, the project recommenced with construction of habitat and channel features in the lower Sportsmen's Paradise Reach 20. As was done in the previous year, work began at the upstream boundary and progressed downstream. Reach 20 was completed in one month of work, with several delays due to high fire danger in the region that summer. Fortunately all inchannel work was completed before the Cities of Denver and Aurora need to move additional water downstream.

The final phase of construction, through the upper portion of Happy Meadows Reach 22, was undertaken at the beginning of September, 2012. By this time, fire danger had subsided in the region, and ideal flows of 70 – 90 CFS allowed for rapid completion of the remainder of the project. The remaining 2 miles of river restoration was completed on September 29, 2012, with equipment demobilized the following day.



A backwater pond created where the channel used to split provides habitat for birds, amphibians, mammals, and insects.

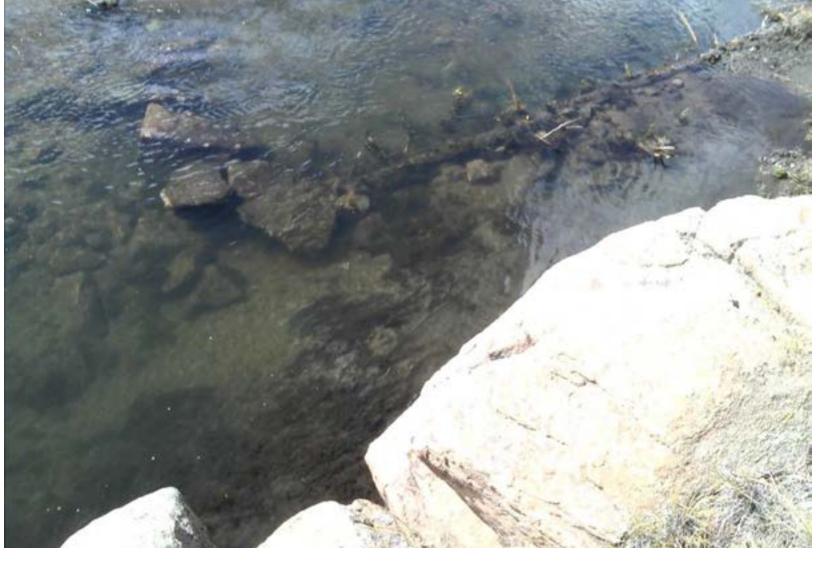

3

PROJECT ACCOMPLISHMENT

Over a period of slightly more than one year, over 4 miles of the South Platte River were enhanced for improved trout habitat and sediment transport. A significant barrier to aquatic organism passage was removed from the river, and a new "fish passage friendly" diversion structure installed in its place. In-channel habitat enhancements included incorporation of large wood into the channel in the form of log vanes, habitat trees, and bank full riparian benching. Boulder cross vanes, J-hook vanes and groins were installed to provide increased channel bed stability, velocity shelter, and habitat

complexity to the system. More than 1 ¹/₂ miles of river bank was realigned through bank full benching, sedge matting, and other bank treatments to effectively narrow the river, improving sediment transport and pool scour. Additionally, two major ephemeral draws on the east side of the river within the Hayman burn scar, were treated utilizing log "rock&roll" structures and other techniques to cut off the sediment supply to the river from these sources.

For the most part, construction followed the design outlined in CUSP's South Platte River Sportsmans Paradise & Happy Meadows River Assessment & Restoration Plan, 2011. Minor deviations from the plan were necessary from time to time due to changes in conditions between the time of the assessment (2006 – 2010) and implementation of the work in 2011 & 2012. For example, a few of the river banks identified early in the assessment as degraded or eroding had begun to recover before the project commenced in 2011. In this case, if the river bank was deemed to be recovering with a sufficient upward trend toward desired condition, we elected to leave the bank "as-is" rather than creating potential instability and disturbance as a result of construction activities.

The table below lists the habitat and channel features installed during the course of the project.

Treatment Type	Reach 20	Reach 21	Reach 22	Total
Full Channel Boulder Cross Vane	7	7	6	20
Full Channel 2x Log/Boulder Cross Vane	2	2	6	10
Boulder J-Hook Vane	5	5	11	21
Log/Boulder J- Hook Vane	9	9	15	33
Boulder Vane / Groin	1	6	3	10
Boulder Cluster	19	-	25	44
Habitat Tree	15	4	19	38
"Lunker" Cover Structure	-	-	2	2
Log "Rock & Roll" Vanes	-	-	14	14
Bank Full Riparian Benching in Feet	2,650	2,300	3,600	8,550
Total Large Wood (whole trees)	105	95	200	400

SOME THINGS CHANGE

There were four significant changes from the original design during the course of construction. Three changes were necessary in the Happy Meadows Reach 22, and one in Sportsmen's Paradise Reach 21. These changes, are documented below.

Treatments in the minor ephemeral draws entering the South Platte River from the southeast near the upstream boundary of Happy Meadows were dropped from the project due to the close proximity of a cultural heritage site to the construction area. Upon review with the USFS forest archeologist and forest hydrologist, we determined that the work could not be completed without significant disturbance to the historic site. Further assessment of the ephemeral draw upstream of the site indicated that the channel had down-cut to bedrock and was now stable, and would likely not continue to contribute excess sediment to the river. Additionally, the two habitat trees planned for the main-stem channel immediately upstream of this draw were dropped from the project because we could not get equipment past the cultural site to harvest the trees.

The original design called for closing the secondary channel on the west side of the river near the upstream boundary of Happy Meadows Reach 22. This would require re-alignment of several large boulders in the main channel near the upstream confluence of the 2nd channel in order to reduce near bank stress along the newly constructed channel closure. Unfortunately, these boulders have characteristics more akin to icebergs, and were too large for the equipment to move. After consultation with the USFS forest hydrologist, the design was altered to keep the 2nd channel. Two channelspanning boulder cross vanes were added to the 2nd channel to maintain bed elevation, preventing the river from eventually migrating into this feature

Two large full channel boulder cross vanes were dropped from the project in Happy Meadows Reach 22. These structures, one near Happy Meadows Campground, and the other near the Platte Springs trailhead were initially proposed in conjunction with foot bridges that would allow for construction of a new trail system on the east side of the river. The primary function of these cross vanes would be to provide protection for the bridge abutments and to provide fishviewing opportunity for recreation users. Funding for the bridges was never secured, and the new trail was eventually dropped from consideration for the current project. This trail and bridge system may be developed at some future date, and if so, these structures will need to be considered as part of the planning for the project at that time.

The large island immediately downstream of the existing roadway bridge near the upstream boundary of Sportsmen's Paradise was not removed due to the specific request of several members of the Sportsmen's Paradise Home Owners Association. This may have a very minor effect on sediment transport through this segment, but this area provides easy fishing for handicapped and youth anglers within their community.

As-built drawings have been completed for the project, and are included in the appendix at the end of the document. The as-built drawings begin at the upstream boundary of the project at the Happy Meadows USFS / private property boundary, and progress downstream through the Sportsmen's Paradise dam site to the down-stream boundary of the project, immediately below the confluence of Beaver Creek and the South Platte River at the northern Sportsmen's Paradise / USFS property boundary.



Photos: Cross vane reconstruction in Reach 20 before project & after project.



4

PROJECT MONITORING

For larger projects such as this, monitoring is an essential element from start, to finish, and beyond. Early monitoring is required for developing the plan. Initial postproject monitoring helps establish that the project was completed as intended. Finally, long-term monitoring provides a vehicle for continued learning and adaptation on future projects. These functions assure funders, government leadership, and area residents and visitors that this project, and others in the future, are worth the investment. The project reaches were and will be monitored to determine how proposed treatments affect stream stability and habitat compared to pretreatment conditions.

To measure the effectiveness of the proposed treatments for reducing sediment impacts, the monitoring objectives will seek to answer the following:

1. Did the percentage of unstable stream bank decrease after treatments?

2. Did the width to depth ratio of the stream decrease after treatments?

3. Did percentage of fine sediment decrease after treatments?

4. Did pool habitat increase after treatments?

5. Did stream stability ratings improve after treatment?

6. Did the percentage of stream bank with vegetation cover increase after treatments?

7. Did sediment transport capacity change after treatment?

8. Did benthic macro-invertbrate (insects that trout depend on for supper) abundance and diversity increase after treatments?

We began pre-project monitoring in 2009. As environmental education is an important aspect of CUSP's mission, and is generally supported by the federal and

Pre-Project Monitoring

state agencies we work with, we started the planning process by including students from the Woodland Park High School's Environmental Science class (primarily juniors and seniors) in initial assessment work.

The students assisted U.S. Forest Service and Colorado Parks & Wildlife aquatic biologists and hydrologists with gathering data that was necessary for the NEPA (National Environmental Policy Act) process, which is a planning-process step that must completed prior to working on federal lands, or to using federal funds on a project. As we would be doing both, the NEPA process was required.

Students helped the team as they gathered field data, including fish numbers, width to depth ratios, meander frequency, and vegetation data.

Our goals for this project included working with students in part so they would learn about:

1. How human activities—such as recreation, roads, livestock grazing, etc.—impact the ecosystem;

2. How to read USGS maps and use GPS units to gather data;



Students collecting cross-section data with U.S. Forest Service personnel.



A student collecting and recording mapping data.

3. How to identify species that indicate ecosystem health;

4. About what interventions must be used to correct ecosystem problems, such as sediment loading in rivers and invasive species on land; and

5. How to translate the data that they collected in the field into 3dimensional scaled-relief models by completing a model of a specific natural area within the USFS Pike National Forest.

6. We also had the students present their findings to the public and stakeholders as part of the public scoping process. The students learned these lessons, and more importantly, they learned life lessons they will carry with them in the future. Teacher Kendall Hovel of Woodland Park summarized it well in a follow-up email he sent to Congressman Doug Lamborn's staff member, John VanderMeulen (and cc'd us on). VanderMeulen attended the students' presentation for area elected officials, school officials, and other partners:

Thank you for attending the environmental science presentation on Wednesday. I'm sorry I didn't get a chance to speak with you before you had to leave, but I thought you posed an important question to the students, and I didn't feel you received a sufficient answer. It is an important question because these experiences can be 'fun,' as the students said, but if they aren't learning, then it does not have educational value. All too often we hear the phrase 'hands-on learning' when really what we are striving for is minds-on learning. I am convinced, however, that hands-on is a reliable way to achieve minds-on.

The students you saw Wednesday are not honors students. Some of them are just one bad choice away from expulsion or alternative education. They have come a long way this year, in large part because of this project. While it would have been nice if the students had responded to your question with some profound thoughts about hydrology or aquatic ecosystems or wildlife, I think the most valuable learning that took place will actually be realized in years to come. As their teacher I want them to learn about hydrology and biology, but I see the most valuable product of this project as the process the students went through. Students were guided through field investigations by professionals who conduct these studies on a daily basis.



Students present their findings during a scoping meeting to elected officials, school board members, government officials, and impacted residents.

They learned how to apply the scientific process in a new setting, which they were not familiar with. This is not important because I expect them all to enter into scientific careers where they can apply this experience directly, but because problem solving is so much like the scientific process that we could say they are one in the same. I expect every student in my class to encounter unfamiliar problems in their future, which they will need to solve. When the students who participated in the Happy Meadows project encounter problems in the future I expect them to have a sense that they can solve the problem and how they should go about it because they have 'been there and done that.'

The presentation itself was part of the learning process for them. I was reassured of this yesterday when I asked a student how he thought it went. This student had given me attitude the day before the presentation when I hassled him about preparing. When I asked him on Thursday how he thought it went, he humbly answered, 'I think I could have been more prepared.' Questions from professionals like yourself, which put them on the spot, helped them evaluate their own level of understanding, which is a skill I ultimately want them to have when they leave my class. Though it wasn't apparent Wednesday, I expect next time these students make a presentation they will be more prepared and professional without me having to hassle them to do so.

Again, thank you for making the effort to attend. I hope it was a valuable experience for you because I know it was for the students and myself.

Of course, not all monitoring was done by students. In 2008, 2009, and 2010 staff of CUSP, the Pike National Forest, and our contractors also collected pertinent pre-project data. Earlier monitoring data in these reaches was also gathered and reviewed.

Aquatic monitoring has been conducted by the US Forest Service throughout the Happy Meadows Reach 22, including basinwide aquatic habitat inventories (1993 & 2002), and extensive channel morphology surveys in 2006 and 2008. In 2009 and 2010, a rapid aquatic habitat and existing structure assessment and a channel morphology survey was conducted within the Sportsman's Paradise reaches by FinUp Habitat Consultants, Inc., and Crane Associates, contractors to CUSP, with assistance from a US Forest Service hydrologist, and volunteers from Sportsmen's Paradise. This information was utilized to develop the habitat assessment and enhancement plan.


Low gradient riffles were the dominant mesohabitat form in the Sportmen's reach 20, and comprised 46% of the wetted area of the reach. Pool habitats occupied 34% of the reach, with the remaining 20% comprised of poorer quality glides. Glide habitats were typically associated with disturbed areas and segments where previous habitat enhancement attempts had been undertaken by residents. River bank rock composition (BRC) was heavily dominated by gravel or smaller sized particles consisting mostly of decomposed granite. Given the composition of BRC in the reach, the stream banks in Reach 20 were relatively stable and well vegetated with sedge and willow. 12% of the east (right) river banks and 5% of the left (west) banks exhibited some signs of instability, and 330 feet of bank was found to be actively eroding materials into the river.

In Sportsman' Paradise Reach 21, low gradient riffles were once again the dominant mesohabitat form in the reach, and comprised 51% of the wetted area of the reach. Pool habitats were less frequent than in Reach 20, and occupied only 25% of the reach, with the remaining 24% comprised of poorer quality glides. As was the case in Reach 20, glide habitats were closely associated with disturbed areas. BRC was almost entirely dominated by gravel or smaller sized particles consisting decomposed granite. The stream banks in Reach 21 exhibited similar stability and vegetation characteristics to the reach downstream, and were relatively stable and vegetated with sedge and willow. 7% of the east (right) river banks and 15% of the left (west) banks exhibited some signs of instability, and 200 feet of bank was found to be actively eroding materials into the river. Most of the unstable left bank was directly associated with the fill slope forming the diversion ditch that feeds the lake on the west side of the reach.

Within Happy Meadows Reach 22, low-gradient riffles were once again the

dominant mesohabitat form in the reach, and comprised 51% of the wetted area of the reach. Pool habitats occupied 21% of the reach, with the remaining 28% comprised of poorer quality glides. River bank rock composition (BRC) was heavily dominated by gravel or smaller sized particles consisting mostly of decomposed granite. Given the composition of BRC in the reach, the stream banks in Reach 20 were relatively stable and well vegetated with sedge and willow. 16% of stream gage information to perform a flood frequency analysis. Annual maximum flows were determined from the monthly peak discharge information available for the South Platte River near Lake George (PLAGEOCO) gage operated by the Colorado Division of Water Resources.

The gage is located at latitude 38 54'19" and longitude 105 28'22", on the left bank approximately 700 feet downstream of Eleven Mile Canyon Reservoir.

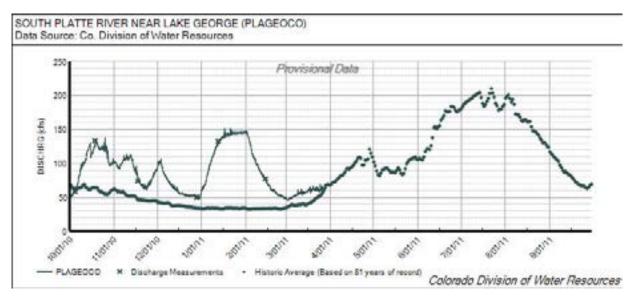


Example data set from Colorado Division of Water Resources for the gage at Lake George.

the east (right) river banks and 28% of the left (west) banks exhibit some signs of instability, and 2,950 feet of bank was found to be actively eroding materials into the river.

Hydrology & HEC RAS

The hydrology for the South Platte River at Happy Meadows was evaluated using

The contributing drainage area at the gage is 963 square miles and the gage has been operated continuously since October 3, 1929. However, the Eleven Mile Canyon Dam construction was completed in 1932, therefore the period of record used for analysis for this project is the post-dam period, 1932 to 2009.

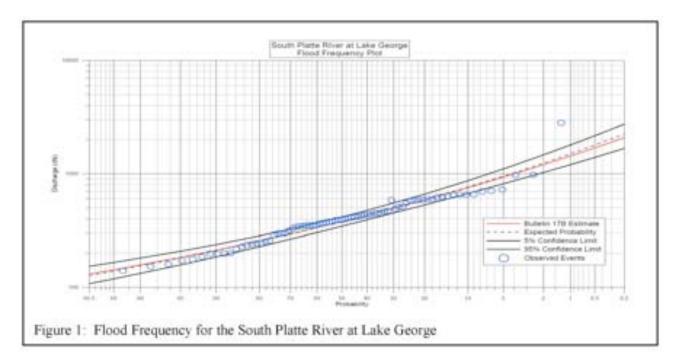

This program is based on the methods outlined in "Guidelines for Determining Flood Flow Frequency, Bulletin 17B of the Hydrology Subcommittee" of the USGS. This method utilizes a Log Pearson Type III distribution with a regional and stationweighted skew to evaluate peak flow data and perform the frequency analysis. The results of the analysis at the gage are summarized in Table 1 and shown in Figure 1 (next page).

The results are representative of flows at the gaging station. However, this is approximately 12.5 miles upstream of the project site. To determine flows at the Happy Meadows project, the following equation was applied: QT(u) = QT(g) (Au/Ag)x

Where QT(u) is the peak discharge in cfs at the ungaged station for the T year recurrence interval

QT(g) is the peak discharge in cfs at the gaged station for the T year recurrence interval


Au is the contributing drainage area for the ungaged station

Ag is the contributing area for the gaged station

X = the average exponent for drainage area for each flood region,

= 0.69 for the Mountains region

The equation and methodology are described in the USGS WaterResources Investigation Paper 994190 titled "Analysis of the Magnitude and Frequency of Floods in Colorado".

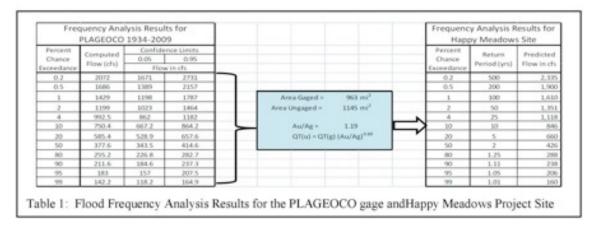

A HEC RAS sediment transport model has been developed for the project to verify the sediment transport goals of the design. HEC RAS prediction modeling is included in the Appendix.



Pre-project monitoring also included establishment of permanent cross-section analysis points (as seen in the map, lower left) that will be used for WARSSS and Hec RAS additional analysis in the future.

Benthic Macroinvertebrate Sampling

Benthic macroinvertebrate sampling was conducted by USFS personnel at three sites within the project reaches in September 2011. The sample sites consisted of cobble/gravel riffle habitats, and were sampled using a Hesse sampler with either a 50/50 or 33/33/33 sample split. Sample station SOPLAT01 was located near the upstream boundary of the project area. Sample station SOPLAT02 was located in the vicinity of the low head dam at the USFS / Sportsmans Paradise west property boundary, and sample station SOPLAT03 was located immediately upstream of the foot bridge at the Reach 20 / Reach 21 boundary in Sportsmans Paradise. A map of the sampling sites is shown on page 26.

Samples were sorted and analyzed by the BLM BugLab at Utah State University in Logan UT. Samples were assessed for species composition, abundance, density, and richness. A standardized species matrix present in the three sites is shown in the table below.

IAPPY MEADOWS / SPORTSMANS PARADISE PROJECT - SOUTI 2011				SAMPLE STATION			
Phylum	Class	Order	Family	OTUName	SOPLAT01	SOPLAT02	SOPLAT03
				Turbellaria	0	39	166
Annelida				Other_Oligochae ta	124	0	189
Arthropoda				Acari	124	0	331
Arthropoda	Insecta			Lepidoptera	136	79	674
Arthropoda	Insecta	Coleoptera	Elmidae	Optioservus	548	51	3146
Arthropoda	Insecta	Coleoptera	Elmidae	Zaitzevia	249	79	166
Arthropoda	Insecta	Diptera		Simuliidae	27709	7052	26358
Arthropoda	Insecta	Diptera	Athericidae	Atherix	0	0	166
Arthropoda	Insecta	Diptera	Ceratopogonidae	Ceratopogoninae	0	0	331
Arthropoda	Insecta	Diptera	Chironomidae	Chironominae	0	39	331
Arthropoda	Insecta	Diptera	Chironomidae	Orthocladiinae	17147	12092	35429
Arthropoda	Insecta	Diptera	Psychodidae	Maruina	0	0	166
Arthropoda	Insecta	Ephemeroptera	Baetidae	Acentrella	2248	1631	2980
Arthropoda	Insecta	Ephemeroptera	Baetidae	Baetis	5863	4396	13410
Arthropoda	Insecta	Ephemeroptera	Baetidae	Plauditus	2621	158	6126
Arthropoda	Insecta	Ephemeroptera	Ephemerellidae	Serratella	0	39	0
Arthropoda	Insecta	Ephemeroptera	Leptohyphidae	Tricorythodes	1615	0	6645
Arthropoda	Insecta	Ephemeroptera	Leptophlebiidae	Choroterpes	249	0	12
Arthropoda	Insecta	Plecoptera		Chloroperlidae	249	0	0
Arthropoda	Insecta	Plecoptera	Perlidae	Claassenia	35	0	0
Arthropoda	Insecta	Plecoptera	Perlodidae	Skwala	12	0	0
Arthropoda	Insecta	Trichoptera		Helicopsyche	124	0	0
Arthropoda	Insecta	Trichoptera	Brachycentridae	Brachycentrus	0	39	1490
Arthropoda	Insecta	Trichoptera	Brachycentridae	Micrasema	0	0	166
Arthropoda	Insecta	Trichoptera	Glossosomatidae	Culoptila/ Protoptila	1988	0	331
Arthropoda	Insecta	Trichoptera	Hydropsychidae	Cheumatopsyche	124	0	0
Arthropoda	Insecta	Trichoptera	Hydropsychidae	Hydropsyche	1600	338	2199
Arthropoda	Insecta	Trichoptera	Lepidostomatida e	Lepidostoma	124	0	331
Arthropoda	Insecta	Trichoptera	Leptoceridae	Oecetis	497	0	331
Mollusca	Gastropoda	Basommatophor a		Physa_Physella	0	0	166



An important point to note regarding the species matrix found in the sites include the absence of New Zealand Mud Snails (NZMS). NZMS have been identified as a noxious and exotic nuisance species in Colorado, and are present in the South Platte River a few miles upstream of the project reaches in Elevenmile Canyon.

STATION (NAMC)	SOPLAT01	SOPLAT02	SOPLAT03	
Area sampled (m^2)	0.26	0.18	0.26	
Field Split	33	50	33	
Lab Split	9.38	28.13	7.04	
Split Count	613	716	670	
Fixed Count	300	300	300	
Big Rare Count	44	19	13	
Richness*	17	8	20	
Abundance	76680	28493	111073	
Shannon's Diversity*	1.669756934	1.342617463	1.990509828	
Simpson's Diversity*	0.716343367	0.681939799	0.805774805	
Evenness*	0.589350935	0.645662518	0.664448504	
# of EPT Taxa*	11	4	10	
EPT Taxa Abundance	27041	7837	41470	
Dominant Family	Simuliidae	Chironomidae	Chironomidae	
Abundance of Dominant Family	29945	12447	36091	
Dominant Taxa	Simulium	Orthocladiinae	Orthocladiina e	
Abundance of Dominant Taxa	27709	12092	35429	
Hilsenhoff Biotic Index*	5.206666667	5.453333333	5.043333333	
# of Intolerant Taxa*	3	0	5	
Intolerant Taxa abundance	9366	118	4647	
# of Tolerant Taxa*	0	0	1	
Tolerant Taxa abundance	0	0	166	
USFS Community Tolerance Quotient (d)*	79	88	78	
# of shredder taxa*	2	1	3	
Shredder Abundance	124	0	497	
# of scraper taxa*	3	1	4	

Also, the samples appear to be dominated by filter feeders, which may indicate a nutrient issue previously unidentified from upstream (Winters, personal communication, 2013). A functional feeding analysis (Merrit & Cummims, 1996) may be necessary following the first post-project sampling effort to validate this concern.

STATION (NAMC)	SOPLAT01	SOPLAT02	SOPLAT03	
Scraper abundance	6287	288	10938	
# of collector-filterer taxa*	3	2	3	
Collector-filterer abundance	32912	8496	34351	
# of collector-gatherer taxa*	5	3	6	
Collector-gatherer abundance	35572	19342	62803	
# of predator taxa*	2	0	3	
Predator abundance	668	0	1159	
# of clinger taxa*	8	2	8	
Long-lived Taxa*	2	1	3	
# of Ephemeroptera taxa*	5	3	4	
Ephemeroptera abundance	20424	7014	31490	
# of Plecoptera taxa*	0	0	0	
Plecoptera abundance	792	0	0	
# of Trichoptera taxa*	6	1	6	
Trichoptera abundance	5825	823	9980	
# of Coleoptera taxa*	2	1	2	
Coleoptera abundance	1914	130	4636	
# of Elmidae Taxa*	2	1	2	
Elmidae abundance	373	39	1821	
# of Megaloptera taxa*	0	0	0	
Megaloptera abundance	0	0	0	
# of Diptera taxa*	2	2	6	
Diptera abundance	47341	20408	63442	
# of Chironomidae taxa*	1	1	2	
Chironomidae abundance	17396	12447	36091	
# of Crustacea taxa*	0	0	0	
Crustacea abundance	0	0	0	
# of Oligochaete taxa*	0	0	0	
Oligochaete abundance	124	0	189	
# of Mollusca taxa*	0	0	1	
Mollusca abundance	0	0	166	
# of Insect taxa*	16	8	19	
Insect abundance	76432	28453	110222	
# of Non-insect taxa*	1	0	1	
Non-insect abundance	249	39	851	

It is not unsurprising to see that diversity, abundance and richness appear to be depressed in sample site SOPLATO2 in the immediate vicinity of the low head dam. We expect to see significant change in this station in the next post project sampling effort, due to the elimination of sediment deposition behind the dam and return of the segment to a more natural cobble and gravel dominated riffle. Detailed descriptions of each of the assessment metrics in the previous table are listed in the table on the following pages.

*Standardized to OTU and fixed count. Common metrics used to assess freshwater biological integrity, as well as basic field and lab processing information. Note that values for richness based metrics are standardized to operational taxonomic units (OTUs; sensu Cuffney et al. 2007) and a fixed count (i.e., rarefaction) of 300, but density metrics are based on the raw taxa list. Standardized metrics are indicated with an asterisk. NAMC OTU standardization uses the method of removing individuals identified to the coarser taxonomic resolution or merging finer level identifications to coarser levels.

See additional tables of benthic information in the appendices.

Electro-Fishing Studies

An electrofishing station was established in the project reaches by the Colorado Division of Wildlife (now Colorado Department of Parks & Wildlife, or CPW) in the mid 1980's. The site is not one of the agency's primary sampling sites, and is

thus sampled infrequently at irregular intervals as the need to assess population dynamics and recreational harvest arises. In recent years, the site has been periodically sampled by the agency on average every two to five years. The station is located in Happy Meadows Reach 22 (USFS lands) approximately ¹/₂ mile upstream of the Sportsmen's Paradise / USFS property boundary. The biotic monitoring sites map in the macroinvertebrates section of this document shows the location of the eletrofishing site, designated as South Platte River #5 by CPW fisheries personnel. The station is 440 feet long, and at base flow contains a wetted perimeter of approximately 32,885 ft2 (0.75 acres). The station is characterized by boulder and cobble riffle habitats with considerable in channel pocket water features. The downstream third of the station has been impacted by sediment accumulating due to the presence of the low head dam at the Sportsmen's Paradise / USFS property boundary.

The South Platte River #5 electrofishing site was most recently sampled by the CPW in the fall of 2004, 2006, & 2007. The sampling method used was a two pass depletion survey, utilizing a 5 anode array and shore mounted Smith-Root GPP pulse electrofisher and generator. The results of these surveys are shown in the table below.

SOUTH PLATTE RIVER #5 ELECTROFISHING STATION (HAPPY MEADOWS)							
Rainbow Trout and Brown Trout Combined							
Year	Ν	#/Mile	Biomass (Ibs per acre)	Density (# per acre)	YOY Found	# > 14"	
2004	71	855	33	95	38	3	
2006	198	2361	87	261	118	10	
2007	119	1420	66	157	40	4	

The electrofishing data indicates that the Happy Meadows reach is functioning at less than it's potential, compared to other reaches in the South Platte River. Total biomass is less than robust in all of the sampling periods, and recruitment of young-ofthe-year trout is relatively poor. Several factors may effect fish density and recruitment, including fishing pressure/harvest, and habitat degradation due to sediment from the Hayman fire scar and from Park County Road 112 adjacent to the river. A roads assessment of the road is expected to be undertaken in the next year, and will identify problem areas and propose treatments. Significant sediment sources from the Hayman burn scar have been treated as part of the overall Happy Meadows Sportsmen's Paradise Project. We anticipate that reduction in sediment inputs, coupled with the incorporation of substantial amounts of large wood for habitat formation and complexity, should result in improved trout recruitment and young-of-the-year survival in the project reaches. The earliest that the site will be re-sampled by the CPW will be in early November 2013.

Permanent Photo Points


One hundred and seventy permanent photo points have been established along the 4 mile project reaches along the South Platte River. Photo points include at least four photos of each project cross section, looking upstream and downstream and from each bank pin looking along the axis of the cross section. Additional photo points have been established where significant treatments, such as channel narrowing, riparian enhancement, and in-channel structure have been constructed. Photo points are a quick and easy monitoring technique that is especially useful in documenting changes in channel dimension and pattern, and riparian health. Several examples of changes al-




ready documented in the project reaches are shown below.

Photo points were established using a GPS enabled camera (Garmin 650t or Nikon 1 V2) to tag geospatial data to the image. Geospatial metadata for each image is listed in the tables below, and a maps showing the location and bearing of each photo are included in the maps that follow. Thumbnail images of each photo are included at the end of the document. High resolution copies of the images will be maintained in the project file for analytical purposes. We anticipate that photo point monitoring will continue each year in the fall, when stream flow conditions are similar to past photo assessments, and following the summer growing season so as to document changes in riparian condition.

The following seven maps display the photo point and cross-section locations.

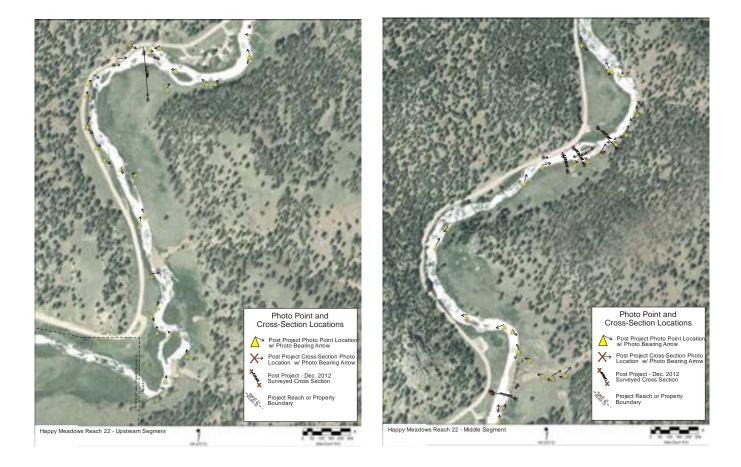

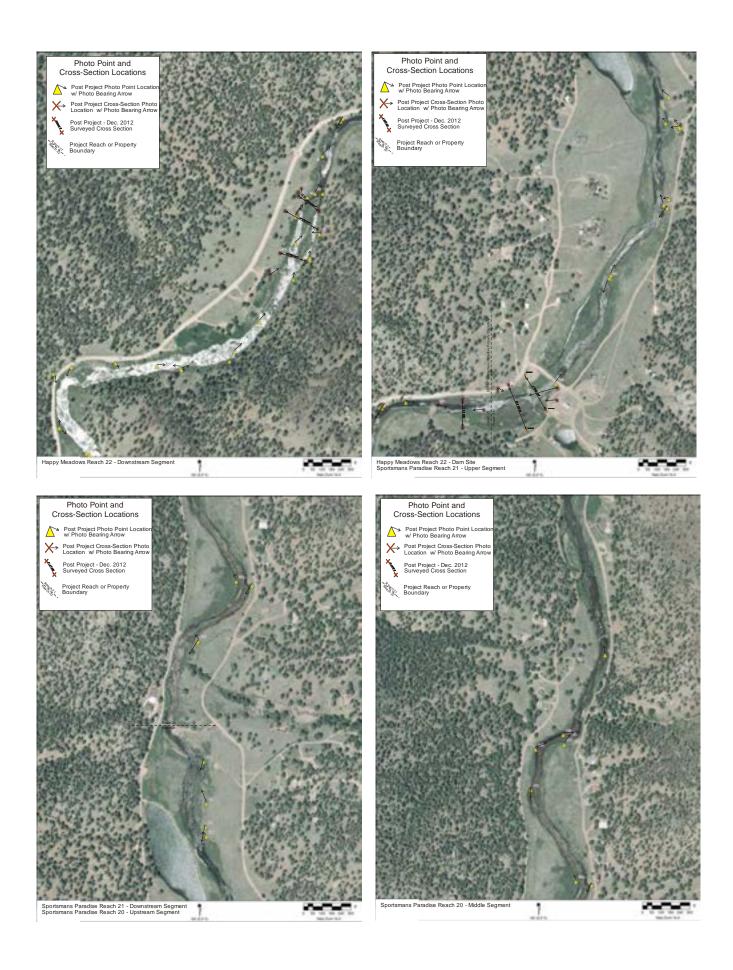



Substrate Characterization and Analysis

Pre-project pebble count surveys were conducted by the USFS in 2006 & 2007, and can be found in CUSP's South Platte River Sportsmen's Paradise & Happy Meadows Reach 20, 21, & 22 River Assessment & Restoration Plan, 2011.

Stream Channel Stability Ratings & Bank Erosion Hazard Analysis (WARSSS) We anticipate beginning the post project assessment of channel stability and bank erosion hazard in 2014, following a high flow cycle and at least one growing season for freshly planted willow and recently installed sedge mats.

Riparian Vegetation & Disturbed Areas Areas disturbed by construction activities

were treated by volunteers immediately following construction work in 2011 and 2012. Photo points have been established in these areas, and will be monitored following at least one growing season to assess effectiveness.

POST-PROJECT MONITORING

Post-project monitoring commenced two months following completion of project construction. Monitoring and evaluation of the project will follow the Sampling and Analysis Plan: Upper South Platte Nonpoint Source Initiative, 2011, developed by the Coalition for the Upper South Platte and the US Forest Service. Post project monitoring activities completed in 2012 include establishment of photo-point monitoring sites and post project cross-section analysis of a sub-set of thirteen cross-sections in the project reaches. The results of these surveys are included in this report.


Post project monitoring activities will continue over the next several years to evaluate the success of the project. At this point, we expect to conduct a complete channel morphology study within three years of project completion. This data will be utilized to complete a post-project HEC-RAS model and WARSSS assessment for the project reaches. Additional biotic surveys will be repeated by CPW & USFS personnel in the next two years.

Cross Section Analysis


A sub-set of thirteen representative cross sections were identified following construction to assess changes in channel dimension and profile in the project reaches. The location of these cross-sections is shown on the map on the following page. The table below outlines pre-project conditions and post project changes in several critical channel attributes, including bank-full channel width, mean depth (DMEAN), maximum channel depth (DMAX), and width to depth ratio. Plots of each cross-section are provided on the following pages.

		B Width	۶F	Mean Dep	th	Ma Depth	эх	W/ Ratio	D
CROSS SECTION #	HABITAT	PRE- PROJ ECT	POST PROJ ECT	PRE- PROJ ECT	POST PROJ ECT	PRE- PROJ ECT	POST PROJ ECT	PRE- PROJ ECT	POST PROJ ECT
HM XS#690	RIFFLE	94.6	56.3	1.54	1.95		3.04	61.3	28.9
HM XS#687	RIFFLE	81.2	63.6	1.76	2.35	2.63	4.53	46.1	27.0
HM XS#680	RIFFLE	61	54.6	1.61	2.46	2.62	3.61	38.0	22.2
HM XS#679	RIFFLE	118	75.9	1.26	1.64	2.14	2.21	93.5	46.2
HM XS#678	RIFFLE	60.3	62.7	2.20	2.28	3.79	4.54	27.5	27.5
HM XS#669	RIFFLE	123.8	67.1	1.56	1.56	2.40	2.19	79.2	43.0
HM XS#668	RIFFLE	126.3	46.2	1.66	1.98	3.01	2.62	76.1	23.4
HM XS#667	RIFFLE	103.3	50.5	1.81	2.28	3.47	3.51	57.2	22.2
DAM Site #8	RIFFLE	99	37.3	0.78	2.20	2.42	3.17	127.5	17.0
DAM Site #4	POOL	226	44.7	1.74	3.27	3.77	5.52	129.9	13.7
DAM Site #2	RIFFLE	84	54.4	0.94	1.27	1.49	2.44	89.4	42.7
SP XS#112	POOL	66.9	63.3	2.26	2.57	4.49	4.66	29.5	24.6
SP XS#111	RIFFLE	95.4	74	1.57	2.06	2.45	2.97	60.9	35.9


Width to depth ratios in the subset sample have been significantly reduced as a result of construction of new bank-full riparian benches and closure of multiple threaded channels. Post project W/D ratios in riffle habitats now average 30.5, down from a pre project average of over 68. DMEAN shows an increase in the riffle habitats, and DMEAN has increased in the pool habitats. While the results of the 2012 crosssection surveys are promising, we will wait until surveys are complete following an extended high flow period to assess the success of these efforts.

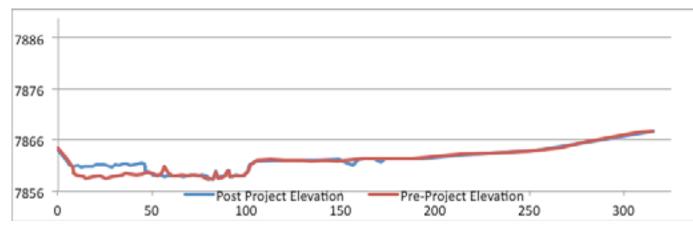


Happy Meadows Cross Section #690 – New riparian bank full bench on left bank.

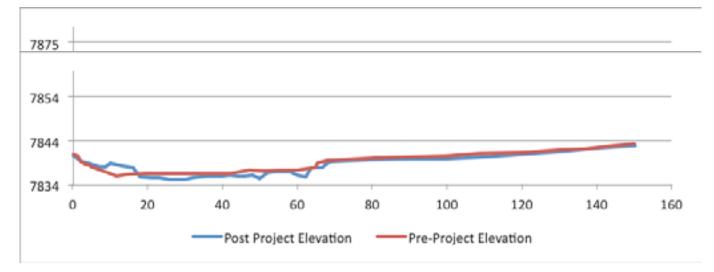


Happy Meadows Cross Section #687 – New riparian bank full bench on right bank

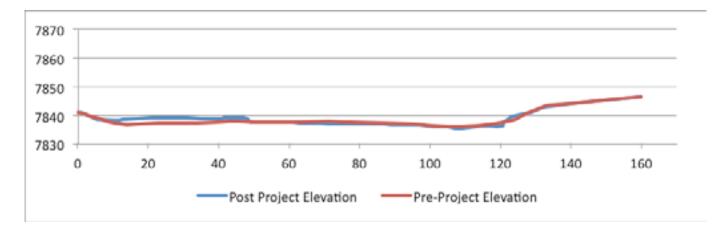


Happy Meadows Cross Section #680 – Small riparian bank full bench along road/river interface.

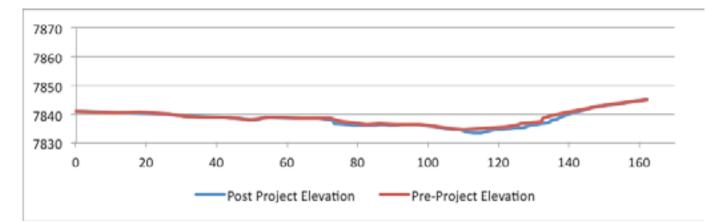


Happy Meadows Cross Section #679 – New riparian bench and side channel closure to reduce channel width/depth ratio in an over-wide glide habitat.

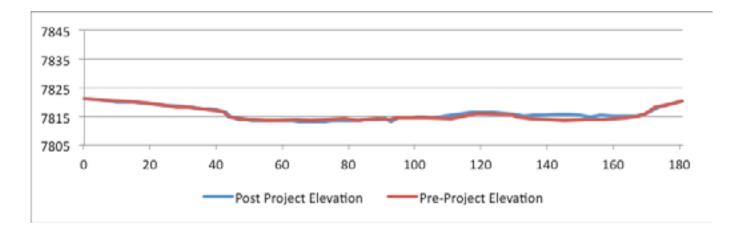


Happy Meadows Cross Section #678 – Small riparian bench and deepening of lateral scour pool.

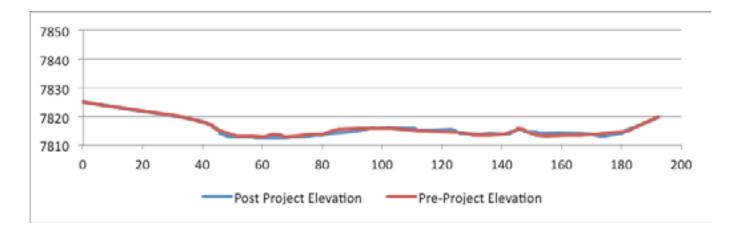


Happy Meadows Cross Section #669 – Closed 2nd channel on right.

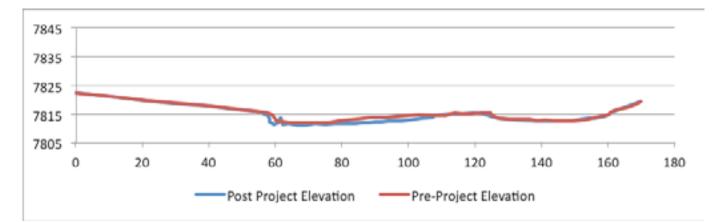


Happy Meadows Cross Section #668 – Closed 2nd channel on right, and increased cross-sectional area of left channel to maintain bank full capacity in a single thread channel.

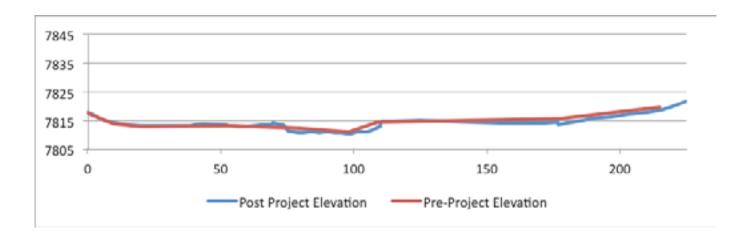


Happy Meadows Cross Section #667 – Closed 2nd channel on right and converted to backwater pool habitat for YOY at high flow. Increased cross sectional area of the left channel to maintain bank full capacity of the new single thread channel.

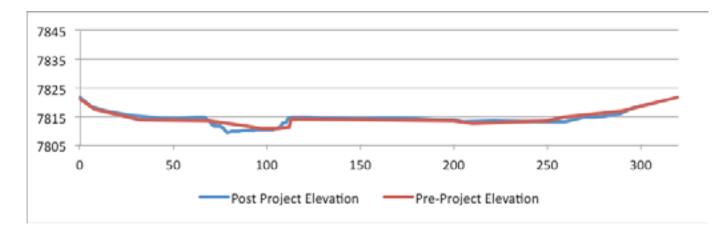


Sportsmen's Paradise Dam Site Cross Section #8 – Defined a narrow channel in the mud flat upstream of the old dam site.

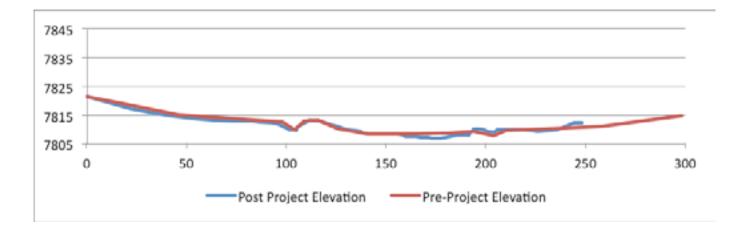


Sportsmen's Paradise Dam Site Cross Section #4 – Immediately upstream of the old dam site. Defined a narrow channel in the mud flat and stepped the bed elevation down to match the lower channel elevation.

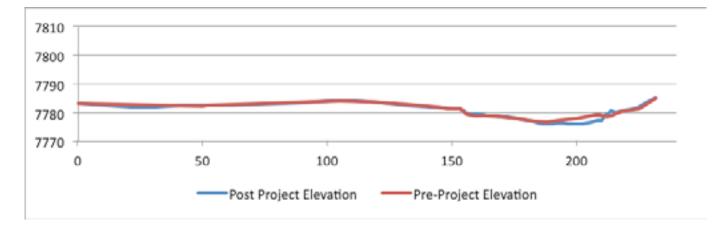

Sportsmen's Paradise Dam Site Cross Section #2 – Immediately downstream of the old dam site. New riparian bank-full bench on the right side of the channel, and a new channel and confluence for Vermillion Creek.

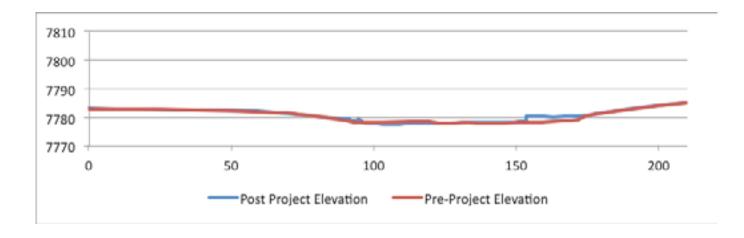

Sportsmen's Paradise Cross Section #112 – Narrowed and deepened the channel through a lateral scour pool near the downstream boundary of Reach 20.

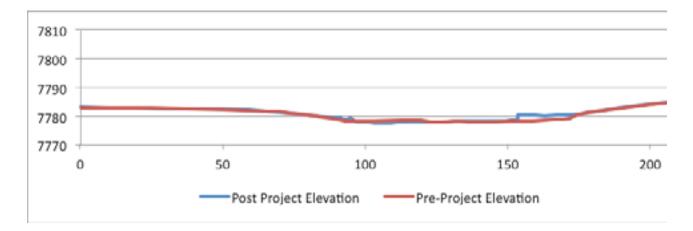

Sportsmen's Paradise Cross Section #111 – New riparian bank full bench on right side of the river to reduce width/depth ratio in a severely over-wide cobble/boulder riffle near the downstream boundary of Reach 20.

FUTURE EFFORTS

There will be additional monitoring over the next several years. For example, benthic organisms, fish shocking, photo points, and cross-sections will be rechecked within the next three years. A post project longitudinal channel profile has not yet been completed in the project reaches. We anticipate that this survey will also be undertaken within the larger post project monitoring effort within three years following completion of construction. Pre-project longitudinal profile surveys can be found in CUSP's South Platte River Sportsmen's Paradise & Happy Meadows Reach 20, 21, & 22 River Assessment & Restoration Plan, 2011.

Substrate Characterization and Analysis

Pre-project pebble count surveys were conducted by the USFS in 2006 & 2007, and can be found in CUSP's South Platte River Sportsmen's Paradise & Happy Meadows Reach 20, 21, & 22 River Assessment & Restoration Plan, 2011. Post project substrate sampling will be completed in the project reaches following at least one bank full high flow period. We anticipate that this survey will be undertaken within the larger post project monitoring effort three years following completion of construction.

Stream Channel Stability Ratings & Bank Erosion Hazard Analysis (WARSSS)


We anticipate beginning the post project assessment of channel stability and bank erosion hazard in 2014, following a high flow cycle and at least one growing season for freshly planted willow and recently installed sedge mats.

Riparian Vegetation & Disturbed Areas

Areas disturbed by construction activities were treated by volunteers immediately following construction work in 2011 and 2012. Photo points have been established in these areas, and will be monitored following at least one growing season to assess effectiveness.

Additional

Habitat mapping survey and a channel morphology surveys may be repeated five to ten years following completion of the project.

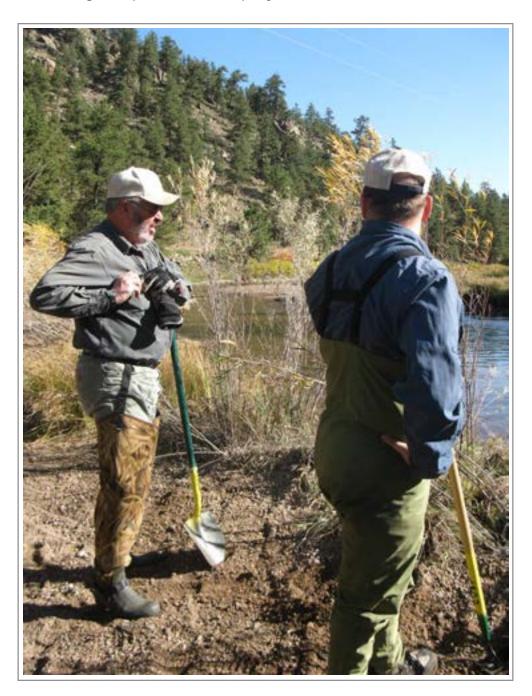

REFERENCES

References:

Azuma, David and David Fuller, 1994. Repeatability of the USFS Pacific SW Region Habitat Classification Procedure. USFS Pacific Southwest Experiment Station, Berkely, CA. Presentation Paper for the 1994 National American Fisheries Society Meeting.

Bisson, P.A., J.L. Nielson, R.A. Palmason, and L.E. Grove. 1981. A system for mapping habitat types in small streams, with examples of habitat utilization by salmonids during low stream flow. p. 62-73. In: N.B. Armantrout (ed.). Acquisition and utilization of aquatic habitat. Western Div. Amer. Fish. Soc., Portland, OR 376pp.

Bovee, K.D. 1982. A guide to stream habitat analysis using the Instream Flow Incremental Methodology. Instream Flow Information Paper '12. U.S. Fish and Wildlife Service. FWS/OBS-82/26.

Gallagher, J. P., et al, 2010. South Platte River - Happy Meadows – Reach 22 River Restoration Plan. Prepared for the Coalition for the Upper South Platte and the Pike National Forest. Fin-Up Habitat Consultants, Inc. – unpublished, 42pp.

Gallagher, J. P., 2008. Aquatic Assessment & Habitat Enhancement Plan - The South Platte River- Lake George Company, Park County – Colorado. Unpublished assessment for the Lake George Company prepared by Fin-Up Habitat Consultants, Inc., 36pp.

Gibbons, D.R., W.R. Meehan, M.D. Bryant, M.L. Murphy, S.T. Elliot. 1990. Fish in the Forest. Large Woody Debris in Streams, A New Management Approach to Fish Habitat. USDAForest Service, R10-MB-86. 21pp.

Hamilton, K. and E.P. Bergersen. 1984. Methods to Estimate Habitat Variables. CSU, CO Coop. Fish. Res. Unit, Environ. Eval., BOR Project No. DPTS-35-9.

Hankin, D.G. and G.H. Reeves. 1988. Estimating total fish abundance and total habitat area in small streams based upon visual estimation methods. Can. J. Fish. Aquat. Sci,, 45: 834-S44.

Helm, W.T., P. Brouha, M. Aceituno, C. Armour, P. Bisson, J. Hall, G. Holton, and M. Shaw. 1983. Aquatic habitat inventory. Glossary and Standard Methods. West.. Div. A.F.S., Portland, OR. 34pp.

Lisle, T.E. 1987. Using residual depths to monitor pool depths independently of discharge. USDA-FS Rsch. Note, PSW-394. 4pp.

McCain, Mike, David Fuller, Lynn Decker and Kerry Overton. 1990. Stream Habitat Classification and Inventory Procedures for Northern California. Region 5 FHR Currents Technical Bulletin #1, USDA-Forest Service, Pacific Southwest Region. Arcata CA. 15pp.

Ohlander, Coryell A. 1996. Clean Water Act - Monitoring and Evaluation, Part 7. Stream Reach Monitoring - T-Walk Training - Syllabus to Establish Background and Rationale. USDA Forest Service, Rocky Mountain Region, Denver, CO. 141pp.

Pacific Southwest Region Habitat Typing Field Guide (USDA-USFS) 86

Pfankuch, D.J. 1975. Stream reach inventory and channel stability evaluation. USDA-FS Northern Region RI-75-002. 22pp.

Platts, W.S. 1974. Geomorphic and aquatic conditions influencing salmonids and stream classification. USDA-FS, Surface Environment and Mining Report, Washington, D.C.

Platts, W. S., W.F. Megahan and G.W. Minshall. 1983. Methods for evaluating stream riparian and biotic conditions. USDA-FS Forest Range Exp. Stn., Gen. Tech. Rept. INT-13S. 70 pp.

Rosgen, D.L. 1985. A stream classification system. IN: Riparian ecosystems and theirmanagement; reconciling conflicting uses. Proceedings of the First North American

Riparian Conference, April 16-18, Tucson, AZ. GTR-RM120, pp. 91-95.

Schmal, R.N., S.J. Kozel, and S.S. Marsh. 1988. A Basin-Wide Inventory Approach Using a Channel Type and Habitat Type Classification System for Resident Trout. USDA-FS. Medicine Bow National Forest, 16pp with illustrations.

USDA-Forest Service. 1975. Stream Reach Inventory and Channel Stability Evaluation: A Watershed Management Procedure. USDA-Forest Service, Northern Region. RI-75-002. 26pp.

Winters, D.S. and J.P.Gallagher. - USDA-Forest Service. 1997. Basinwide Stream Habitat Inventory - A Protocol for the Pike and San Isabel National Forests and the Cimarron and Comanche National Grasslands. 41pp.

Winters, D.S., T. Wagner and J.P.Gallagher. - USDA-Forest Service. 2007. Developing Monitoring Plans for Structure Placement in the Aquatic Environment – ElevenMile Canyon Demonstration Project, San Dimas Technology Center, San Diego, CA.


Ariel Photography provided by the US Forest Service. Topographical maps created using USGS and Delorme TOPO 8.0





APPENDIX A


AS-BUILT DRAWINGS


The following pages provide as-built drawings of the project. This documentation is critical to future project monitoring and evaluation, and to our ability to understand and adapt to changes as more projects are implemented in the watershed in years to come.

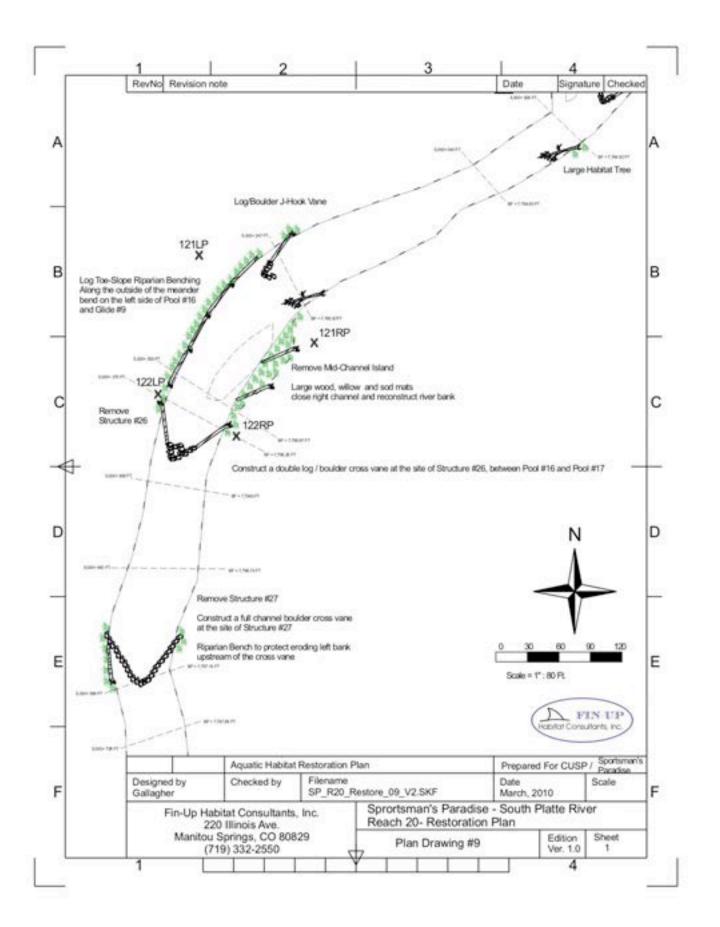


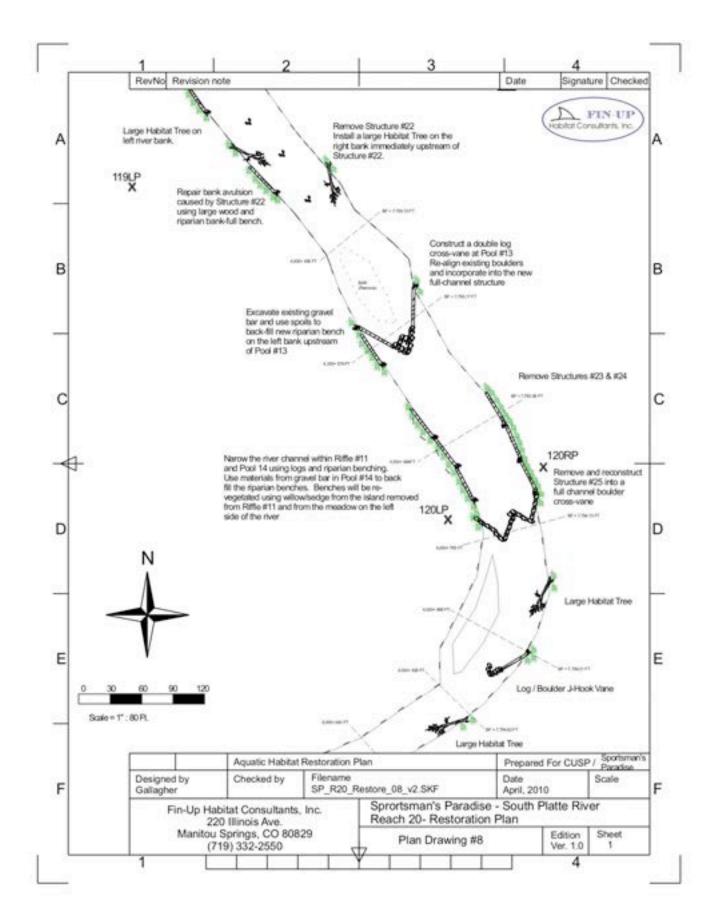


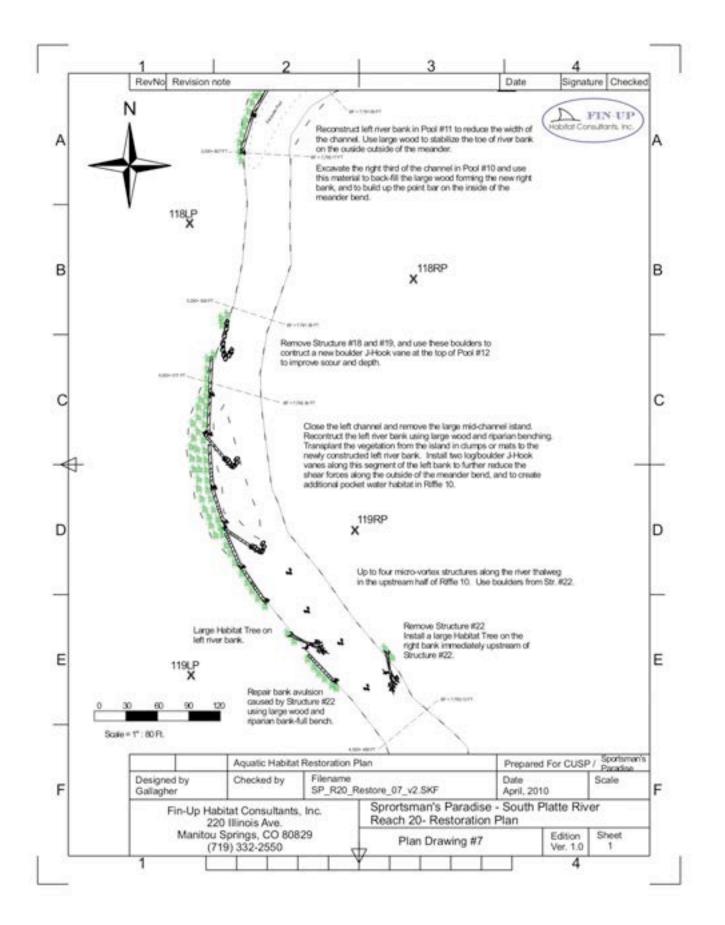


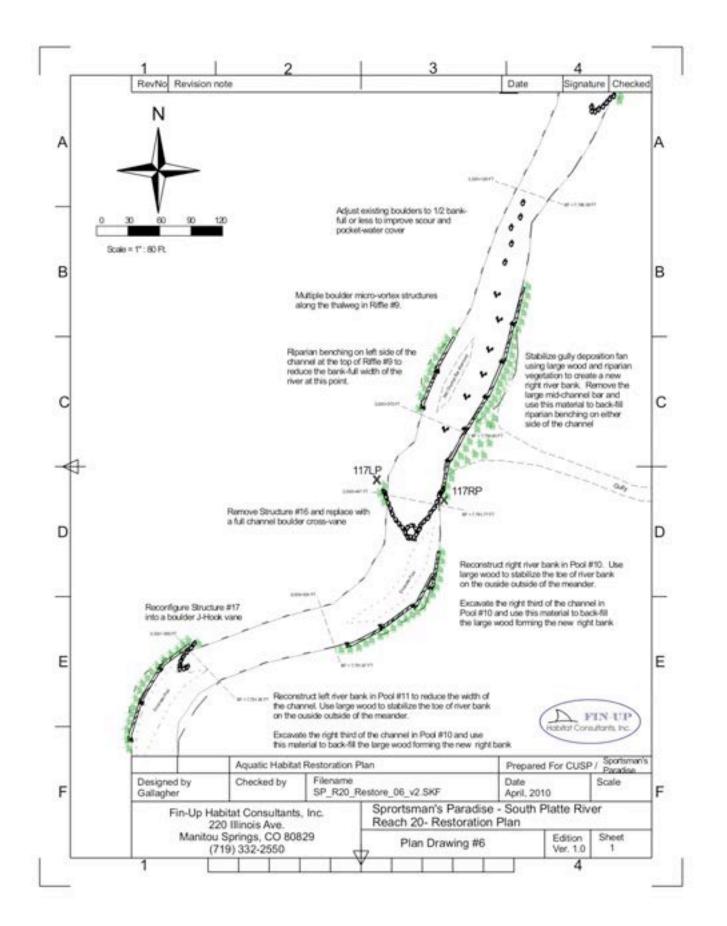


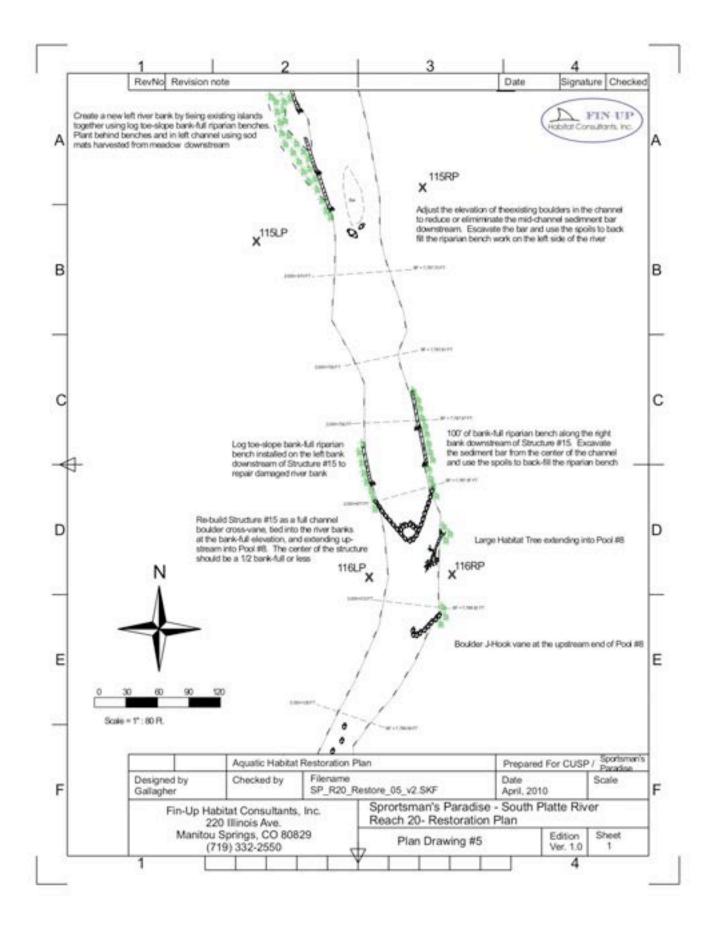


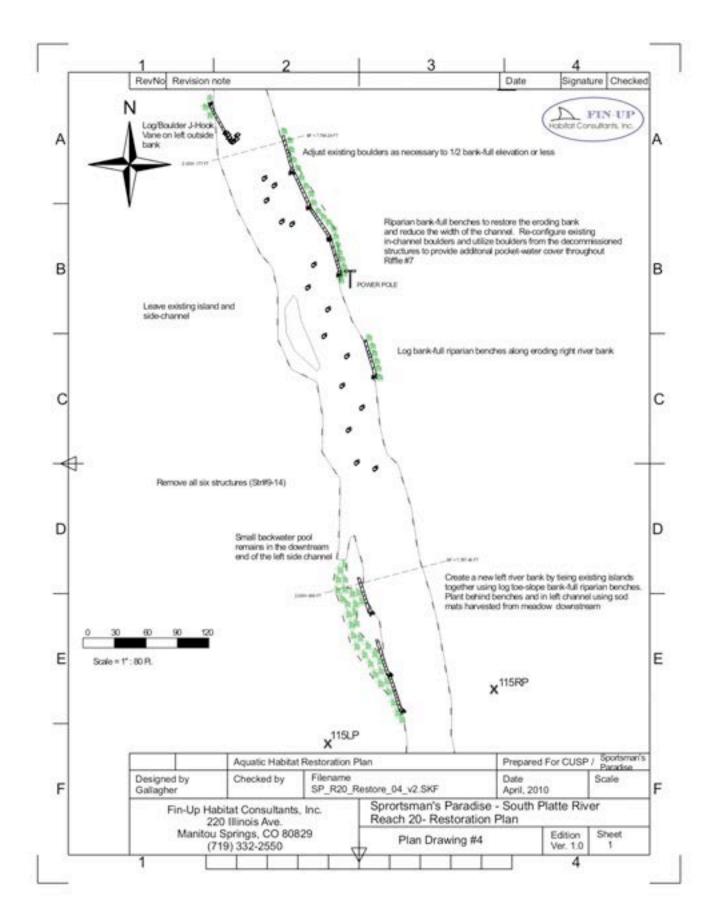


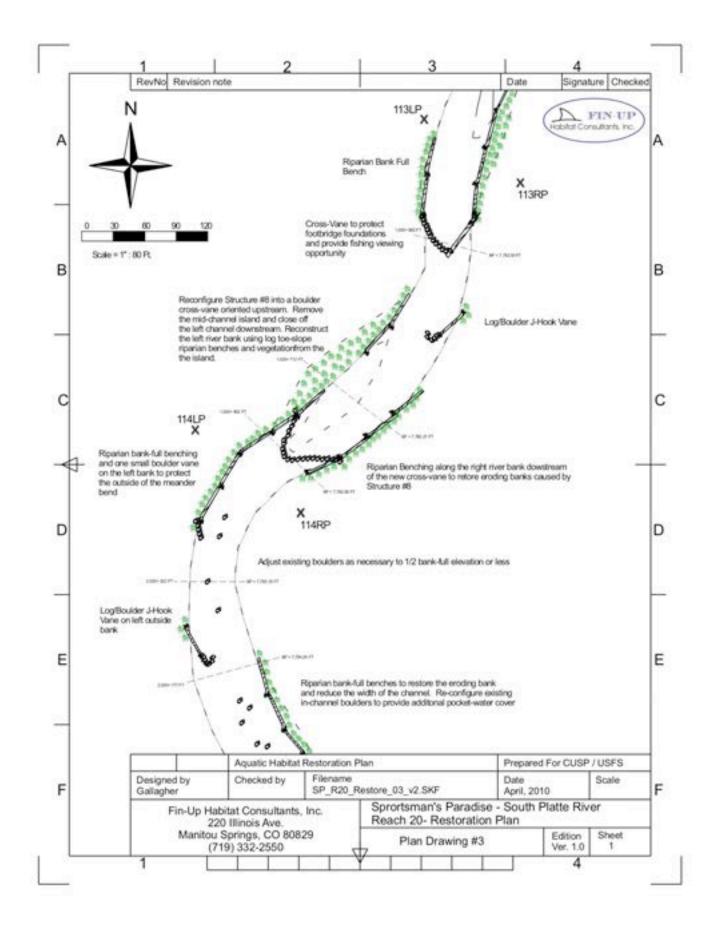


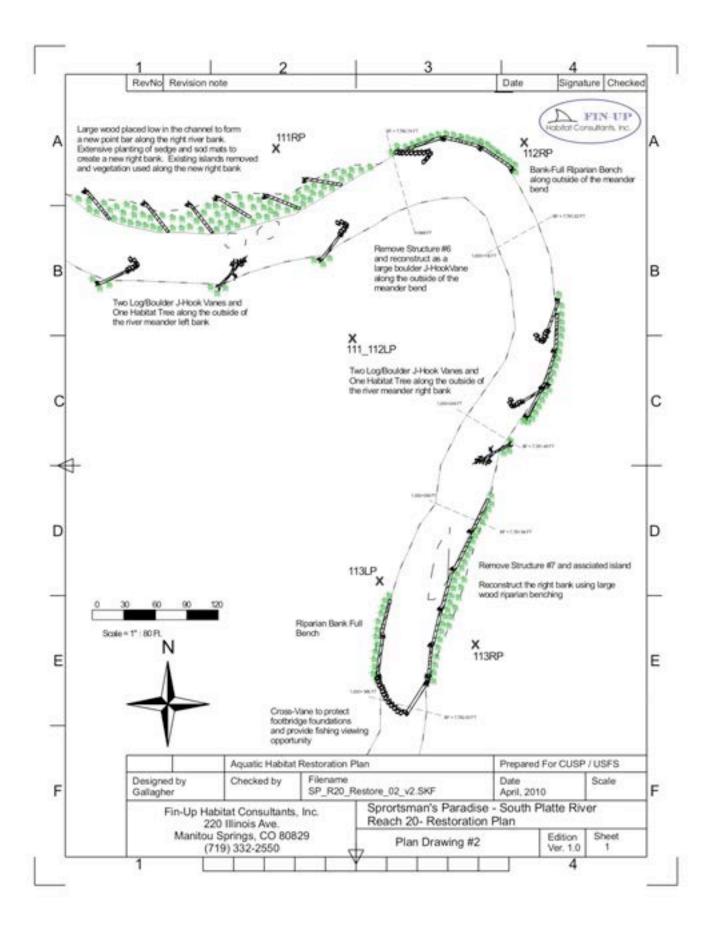


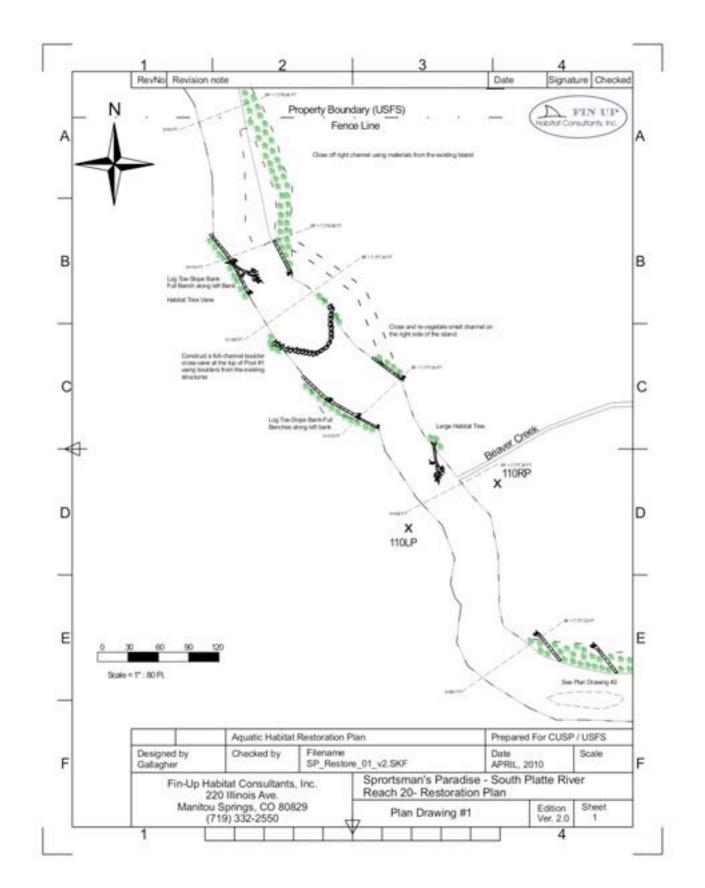


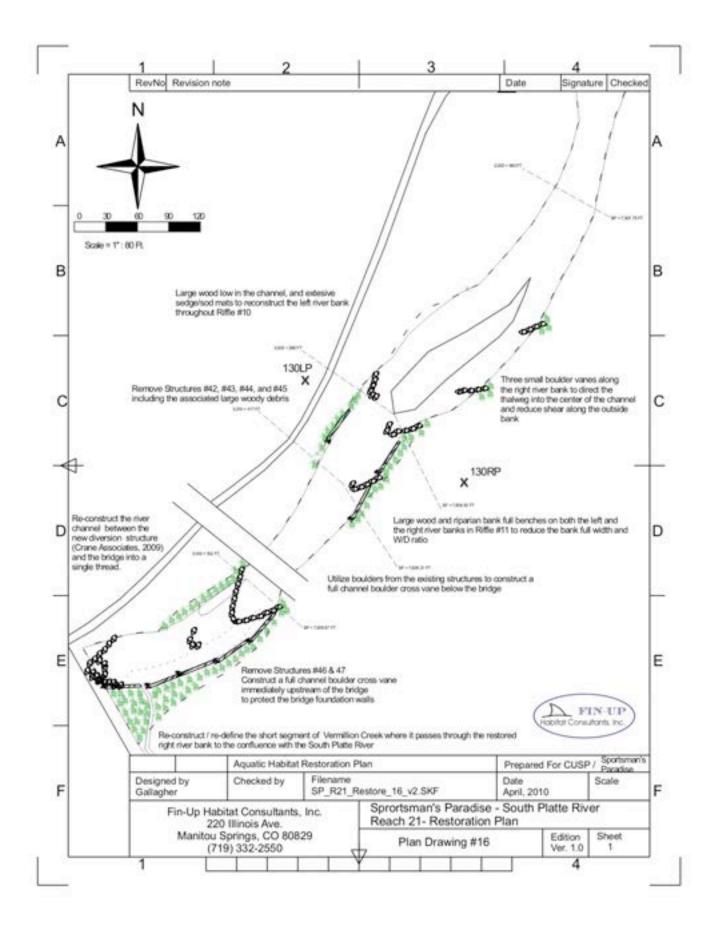


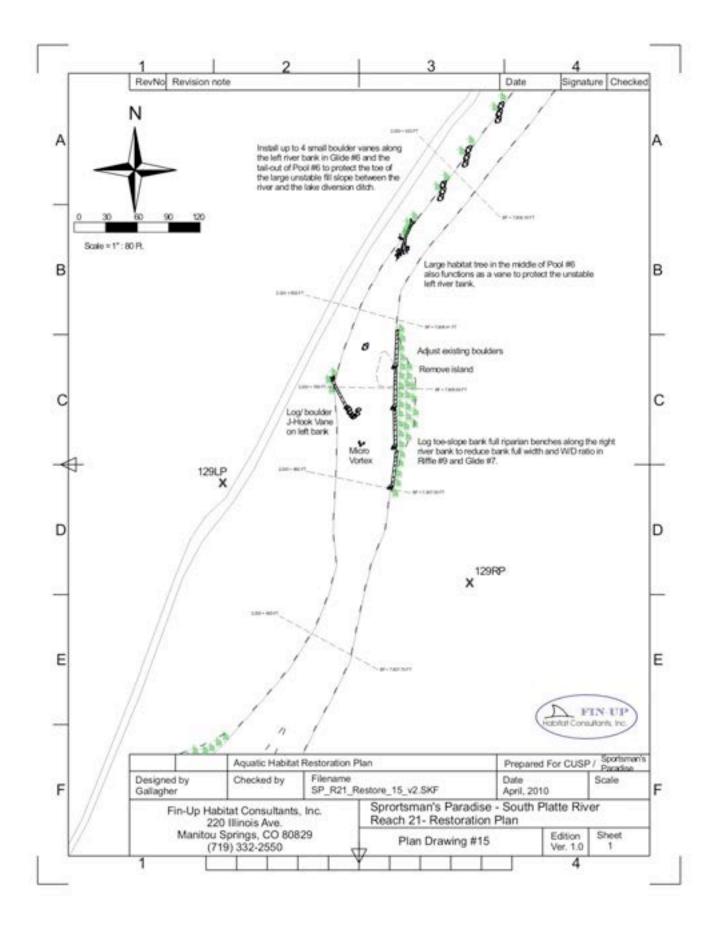


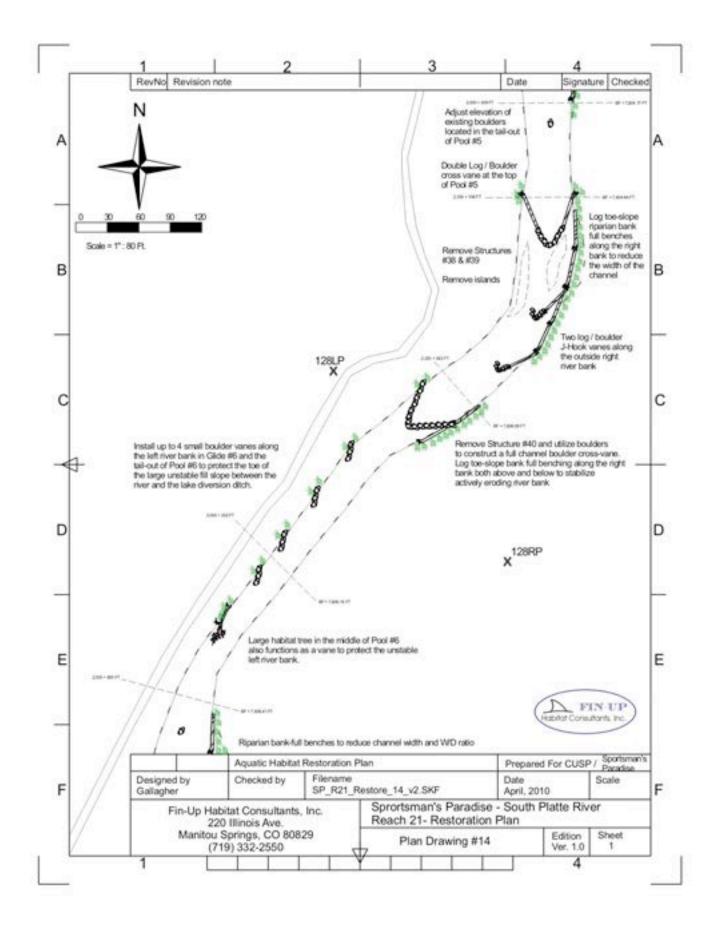


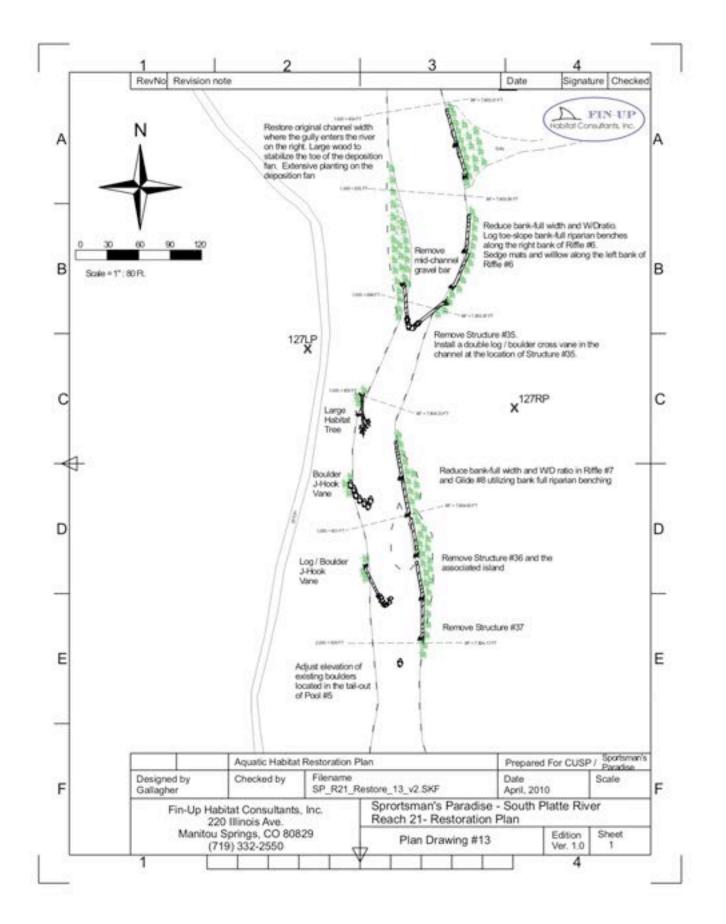


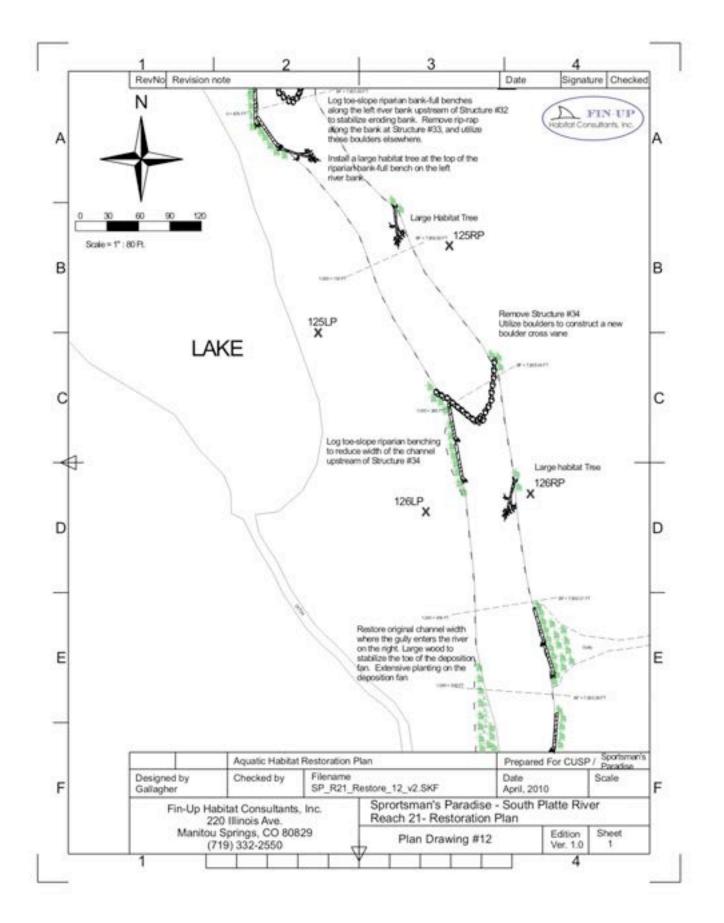


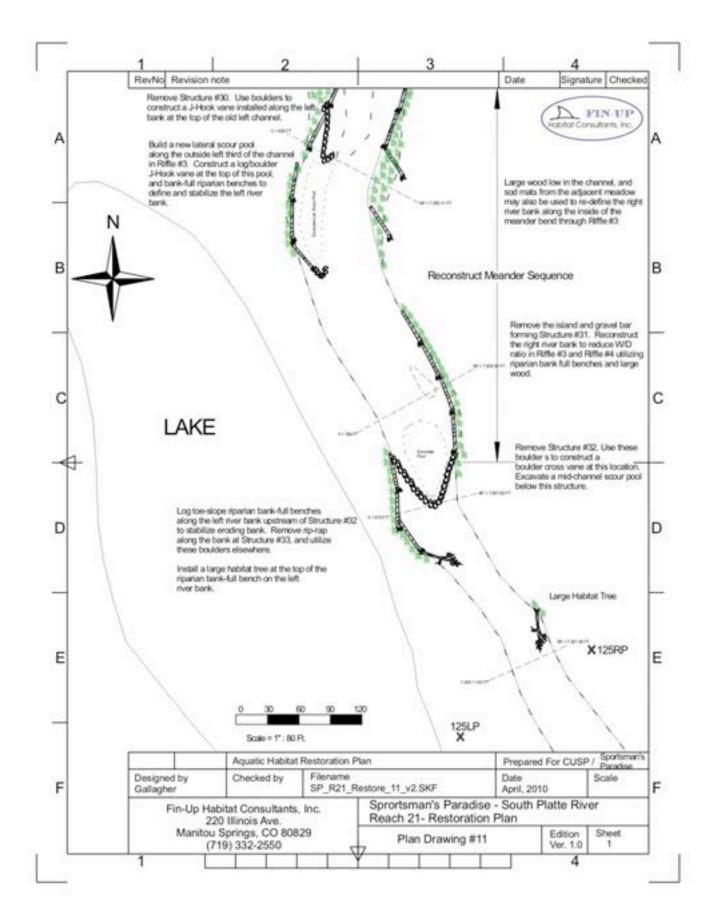


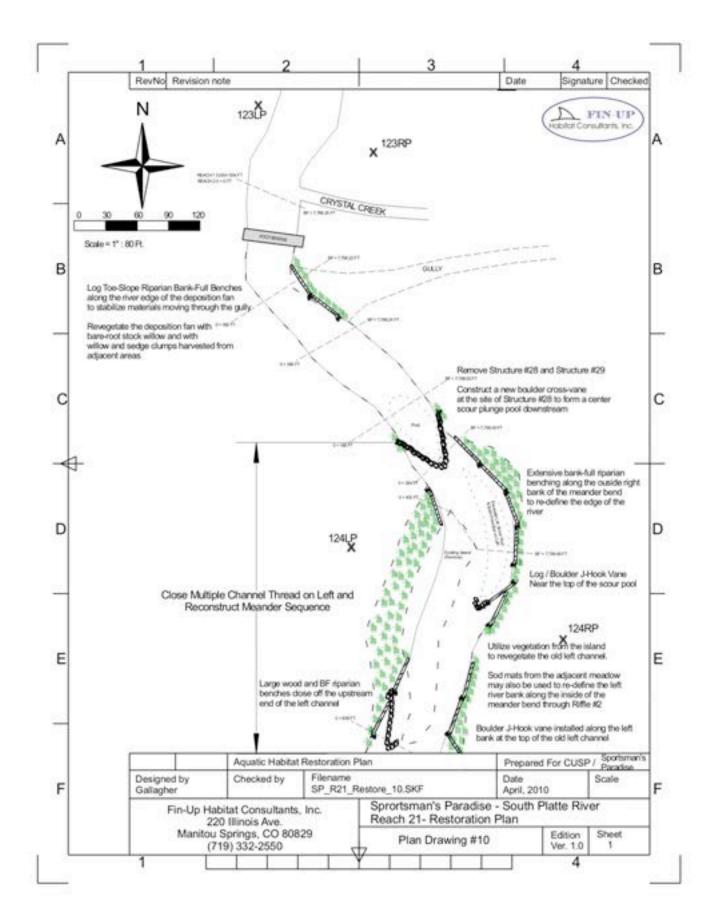


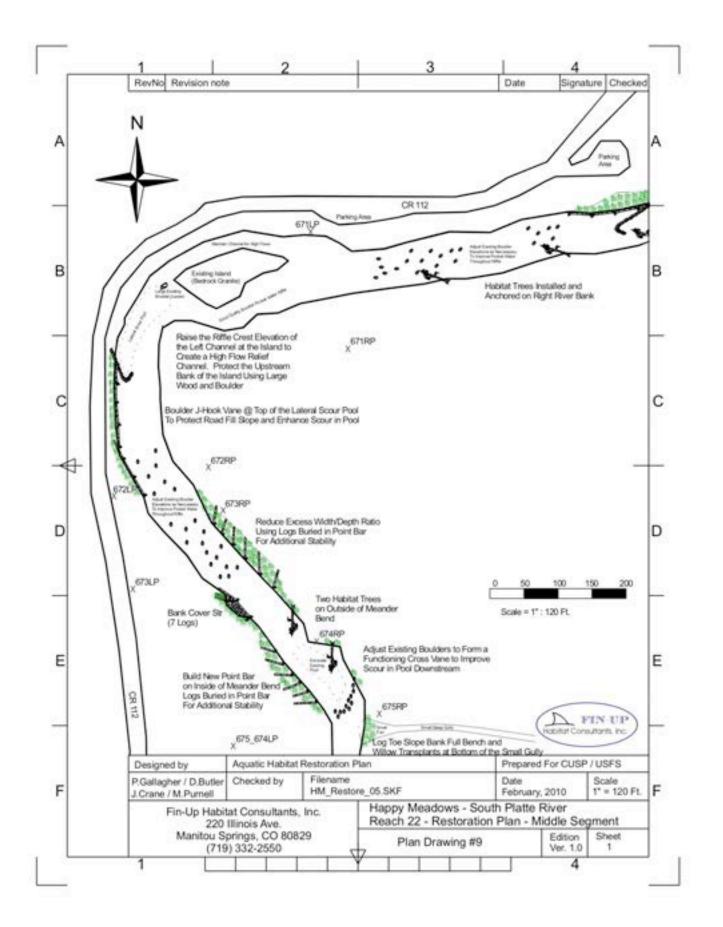


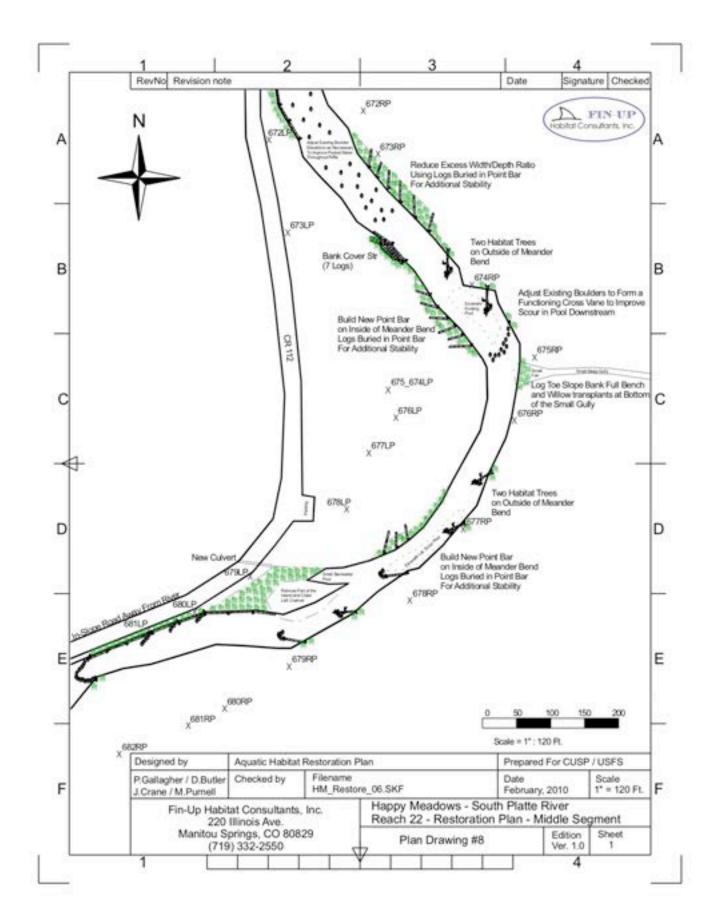


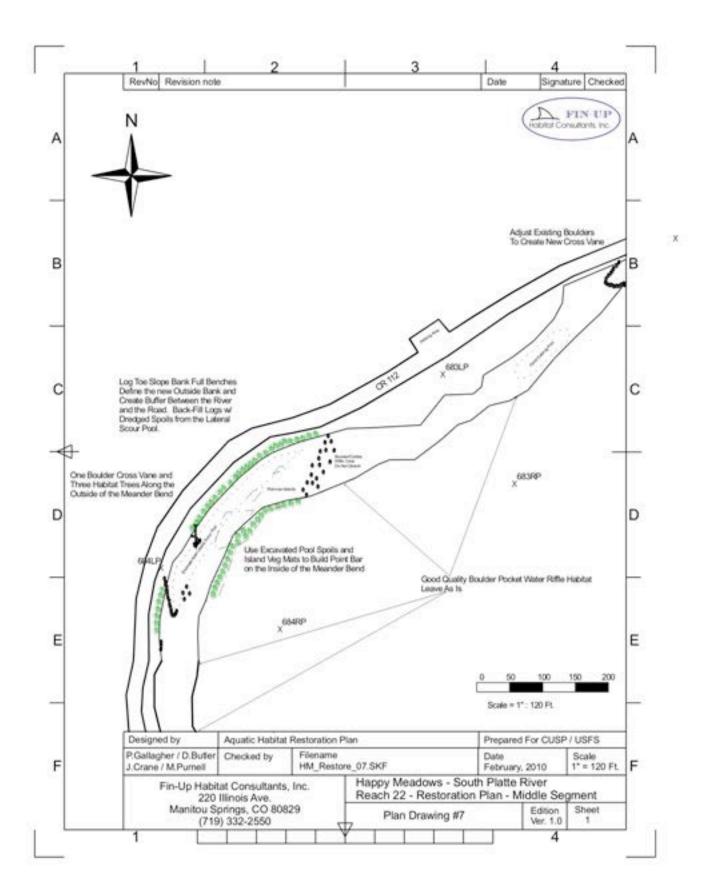


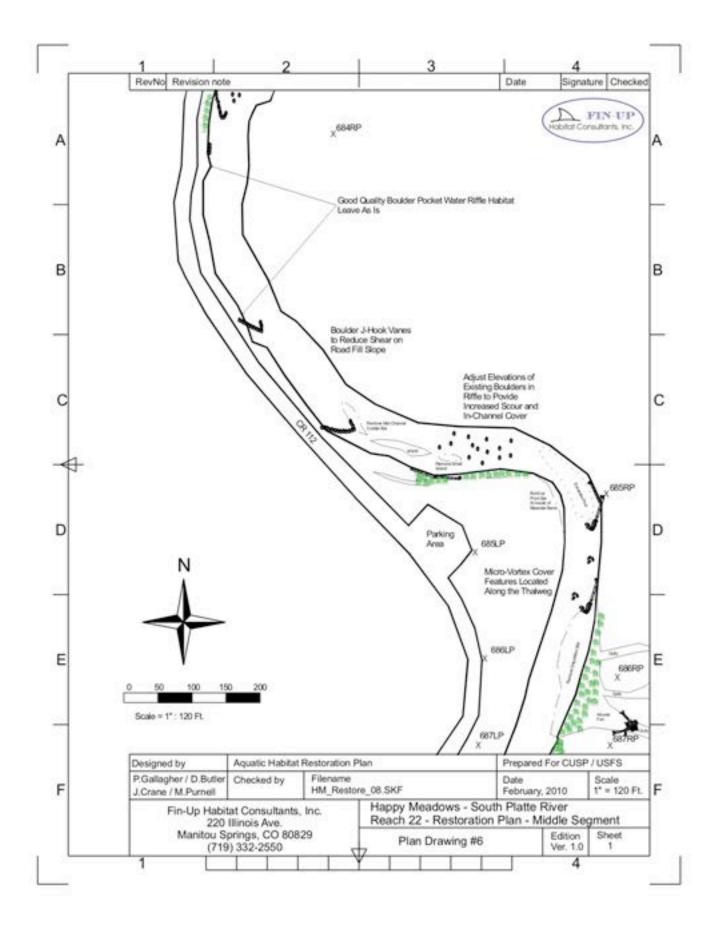


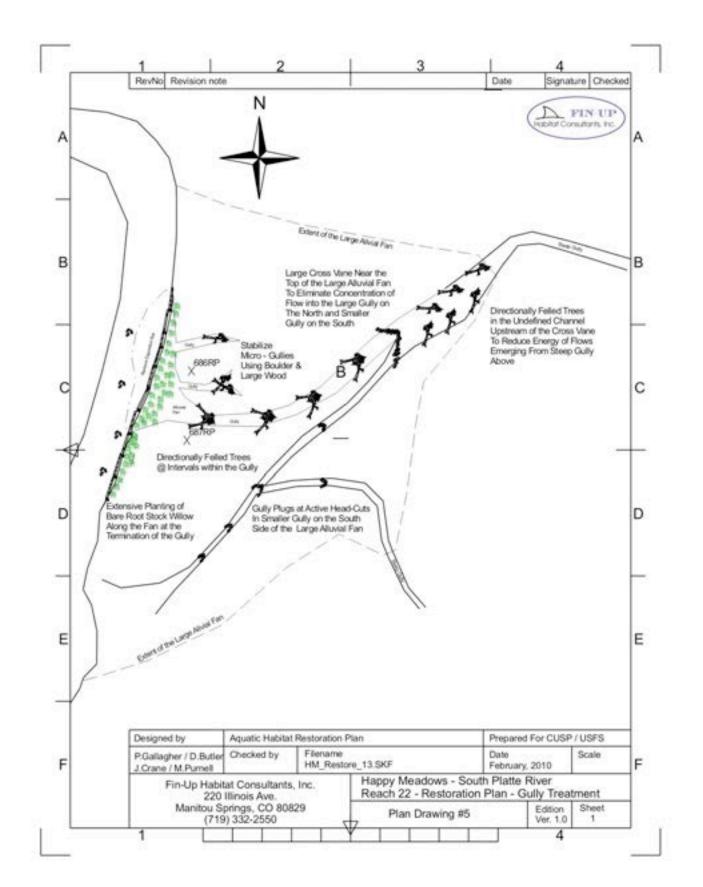


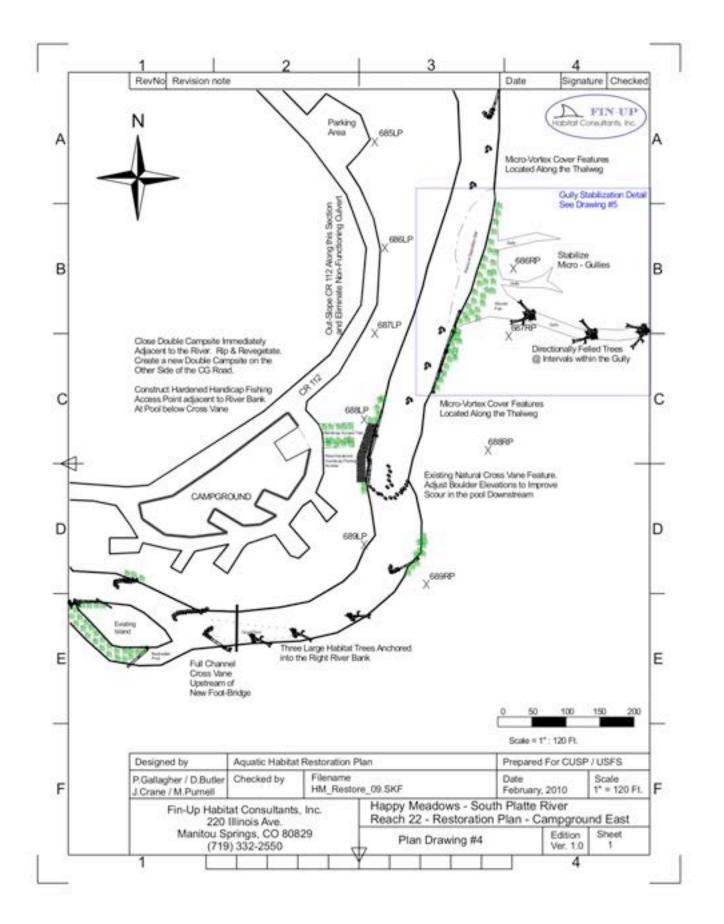


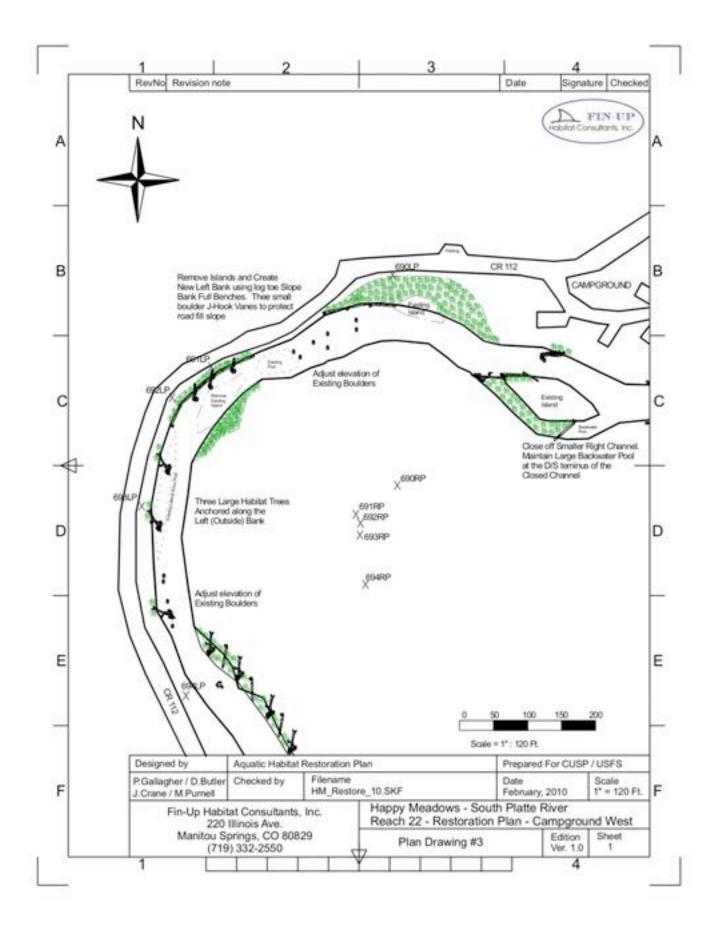


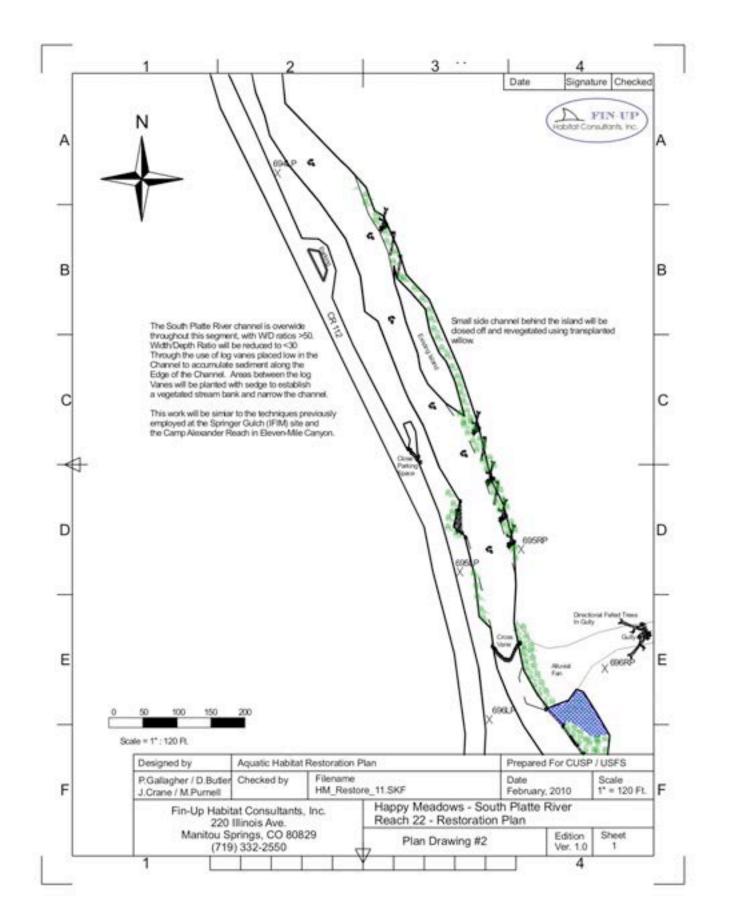

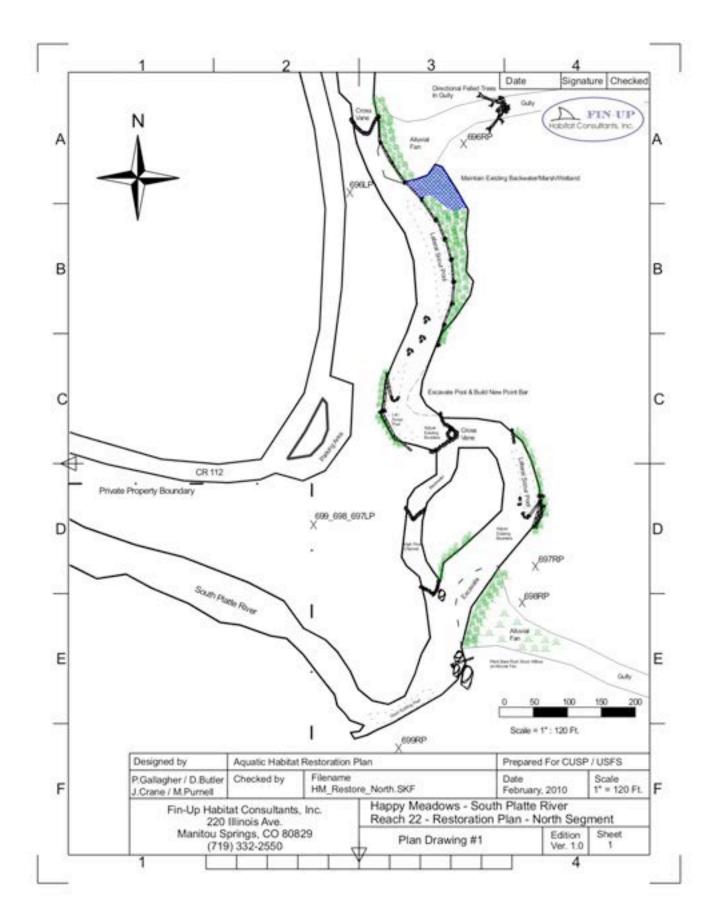

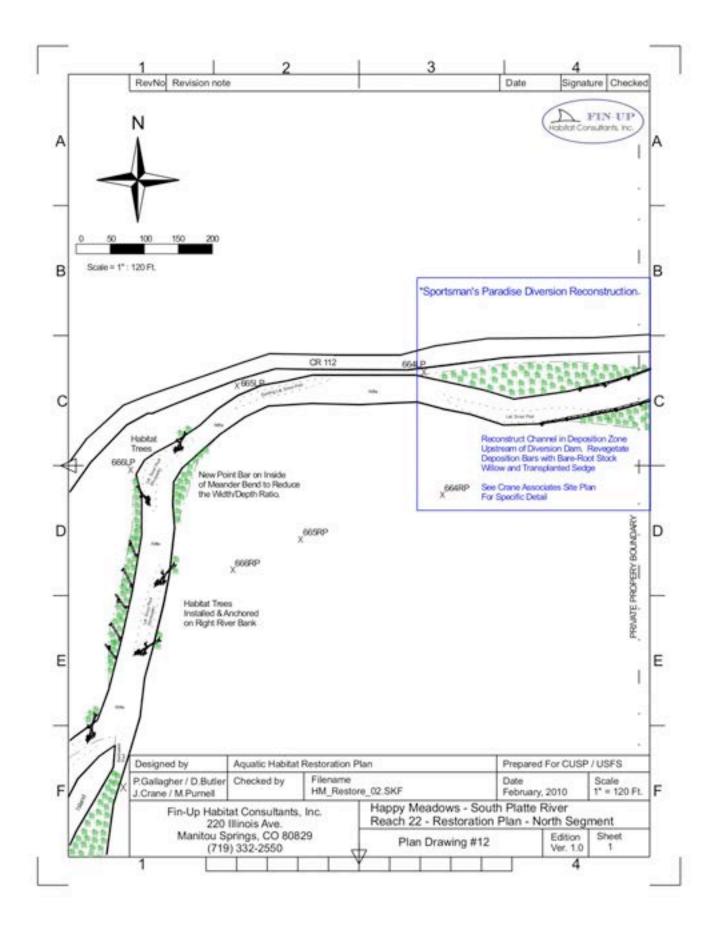

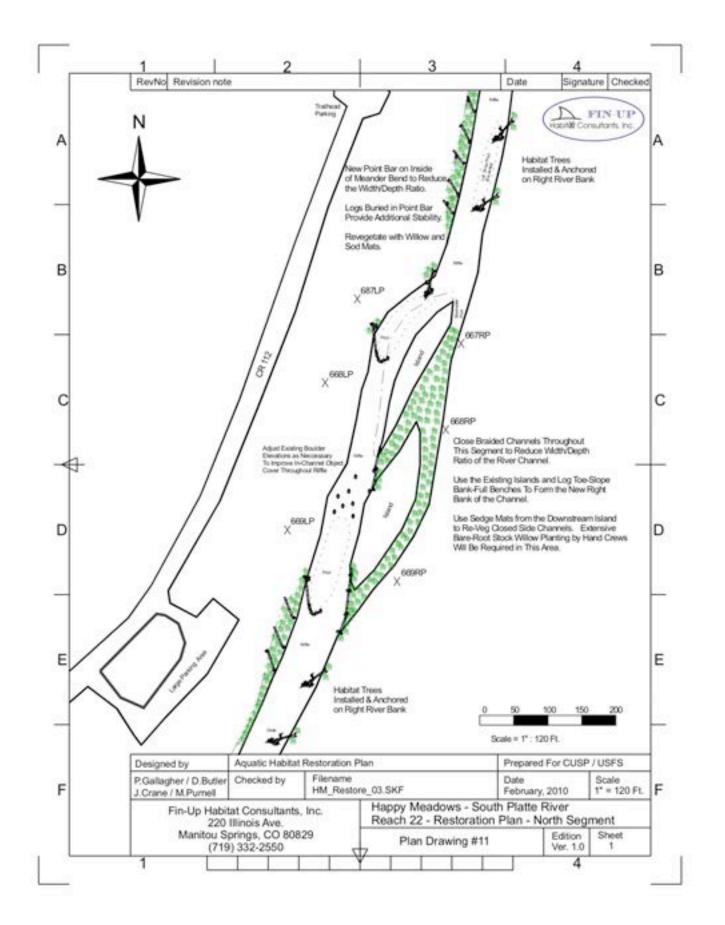

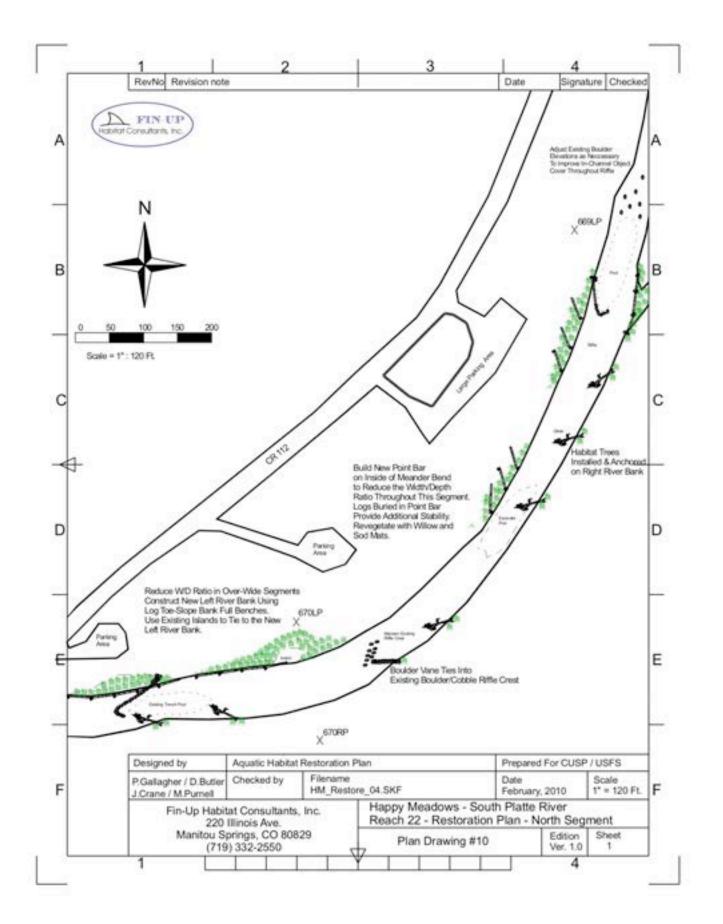



APPENDIX B

PHOTO POINT INFO


Photo points are an important long-term monitoring tool. We established a photopoint series that will be remonitored in coming years.

SPC	ORTSMANS PAR	ADISE - POST	PROJECT PHO	TO POINTS ME	TADATA FILE	
DATE: DEC 6, 2012; DEV	ICE: NIKON 1 V2	w/ 10-30mm Len	s & GP1000 GPS	Unit; MAP DATU	M: WGS-84; IMAGE SIZE:	4608x3072
File	Photo #	File Size	Focal Length	Latitude	Longitude	Photo #
SP_XS2_013.JPG	151	8.93 MB	10mm		SP_XS2_013.JP	151
SP_XS2_014.JPG	152	8.80 MB	10mm		SP_XS2_014.JP	152
SP_XS2_015.JPG	153	8.94 MB	10mm		SP_XS2_015.JP	153
SP_XS2_016.JPG	154	9.00 MB	10mm	N 39°1.575'	SP_XS2_016.JP	154
SP_XS4_009.JPG	155	8.33 MB	30mm	N 39°1.588'	SP_XS4_009.JP	155
SP_XS4_010.JPG	156	8.95 MB	10mm	N 39°1.591'	SP_XS4_010.JP	156
SP_XS4_011.JPG	157	8.44 MB	10mm	N 39°1.587'	SP_XS4_011.JP	157
SP_XS4_012.JPG	158	8.37 MB	10mm		SP_XS4_012.JP	158
SP_XS8_005.JPG	159	8.95 MB	10mm	N 39°1.576'	SP_XS8_005.JP	159
SP_XS8_006.JPG	160	7.80 MB	10mm	N 39°1.570'	SP_XS8_006.JP	160
SP_XS8_007.JPG	161	8.75 MB	10mm	N 39°1.546'	SP_XS8_007.JP	161
SP_XS8_008.JPG	162	7.16 MB	10mm	N 39°1.565'	SP_XS8_008.JP	162
SP_XS111_045.JPG	163	7.57 MB	10mm	N 39°2.767'	SP_XS111_045.	163
SP_XS111_046.JPG	164	7.90 MB	10mm	N 39°2.771'	SP_XS111_046.	164
SP_XS111_047.JPG	165	8.08 MB	10mm	N 39°2.752'	SP_XS111_047.	165
SP_XS111_048.JPG	166	8.29 MB	10mm	N 39°2.740'	SP_XS111_048.	166
SP_XS112_049.JPG	167	8.70 MB	10mm	N 39°2.740'	SP_XS112_049.	167
SP_XS112_050.JPG	168	8.25 MB	10mm	N 39°2.746'	SP_XS112_050.	168
SP_XS112_051.JPG	169	7.29 MB	14mm	N 39°2.768'	SP_XS112_051.	169
SP_XS112_052.JPG	170	7.60 MB	14mm	N 39°2.773'	SP_XS112_052.	170

SP_Photopoint_017.JPG	123	8.46 MB	10mm	N 39°1.594'	SP_Photopoint	123
SP_Photopoint_018.JPG	124	8.52 MB	10mm	N 39°1.704'	SP_Photopoint	124
SP_Photopoint_019.JPG	125	7.71 MB	10mm	N 39°1.707'	SP_Photopoint	125
SP_Photopoint_020.JPG	126	8.39 MB	10mm	N 39°1.777'	SP_Photopoint	126
SP_Photopoint_021.JPG	127	8.46 MB	10mm	N 39°1.780'	SP_Photopoint	127
SP_Photopoint_022.JPG	128	8.30 MB	10mm	N 39°1.786'	SP_Photopoint	128
SP_Photopoint_023.JPG	129	8.64 MB	11.4mm	N 39°1.862'	SP_Photopoint	129
SP_Photopoint_024.JPG	130	8.44 MB	11.4mm	N 39°1.860'	SP_Photopoint	130
SP_Photopoint_025.JPG	131	8.35 MB	11.4mm	N 39°1.865'	SP_Photopoint	131
SP_Photopoint_026.JPG	132	8.90 MB	11mm	N 39°1.892'	SP_Photopoint	132
SP_Photopoint_027.JPG	133	8.32 MB	10mm	N 39°1.984'	SP_Photopoint	133
SP_Photopoint_028.JPG	134	8.79 MB	10mm	N 39°1.974'	SP_Photopoint	134
SP_Photopoint_029.JPG	135	8.51 MB	30mm	N 39°2.008'	SP_Photopoint	135
SP_Photopoint_030.JPG	136	8.05 MB	10mm	N 39°2.052'	SP_Photopoint	136
SP_Photopoint_031.JPG	137	8.36 MB	10mm	N 39°2.177'	SP_Photopoint	137
SP_Photopoint_032.JPG	138	8.88 MB	10mm	N 39°2.176'	SP_Photopoint	138
SP_Photopoint_033.JPG	139	8.52 MB	10mm	N 39°2.239'	SP_Photopoint	139
SP_Photopoint_034.JPG	140	8.43 MB	10mm	N 39°2.235'	SP_Photopoint	140
SP_Photopoint_035.JPG	141	7.55 MB	10mm	N 39°2.334'	SP_Photopoint	141
SP_Photopoint_036.JPG	142	8.45 MB	10mm	N 39°2.376'	SP_Photopoint	142
SP_Photopoint_037.JPG	143	8.36 MB	10mm	N 39°2.391'	SP_Photopoint	143
SP_Photopoint_038.JPG	144	8.45 MB	10mm	N 39°2.381'	SP_Photopoint	144
SP_Photopoint_039.JPG	145	8.51 MB	10mm	N 39°2.474'	SP_Photopoint	145
SP_Photopoint_040.JPG	146	8.60 MB	10mm	N 39°2.648'	SP_Photopoint	146
SP_Photopoint_041.JPG	147	8.42 MB	18.2mm	N 39°2.655'	SP_Photopoint	147
SP_Photopoint_042.JPG	148	7.91 MB	10mm	N 39°2.740'	SP_Photopoint	148
SP_Photopoint_043.JPG	149	8.48 MB	10mm	N 39°2.772'	SP_Photopoint	149
SP_Photopoint_044.JPG	150	8.19 MB	10mm	N 39°2.770'	SP_Photopoint	150

DATE: DEC 6, 2012; DE	VICE: NIKON1V2	2 w/ 10-30mm Ler	ns & GP1000 GPS	Unit; MAP DATUI	M: WGS-84; IMAGE SIZE	: 4608x3072
File	Photo #	File Size	Focal Length	Latitude	Longitude	Altitude
HM_0002.JPG	90	8.47 MB	10mm	N 39°0.844'	W 105°21.853'	2422.00m
HM_0003.JPG	91	6.79 MB	10mm	N 39°0.830'	W 105°21.893'	2431.00m
HM_0004.JPG	92	7.91 MB	10mm	N 39°0.837'	W 105°21.834'	2414.00m
HM_0005.JPG	93	8.21 MB	21.9mm	N 39°0.794'	W 105°21.848'	2420.00m
HM_0006.JPG	94	8.36 MB	30mm	N 39°0.887'	W 105°21.721'	2421.00m
HM_0007.JPG	95	7.43 MB	10mm	N 39°0.890'	W 105°21.724'	2418.00m
HM_0008.JPG	96	7.38 MB	10mm	N 39°0.870'	W 105°21.713'	2417.00m
HM_0009.JPG	97	8.45 MB	10mm	N 39°0.882'	W 105°21.689'	2408.00n
HM_0010.JPG	98	8.61 MB	10mm	N 39°0.896'	W 105°21.687'	2423.00n
HM_0011.JPG	99	7.94 MB	10mm	N 39°1.135'	W 105°21.627'	2411.00m
HM_0012.JPG	100	8.35 MB	10mm	N 39°1.132'	W 105°21.653'	2406.00n
HM_0013.JPG	101	8.29 MB	10mm	N 39°1.135'	W 105°21.601'	2406.00n
HM_0014.JPG	102	8.29 MB	10mm	N 39°1.117'	W 105°21.621'	2401.00n
HM_0015.JPG	103	8.51 MB	10mm	N 39°1.163'	W 105°21.581'	2407.00n
HM_0016.JPG	104	8.51 MB	10mm	N 39°1.141'	W 105°21.588'	2408.00r
HM_0017.JPG	105	8.93 MB	10mm	N 39°1.141'	W 105°21.555'	2408.00r
HM_0018.JPG	106	8.07 MB	10mm	N 39°1.153'	W 105°21.550'	2408.00r
HM_0019.JPG	107	8.50 MB	10mm	N 39°1.474'	W 105°21.301'	2402.00r
HM_0020.JPG	108	8.44 MB	11.8mm	N 39°1.497'	W 105°21.279'	2384.00r
HM_0021.JPG	109	8.86 MB	11.8mm			
HM_0022.JPG	110	7.57 MB	11.8mm	N 39°1.455'	W 105°21.258'	2398.00r
HM_0023.JPG	111	8.61 MB	10mm	N 39°1.489'	W 105°21.283'	2404.00r
HM_0024.JPG	112	8.44 MB	10mm	N 39°1.472'	W 105°21.285'	2402.00r
HM_0025.JPG	113	7.28 MB	10mm			
HM_0026.JPG	114	8.62 MB	10mm	N 39°1.474'	W 105°21.256'	2410.00r
HM_0027.JPG	115	8.47 MB	10mm	N 39°1.430'	W 105°21.308'	2406.00r
HM_0028.JPG	116	7.86 MB	10mm	N 39°1.408'	W 105°21.321'	2408.00r
HM_0029.JPG	117	8.39 MB	10mm			
HM_0030.JPG	118	7.67 MB	10mm	N 39°1.422'	W 105°21.274'	2399.00r
HM_0031.JPG	119	8.68 MB	10mm	N 39°1.142'	W 105°21.613'	2411.00r
HM_0032.JPG	120	6.27 MB	10mm			
HM_0033.JPG	121	8.07 MB	10mm	N 39°1.124'	W 105°21.599'	2390.00r
HM_0034.JPG	122	7.29 MB	10mm	N 39°1.137'	W 105°21.576'	2395.00r

File	Photo #	File Size	Latitude	Longitude	Altitude	Headin
DSC00010.JPG	10	854 KB	N 39-0.505'	W 105-21.824'	2423.84m	83
DSC00011.JPG	11	1.00 MB	N 39-0.531'	W 105-21.796'	2425.91m	85
DSC00012.JPG	12	1.00 MB	N 39-0.553'	W 105-21.818'	2424.65m	36
DSC00013.JPG	13	1.10 MB	N 39-0.556'	W 105-21.836'	2425.63m	73
DSC00014.JPG	14	1.39 MB	N 39-0.573'	W 105-21.844'	2426.03m	243
DSC00015.JPG	15	1.08 MB	N 39-0.582'	W 105-21.836'	2424.99m	120
DSC00016.JPG	16	1.01 MB	N 39-0.614'	W 105-21.843'	2424.72m	187
DSC00017.JPG	17	875 KB	N 39-0.668'	W 105-21.858'	2423.36m	93
DSC00018.JPG	18	901 KB	N 39-0.677'	W 105-21.853'	2425.69m	65
DSC00019.JPG	19	1.32 MB	N 39-0.719'	W 105-21.865'	2424.56m	342
DSC00020.JPG	20	1.31 MB	N 39-0.725'	W 105-21.883'	2424.01m	252
DSC00021.JPG	21	896 KB	N 39-0.735'	W 105-21.906'	2424.12m	212
DSC00022.JPG	22	1.11 MB	N 39-0.747'	W 105-21.916'	2424.90m	104
DSC00023.JPG	23	797 KB	N 39-0.768'	W 105-21.929'	2425.46m	218
DSC00024.JPG	24	1.16 MB	N 39-0.769'	W 105-21.928'	2424.94m	109
DSC00025.JPG	25	958 KB	N 39-0.801'	W 105-21.930'	2425.96m	136
DSC00026.JPG	26	1.15 MB	N 39-0.813'	W 105-21.926'	2425.17m	64
DSC00027.JPG	27	1.25 MB	N 39-0.820'	W 105-21.920'	2424.38m	214
DSC00028.JPG	28	973 KB	N 39-0.837'	W 105-21.888'	2429.12m	178
DSC00029.JPG	29	1.05 MB	N 39-0.854'	W 105-21.872'	2427.71m	211
DSC00030.JPG	30	1.35 MB	N 39-0.849'	W 105-21.847'	2424.40m	224
DSC00031.JPG	31	1.27 MB	N 39-0.850'	W 105-21.832'	2424.55m	333
DSC00032.JPG	32	1.24 MB	N 39-0.826'	W 105-21.810'	2423.06m	341
DSC00033.JPG	33	1.12 MB	N 39-0.807'	W 105-21.822'	2424.59m	114
DSC00034.JPG	34	962 KB	N 39-0.813'	W 105-21.770'	2423.25m	33
DSC00035.JPG	35	1.09 MB	N 39-0.813'	W 105-21.758'	2423.05m	150
DSC00036.JPG	36	0.97 MB	N 39-0.842'	W 105-21.713'	2423.60m	309
DSC00037.JPG	37	1.19 MB	N 39-0.840'	W 105-21.713'	2423.53m	61
DSC00038.JPG	38	975 KB	N 39-0.861'	W 105-21.712'	2422.51m	354
DSC00039.JPG	39	988 KB	N 39-0.876'	W 105-21.707'	2422.30m	119
DSC00040.JPG	40	1.32 MB	N 39-0.908'	W 105-21.624'	2433.08m	133
DSC00041.JPG	41	1.36 MB	N 39-0.909'	W 105-21.624'	2432.59m	9
DSC00042.JPG	42	1.21 MB	N 39-0.905'	W 105-21.640'	2430.44m	134
DSC00043.JPG	43	1.37 MB	N 39-0.906'	W 105-21.641'	2430.28m	44
DSC00044.JPG	44	1.26 MB	N 39-0.908'	W 105-21.654'	2429.29m	25
DSC00045.JPG	45	1.30 MB	N 39-0.924'	W 105-21.672'	2427.53m	20
DSC00046.JPG	46	1.06 MB	N 39-0.932'	W 105-21.686'	2424.48m	318
DSC00047.JPG	47	1.22 MB	N 39-0.934'	W 105-21.686'	2424.85m	53
DSC00048.JPG	48	1.28 MB	N 39-0.954'	W 105-21.694'	2423.60m	278
DSC00049.JPG	49	1.14 MB	N 39-0.959'	W 105-21.705'	2423.89m	353

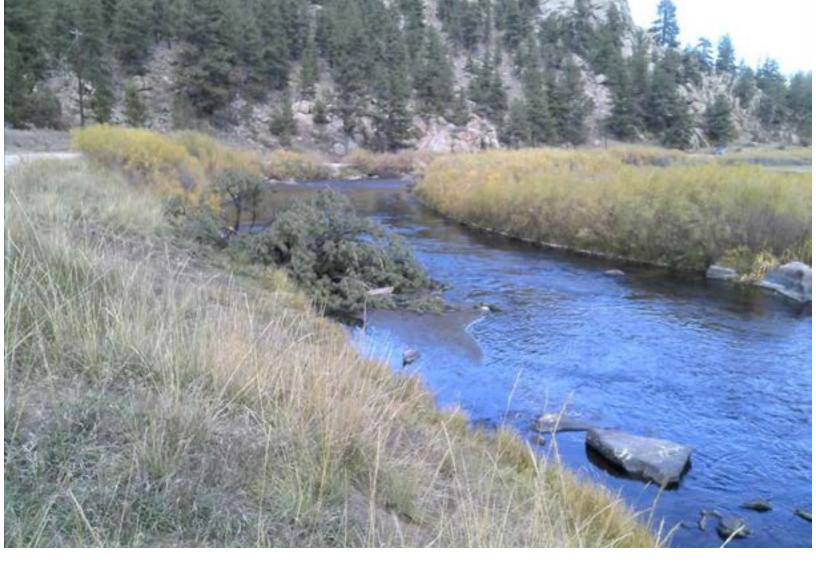

APPENDIX C

HEC RAS

This pre-project Hec Ras data will be compared to a model run in 2014 or 2015.

Reach	Rover Sta	Profile	C Total	Mir Ch ET	W.S.Elm	CHEW.S.	E.G. Elev	E.G. Stope	VielChris	Film Armi	Top Wrote	Freuda # CH
			(0%)	010	(7)	00	(1)	(8.9)	(85)	(91 20)	(70)	
Happy Meadows	000	min.	32.00	7864.61	7866.99		7867.01	0.000809	1.29	24.86	19.48	0.2
Alipipy Montowis	099 .	1.96	160.00	7864.61	7867.87		7888.12	0.003884	3.13	61.10	34.22	0.4
tappy Meadows	000	2.4	425.00	7854.61	7868.99		7909.34	0.005220	4.76	89.42	39.20	0.0
Happy Meetows	1999	ŝγ.	550.00	7864.61	7969.61	-	7870.12	0.005724	5.75	119.51	74.16	0.8
tappy Meadows	000.	10.40	549.00	7804.61	7309.84	7809.14	7870.52	0.007063	0.09	139.70	119.67	0.6
Happy Meatows	1999	50 yr	1351.00	7854.81	7870.75		7871.12	0.003789	5.80	382.15	312.19	0.5
and the second	199	100 yr	1810.00	7894.61	7871.08		7871.38	0.003083	5.51	420.01	325.47	0.4
Leppy Meedium		and the second se	· · · · · · · · · · · · · · · · · · ·		the second s						and the second sec	
Plappy Meadows	699	\$00-yr	2335-00	7854.81	7871.82		7872-08	0.007208	5.29	739.57	363.70	0.4
	-					-					200.000	
Happy Mascones	098	10	32.00	7855.01	786.91		7856.92	0.000239	0.54	19.62	70.82	0.1
Happy Meetines	1098	1.98	180.00	7800.01	7987.74		7867.77	0.000720	1.25	577.55	96.72	0.1
Happy Meadows	098	1.4	426.00	7865.01	7908.85	-	7858 91	0.000726	.1.09	252.69	127.69	0.2
Happy Moscows	095	DW.	960.00	7865.01	7869-01		7869-85	0.000659	7.81	397.88	245.81	0.2
Happy Mescowe	096	10-ye	. \$45.00	7865.01	7869.93	1	7859.99	0.000673	1.98	478.87	250.86	0.2
Happy Milocows	090	50 yr	1357.00	7805.01	7822.06	V	7870.73	0.000685	2.33	865.42	204.33	0.2
Happy Milodows	0000	500 yr	1810.00	7905.01	7870.94		7871.03	0.000723	2.52	741.48	276.55	0.2
Happy Meadows	096	500-yr	2335-00	7805.01	7571.04		7871.75	0.00079/2	2.95	944.50	313.68	0.2
Happy Meetows	697	a.a.	32.00	7855.53	7886.90	7858.44	7855.91	0.001507	0.89	35.97	79.23	0.2
Happy Miccows	697	1.98	180.00	7805.53	7967.72		7967.75	0.001150	1.47	108.71	90.72	0.2
Happy Meedows	697	2.9	426.00	7855 53	7868.83	1	7358.50	0.000982	1.98	222.00	150 62	0.2
Phappy Mancows	1097	Syr	550.00	7805.53	/019.59	-	7859.54	0.001005	1.93	380.34	758 17	0.2
Happy Meeduws	89/	10.44	845.00	7985.53	/869.92	-	7859 16	0.000915	2.04	465.90	267.24	0.2
Happy Meadures	097	50 yr	1351.00	7805.53	7873-65		7873.72	0.000913	2.04	400.33	298.48	0.2
	1097		i and the second se		and the second second second	-		0.000874			Contraction of the Automation of	
Happy Massimes		100 yr	5810.00	7855.53	7870.93	-	7871,51	and the second se	2.47	752.45	298.80	0.2
Phyppy Maniform	197	300 yr	2336.00	/985.53	/8/1.83		1871,73	0.000843	2.83	\$72.51	332.44	0.2
	100											
Happy Meddows	090	10	32.00	7862.90	7863.78	7863.78	7854.07	0.029666	4.28	7.43	13.30	1.0
PEnppy Meadows	696	198	160.00	7862.92	7854.84	7854.84	7865.53	0.021084	6.64	24.11	17.83	1.0
Happy Moodows	000	2.91	426.00	7802.90	7868 19	7886.19	7855.04	0.020280	6.93	\$1.47	42.33	1.0
Happy Meedown	1000	5 yr	660.00	7862.99	786.70	7860.70	7867.08	0.018500	7.86	54.29	46.68	1.0
Hoppy Montows	099	20.94	\$46.00	7802.90	7967.08	7887.08	7868.18	0.016303	8-35	100.11	52.52	0.96
Happy Maadows	496	50 yr	1351.00	7962.90	7908.15	7968.15	7869.21	0.010162	9,62	182.57	107.76	0.8
Happy Meetows	996	100 уг	1812.00	7982.90	7968.64	7888.84	7869.58	0.007955	8.29	249.48	157.85	0.75
Happy Missdows	090	500 yr	2335.00	7962.90	7969.27	7009.27	7870.28	0.007710	9.01	355.90	177.58	0.7
	-	1										
Hoppy Mondows	#95.		32.00	7901.34	7883.04	7882.19	7883.06	0.000571	0.78	41.00	63.31	0.1
Happy Meadows	615	1.98	160.00	7961.34	7864.08		7864.10	0.000855	1.50	108.99	70.37	0.2
Happy Meedown	895		428.00	7801.34	7864.07		7855.00	0.001296	2.47	173.50	11.62	0.2
and the production of the second s		2.9	Concerning Concerning	and the second	and the second se	-		the second s	Contraction of Contraction			
Happy Mescowe	495	5yr	650.00	7851.34	7885.50		7855 65	0.001565	311	718.45	85.37	0.3
Happy Meetines	1995	10 yr	848.00	7901.34	7865.90		7866.09	0.001640	347	- 250.15	94.93	0.3
Hoppy Meadows	1095	50-ye	1351.00	7801.34	786.78		7557.01	0.001827	4.27	341.22	110,20	0.3
Happy Moodows	095	100 yr	1813.00	7801.34	7867.08	-	7857.42	0.001976	4.87	377.33	115.90	0.3
History Mesclows	695	500 yr	2335.00	1001.34	7887.76		7855.23	0.002459	5.11	459.57	128.08	0.4
	_											
Happy Meetines	684	anie.	32.00	7901.26	7661.72	P861.72	7861.88	0.050206	3.29	9.81	29.49	1,0
Happy Monclows	894	190	160.00	7961.20	7162.20	7862.20	7862.47	0.027166	4.22	37.90	71.40	1.00
Hoppy Montows	094	24	426.00	7901.26	7863.03		7963.31	0.008316	4.24	100.40	76.58	0.60
Happy Meadows	1894	5yr	860.00	7861.26	7863.84		7854.09	0.004049	4.05	163.73	81.34	0.4
Happy Meddows	494	10 yr	\$46.00	7801.26	7964.13		7994.45	0.001304	4.55	189.33	98.93	0.50
Happy Mastows	1994	50 yr	1351.00	7861.26	7804.76	1	7885.22	0.004662	5.54	278.84	208.28	0.54
Heppy Menciows	163-6	100 yr	1613.00	7901.29	7865-02		7885.51	0.004836	5.87	334.41	221.99	0.6
Pleppy Meadows	1034	500 yr	2335.00	7901.25	7885.67		7856.18	0.004153	6.23	433.49	249.15	0.50
and and a state of the	-						100.0					
Happy Massionis	093	wie.	32.00	7858.31	7903.39		7850.40	0.000181	0.61	52.17	41.14	0.1
the substitution of the su	093		180.00	7858.31	7881.31		7861.38	0.000872	1.71	80.81	61.33	0.2
Hoppy Montown		1.91		And the second second second	and the second			the second se		the second se	Concerning the second sec	
Happy Mass cows	693	24	426.00	7858.31	7802.17		7862.31	0.001892	3,04	139.94	56.01	0.3
Hisppy Meedows	090	5 yr.	880.00	7858.31	7982.82	-	7853.00	0.003731	3.41	194.01	114.43	0.4
Happy Mascows	693	10.97	\$45.00	7858.31	7863-15		7663.38	0.003440	3.68	232.27	118.10	0.45
Happy Milocows	093	50 yr	(351.00)	7858.31	7903.95	-	7864.20	0.002731	6.07	368.50	220.16	0.43
Happy Mascows	693	100 yr	1813.00	7858.31	7%64.27		7864.53	0.002528	4.20	440.85	229.98	0.4
Happy Meedows	693	500 yr	2336.00	7858.31	7865.01		7885-30	0.002265	4.57	621.08	269.26	0.4
Happy Mustress	892	aniar.	32.00	7858.99	7900.14	7860.14	7850.29	0.036731	3.17	10.09	36.29	1.0
Happy Ministows	692	1.9r	160.00	7858.99	7981.04		7901.12	0.004067	2.22	72.25	85.34	0.4
Happy Madows	892	2.90	426-00	7858.99	7961.81		7851.95	0.003458	2.99	143.60	98.32	0.43
Happy Meetines	692	syr	850.00	7858.99	/962.52		7862-50	0.003195	343	199.40	110.89	0.43
Happy Meethwa	692	10 97	846.00	7858.99	7962.70		7852.91	0.002540	3.94	241.70	128.12	0.4
Happy Monitores	692	90 yr	1351.00	7858.99	7883.60		/983.84	0.007268	4.03	388.15	737.93	0.3
	892	100 yr	1813.00	7858.99	7883.96		7854.19	0.002040	4.10	473.53	242.89	0.3
Happy Meadows	892	500 yr		7858.90	7864.75	-	7985.00	0.001778	4.37	873.54	275.13	
Hoppy Measures	and a	and	2336-00	1 808 99	1004-10	-	1985-00	0.001078	3/	4/8.94	21813	.0.5
	1					-		-				
Happy Monteen	1001	89	32.00	7868.29	7859.92		7859-54	0.000943	1.05	31.74	40.94	0.2
Happy Mandows	(691	198	160.00	7858.22		_	7850.94	0.001653	1.00	86.18	67.43	0.21
Hoppy Meedows	001	24	426.00	7858.20	7861.58	· · · · · · · · ·	7861.73	0.002847	3.21	132.01	88.72	0.4

Read	-Rover Sta	Profile	Ci Total	Me Ch D	W.S.Ehm	CHW.E	E.G. Ebra	E.G. Skope	Vel Duri	Film Area	Top Weth	Froute # Chi
			(ch)	(20)	(75)	010	(71)	(8:8)	(0/10)	010 #2	(70	
Reppy Meddows	091	Syr-	550.00	7858.20	7802.01		7842.27	0.003477	4.00	163.25	73.46	0.4
Happy Meedows	001	10-94	840.00	7858.20	7662.36		7952.58	0.003619	A.53	187.97	72.55	0.4
Huppy Municipal	891	50 yr	5361.00	7868.20	7863.29		7863.43	0.003632	5.35	282.78	150.91	25
Happy Mendows	601	100 yr	1610.00	7858.20	7863.53		7863.20	0.003499	5.85	338.24	182.04	0.6
Happy Meedows	891	500 yr	2335.00	7858.20	7864.34		7854.82	9.003137	6.04	513.53	264.55	3.6
Control of the second	1.001	force la	10000.00				10000.000			2-2.00		
Huppy Musciowa	890		32.00	7858.25	7858.97	7858.97	7859.10	0.007367	2.94	13.88	43.97	1.0
the start of the first dependence of the start start	490		180.00	7858.2%	7859.40	7859.40	7859-55	0.009627	4.07	39.35	79.42	1.0
Hoppy Munitors	and the second se	14		the second se	and the second se	CB (0/01)		successive and the paper in the second			and the second sec	
Happy Masclows	690	2.7	426.00	7858.25	7603.24		7860.46	0.007204	373	114.30	9191	0.5
Happy Meedows	680	SW.	660.00	7858.25	7861.00		7861.20	0.003635	3.56	185.23	34.39	0.4
Happy Miedows	680	10 W	. 940.00	7858.25	7901.50		7661.71	0.002813	3.64	232.82	97.44	0.4
Happy Meetows	890	50-97	1361.00	7858.25	7802.58		7882.80	0.002291	3.93	378.20	188.47	0.3
Happy Mandows	690	100 yr	1810.00	7858.25	7862.941		P863.19	0.001903	4.08	450.11	189.59	0.3
Happy Mexicous	690	500 yr.	2335.00	7858.25	7863.83		7804.10	0.001701	4.42	647.64	248.15	0.3
							10.000					1
Happy Mextown	889.7	enier.	32.00	7855.89	7857.48		7857.50	0.001340	1.00	32.00	54.14	9.2
Happy Macdows	689.7	1.98	180-00	7855-89	7858.52		7858.56	0-001002	1.57	102.48	76.62	0.2
Happy Mancione	6897		428.20	7855.89	the second s		7858-90	0.000791	2.07	213.05	82.58	. 5.9
and the second se	689.7	24	660.00				construction of the second second	and the second second second second second	and the second se	317.75	149.57	
Hoppy Mapdows		×4		7855.89	7960 70		7860 77	0.000698	2.16			0.2
Happy Mendows	689.7	10.97	\$46.00	7855.89	7861.26		7861.33	0.000628	2.21	402.19	154.60	0.2
Happy Masdows	689.7	50-yr	1351.00	7855.89	7862.38		7802.47	0.000576	2,47	605.37	200.79	0.2
Hippy Maintows	889.7	100 yr	1610.00	7855.89	7862.76		7862.88	0.000600	2.84	683.32	211.60	0.2
Huppy Monitors	16363.7	300 yr	2036-00	7855.80	7963.84		7MIX 77	0.000668	3.06	882.66	241.02	9.2
1000 (A) (A)	0.000	10000		1-11.5	2-0223313		1000			112		
Happy Meedows	689	ete.	32.00	7854.98	7856.81		7856.84	0.001874	1.43	72.39	28.55	0.25
Happy Mantows	689	tyr.	160.00	7854.98	7858.04	-	7858.09	0.001288	1.73	82.33	06.19	0.2
Happy Muchows	889	2.0	426 30	7854.98	7869.47		7850-55	0.000885	2.24	190.39	72.88	0.24
Happy Meadows	689	5 yr	650.00	7254.98	7860.35		7860-45	3.500627	2.61	259.81	85.18	0.2
Happy Mentows	669	10-97	846.00	7854.98	7853.90		7661.00	0.000625	2.85	339.71	91.05	0.25
CALL NO. A DESCRIPTION OF THE OWNER	669		1351 00				and the second se		3.51		117.57	0.27
Happy Mondows		50 yr		7854.98	7861.98		7842.17	0.000911		423.64		
Happy Maudows	589	100 yr	1610.30	7854.98	7862.31		7852 53	0.501502	3.89	442.97	124.80	0.25
Happy Mastows	689	500-yr	2336.20	7854.98	7883.05		7893.38	9.001340	.481	567.57	142.08	0.34
1000 CONT	122	1000	-					20000		1.00	1	
Happy Mascows	668	##	32.30	7854.14	7858.82		7856.82	0.000014	- 泉淀5	549.89	85.19	0.03
Hoppy Meedows	665	1.97	160.00	7854.14	7858.04		7858.04	0.000064	2.64	253.33	90.52	0.0
Happy Mandows	688	2.10	428.00	7854.14	7859.47		7859.48	0.000118	1.13	423.04	142.87	0.09
Happy Mexicon	888	byr .	6tt0 30	7854.14	786335		7860 38	0.000141	1.38	542.44	189.41	di 11
Happy Mexicous	688	30-ye	848.00	7854.14	7863.91		7860.94	0.000/154	1.54	540.93	180-81	0.11
Happy Messiows	688	50-yr	1351.00	7854.14	7562.01		7862.06	0.000191	1.93	849.83	200.16	0.13
	968	100 yr.	1910.00	7854.14	7902.34		7962.40	0.0002222	2.15	917.50	205.65	0.14
Happy Meadows	688		the second s	the second se			contraction of the lagest first or the lag	and the second se		and the second	the second s	
Happy Maintees	1008	\$00 yr	2335.00	7854.14	7863.10		7863.19	0.500307	2.75	1281.84	223.30	0.13
			80.00		2000.000						-	
Happy Mentows	887	arian	32.50	7854.80	7856.82		7858 82	0.000058	0.33	98.64	79.22	0.0
Happy Meadows	687	1.75	160.00	7854.80	7858.02		7858.03	0.000/143	0.83	193.89	83.08	0.06
нарру Маллоня	487	2.9	4,26.00	7854.80	7859.43		7859-46	0.500210	1.37	319.81	96.19	0.12
Happy Meetows	1887.	5 yr	660.00	7854.80	7860.31		7880.35	0.000345	5.89	415.54	135.30	0.14
Huppy Meactows	557	10-yr	848.00	7854.80	7963.96		7880 92	3 900264	1.89	494.55	547.28	0.15
Happy Mendows	687	50-yr	1351.00	7854.80	7851.94		7862-32	3 000320	2.38	665-D1	168.39	0.17
Happy Metcowe	687	100 yr	1010-00	7864.80	7862.26		7802.30	0.000372	2.63	720.12	174.64	0.18
Happy Mentows	687	500 yr	2335-30	7854.80	7862799		7883 14	3.3005/12	3.31	852.24	188.78	0.2
Hoppy Montown	888	e.e	37.10	7855.41	1858.73		7856.79	0.003331	1.94	18.53	22.48	0.5
the second s	885		180.00	7855.41	785673		7857.95	0.006308	3.98	43.18	25.99	0.5
Happy Measons	1000	1.97.		the second s			and the second se	and the second se				
Happy Meedows	688	2.9	626.00	7855.41	7858.78		7859-33		5.97	72.72	35.97	0.60
Happy Mantowa	600	Syr.	880.00	7855.41	7850.40	100000	7860.19	0.007965	7.19	68.30	46.62	0.73
Happy Meadows	550	10-yr	\$48.00	7255.41	7850.74	7859.45	7860.72	0.006892	8.15	114.88	53.18	0.75
Happy Manizon	665	50.yr	1351.00	7856-41	7800.91	7860.91	7881.83	0.000328	6.38	223.21	140.18	0.69
Happy Meedows	080	100 yr	1810.00	7855-41	7981.20	7861.20	7862.15	0.006347	8.75	285.72	148.10	0.70
Happy Missiows	680	500 yr	2335.00	2865-41	7501.82	7861.82	7862.60	3.006703	9.75	383.22	104.04	0.74
and the second	1.000		1					1			1	
Huggy Mundows	885		32.00	7854.78	7866.27		7856.28	0.001304	0.97	33.04	67.81	0.25
Hoppy Mundows	685	191	160.00	7854.75	7867.33		7857.37	3.501012	1.68	35.52	59.57	0.22
Happy Meadows	\$85	2.4	420.00	7854.75	7858.50		7858.60	0.001154	2.55	168.72	FD 14	0.2
Happy Mandows	885	5 yr	660.00	7854.75	7859.21		7859.36	0.001238	3.09	231.65	137.64	0.2
Нарру Маллона	685	10 yr	546.00	7854.75	7858-05		7859.81	0.001259	3.37	297.42	169.72	0.3
	885			7854.75			7859-31	0.001225	3.80	4/1.03		0.3
Happy Matchine		50 yr	1351.00								213.65	
Парру Меллоня	685	100 yr	1810.50	7854.75	7803.89		7861.06	0.001199	3.95	548.79	216.37	0.3
Happy Mexidows	685	500 yr	2335.00	7854.75	7801.74		7801.96	0.001173	4.32	737.94	733.44	0.3
Happy Meedows	884.8	**	32.00	7852.95	7863.83		7854.02	0.006504	2.32	13.12	29.61	0.5
Happy Mandows	684.8	591	180.00	/852.95	7855.18	7854.51	7855.37	0.007778	3.92	45.42	42.83	0.6
Happy Mansows	684.8	2.9	428.30	7852345	7855 98	7855.81	7856.31	0.008946	4.61	90.42	83.38	0.6
Happy Mancows	551.8	Syr.	660.00	/852.95	7856.38	7856 01	7856.85	0.0150007	5.58	198.02	/0.05	
Hoppy Mandows	554.5	10 yr	846.00	7852.95	and the second se	7856.30	7857.24	0.010491	6.18	139.06	73.81	0.76
Нарру Массоня	554.8		1351.00	7852.95	and the second sec	7858.99	7858.13	and the second second second second	7.10	195.11	89.19	
	10000	190.98	1001.00	1004.09			1008.13	4.417.464	1.19	1999-11		41

Heath	River Stat	Profile	Q Tutal	Mir Ch El	W.B.Ehv	CritW.S	E.O. Ehry	E.G. Skope	Vil Chril	Flow Artst	Top Wildte	Froute # CH
			0:00	010	080	110	170	(8/8)	(8/4)	data #0	00	
Inppy Mentiows	084.8	100 yr	1810.00	7852.95	7857.63	7857.32	7858.50	0.011733	7.57	220.78	101.21	0.0
Pappy Meadows	684.8	500-yr	2335.00	7852.95	7858.17	7858.09	7859-34	0.012672	8.83	278.85	109.72	0.0
toppy Manitown	664	100	32.00	7944.82	7845.88	7845.88	7848.00	0.0300000	3.07	10.18	35.32	0.1
toppy Munitown	554	1.91	160.00	7944.82	7940.32	7846.327	7545.60	0.027368	4.24	37.78	70.87	1.0
	054		426.00	7864.82	7946.81	7846.81	7647.29	0.023127	5.55	76.79	94.60	1.
Roppy Mechows		3×			and the second strends				\$.79	in the second se		
toppy Maniform	884	59	\$60.00	7564.82	7847.14	7847.14	7567.76	0.020018		104.94	85.88	9.4
foppy Mustions	554	10-yr	848-00	7844.82	7847.37	7847 57	7848.00	876810.0	6.81	124.28	\$6.37	1.
Reppy Mentows	084	50 yr.	1351.00	7844.82	7847.88	7847.88	7848.87	0.017474	7.98	169.41	87.85	
tappy Meations	0.04	100 yr	1910.00	7644.82	7948.12	7848.12	7849.24	0.010860	8.47	190.49	. 88.71	1.
tappy Maclovis	584	500 yr	2935.00	7544.82	7948.76	7548.76	7850.19	0.015145	9.51	247.33	90.99	51
	100	1.		1	1.000.000						1993	· · · · ·
Keppy Missiows	983	anian.	32.00	7835.71	7836.71		7838.72	0.000219	0.71	44.82	31.55	
inppy Monthows	483	t yr	160.00	7835 71	7640.06		7640.10	0.000582	1.55	103.30	47.95	0
Suppy Meethows	583	24	428.00	7835.71	7941-43		7841.53	0.000804	2.51	171.89	54.78	0.
	583	a second second	660.00	7635.71	7542.28		7842.43	0.000941	3.09	225.68	84.87	
Inppy Metitows	and the second se	59		and the second se						in the second seco		0.
toppy Monitows	683	10-yr	848.00	7835.71	7842.84		7843.02	0.000967	3.40	278.44	PP.05	0.
Sappy Meadows	583	250-yr	1351.00	7835.21	7844.15		7844.38	0.000947	3.93	431.29	182.97	0.
cappy Montows	683	100 yr	1613.00	7830.71	7844.01		7844.83	0.000968	-6.15	503.60	162.48	
Isppy Mexitows	683	500-yr	2335.00	7835.71	7915.37		7845.67	0.001183	4.95	832.47	175.09	<u>ା</u> ୍ରକ୍
	150.05	1975	1000000	1.533/01	1.000	112 3.20		A Providence			2000	S
toppy Mentours	68.2	mir.	32.00	7837.51	7808.27	7858.27	7838.47	0.0298377	3.67	8.63	22.06	8.
toppy Meantown	682	1-yr	180.00	7837.51	7839-01	7839.01	7839-51	0.072339	5.69	28.12	28 95	
fuppy Meetows	682	2.91	425.00	7837.51	7839.95	1839.95	1840.76	0.018618	7 22	59.01	36 85	1
fappy Mesthows	682		660.00	7837.51	7840.51	7842.51	7841.57	0.017356	8.28	79.94	38.12	1
	682	5 yr 10 yr	865.00	7837.51	7940.01	7540.00	7941.07	0.019801	8.93	94.75	38.88	
Toppy Meachows		distant	and the second se	and the state of the state of	And the second se	and the second se		and the second se		the second se		
sappy Meations	682	53-97	1351.00	7637.51	7661.80	7841.80	7843.66	0.014965	15.37	131.70	44.85	
Roppy Meanows	68.2	100 ye	1610.00	7837.51	7842.53	7842.53	7844.01	0.010392	2.65	179.58	\$7.83	0.
tappy Meadows	682	500-yr	2335.00	7837.51	7543.70	7543.70	7544.50	0.006740	3,41	334.14	153.96	. 0.
705-20 A. L. A. L.	1000	17586		3 30.000	5.518.61		1000	- Allowing -		- Contraction		
toppy Meadows	681	pear.	32.00	7835.81	7937.43		7537.44	0.000272	0.67	47.45	43.92	
Roppy Monores	681	t.yr	180.00	7835.81	7838.38		7838.43	0.000909	1.75	81.62	49.80	0.
toppy Munitows	681	24	428.00	7835.81	7839.28		1839.43	0.001754	3.11	137.19	51.25	
hoppy Montlows	681	5.10	880.00	7835.81	F830-86		7843.13	0.002188	3.95	168.47	56.63	0.
	681		845.00	7835.81	7810.25		7640.57	0.002449	4.51	192.10	\$6.76	0.
toppy Mexicous		10-yr										
tappy Meetows	681	50 yr	1351.00	7835.81	7561.19		7641.65	0.002639	5.44	283.62	113,27	0,
tappy Meetines	1681.	100 yr	1810.00	7836.81	78(1.59		7842.06	0.002549	578	331.22	126.68	0.
Карру Мангоник	581	500-pr	2325.00	7835.81	7842.59		7843.12	0.002481	6.30	4.0.7.034	1/3.10	0.
	1.5.	1.32		1	·					1.00		
Toppy Musicipus	580	periet.	37.00	7835.99	/83/39		7837.41	0.001868	1.18	27.75	44.91	. 0.
toppy Meericen	\$80	t yr	180.00	7835.90	7838.29		7838.36	0.002322	2.10	76.12	57.68	
Suppy Meetines	683	24	426.00	7835.99	7839.13		7838.31	0 002814	3 35	1,27/36	63.38	0.
	680		960.00	7835.99	7839.71		7839.96	0.002994	4.05	165.08	66.93	0.
tuppy Mealtows		5 11			and the second se			and the second se	4.49	Contraction of the second s		
Tappy Maschows	580	10-yr.	848.00	7835.99	7640.11		7840.42	0.003061		192.77	73.85	0.
tappy Mantown	685	53-yr	1351.00	7835.99	7811.04		7541.47	0.003328	5.34	276.53	104.67	0.
Rappy Machines	493	100-14	1810.00	7835.99	7841.44		7841.91	0.003008	5.67	325.90	120.51	0.
Rappy Mostows	480	500-yr	2335-00	7835.99	7912.49		7642.96	0.002682	6.15	464.20	150.09	0.
		1.1										
Reppy Montows	678	Jeni l	32.00	7836.01	7836.77	7636.72	7838.95	0.020662	3.54	9.59	20.65	- 0.
toppy Meetown	679	1.91	160.00	7836.01	7837.96		7838.02	0.004775	2.11	75.90	109.68	0
toppy Munitown	5/2	24	429-00	7836.01	7838.97		1839.04	0.001647	2.20	195.84	119.09	
Rappy Meattown	579	Syr	660.00	7636.01	7839.81		7839.71	0.001305	2.64	271.57	121.91	0
loppy Meatows	679		845.00	7836.01	7940.05		7543.16	0.001193	2.62	325.04	123.55	0.
	and the second se	10-yr	1351.00	and the second se	and the second se		and the second s	successive and the other in the local data of the			the second s	
Reppy Meatlows	679	50-yr		7836.01	7841.06		7841.20	0.001.068	3.04	451.00	120.25	0.
Leppy Metchen	679	100 (4	1810.00	7836.01	7045.47		7941.65	0.001.063	3.76	505.59	130.09	0.
tippy Mectows	579	500-yr	2535.00	7636.01	7842.50		7542.71	0.001027	1.73	655,92	155.75	
toppy Munctowe	878	10.01	302.00	7834.50	7938.58		7838.59	0.000521	0.81	39.41	45.07	
inppy Munitous	678	1.97	180.00	7834.58	7857.68		7837.63	0.001081	1.74	91.83	57.82	0.
Inppy Menhows	678	2 17	426.00	7834.58	7838.61		1838.73	0.001491	2.77	167.18	79.83	0.
hippy Man/10wa	678	Sy.	960.00	7834.59	7839.25		7839-42	0.001573	3.31	217.95	104.35	9.
tuppy Muscows	678	10-97	848.00	7834.59	7839.09		7839.85	0.001557	3.59	204.91	109.33	0.
	678		1351.00	7834.59	TIMO OF		TIMO IN	0.001535	4.20	365.04	13/7.172	3
тарру Маклоня		50-yr	Contraction (Section (Section))					Contraction in the second second second second		and the second se		
Reppy Mentiows	678	100 pr	1010.00	7854.59	7641.11		7841.37	0.001508	4.41	443.77	143.81	
tappy Meadown	478	500 yr	2336.00	7834.59	7942.10		7842.46	0.001435	4.87	607.69	169.50	
Ipppy Meadows	877	min (32.00	7834.59	7830.51		7838.52	0.000607	0.80	45.17	53.05	
Reppy Munctown	477	1.97	180.00	7834.59	7837.48		7837.50	0.001094	1.69	94.76	60.03	0
feppy Munitown	477	2.4	428.00	7834.59	7838.44		1838.55	0.001462	2.74	156.85	64.87	. 0
	877				7859.04				341			
fuppy Meathers		34	550.00	7834.59			7839.22	0.001694		198.89	72.28	
fappy Mestows	677	10-yr	645.00	7834.59	7839.45		7639.68	0.001825	3.84	229.17	76.92	. 0.
	077	50-yr.	1351.00	7834.59	7910.38		7840.72	0.002963	4.76	321.57	149.25	0
Happy Meadows					The second second		Tenant and	0.001975		2467 24	100 million at 100	
	677	100 yr	1910.00	7834.59	7840.81		7841.18	10.00 (BCD)	4.99	367.71	359.11	

Reach	River Blat	Profile	C Total	Min CP EI	W.B.ENV	CHLW.II.	E.C. Dev	E.O. Skopo	Vol Ohrli	Flow Artis	Top With	Finance # CH
			(chi)	00	(7)	(70)	(11)	(8.9)	(5%)	(w; #)	(2)	
loppy Mondows	676	P.0.	32.00	7835 19	7835.94	7835.94	7836.22	0.029580	4.23	7.57	15.04	1.0
Toppy Meadows	876	Tipe	160.00	7835.19	7836.79	Ú	7837.09	0.016850	×.36	36.71	45.00	0.8
Toppy Mendows	676	2.94	428.00	7835.19	7637.61		7838.05	0.012054	5.33	79.03	57.24	.0.7
Happy Monitows	078	5 yr	660.00	7835.19	7838.08	1 I I I I I I I I I I I I I I I I I I I	7858.67	0.011257	6.12	107.66	60.28	0.8
тарру Менлоня	878	10-ye	846.00	7835.19	/15.ML38		7039.09	0.0110/8	8.59	126-82	102.57	08
Happy Mentown	878	50-j#	1351.00	7836.19	7(539.05	1	7840.07	0.011050	8.01	170.44	65.29	0.85
Happy Monitown	678	100 yr	1510.00	7805.19	7639.37	7839.11	7843.51	0.011179	8.61	189.59	65.48	0.8
Happy Meadows	878	500-yr	2536-30	7835.19	7839.93	7839-91	7941.62	0.013248	1049	227.58	68.53	0.94
	10.04	-	10.00	100.0	Tenna inte			0.0000000		20.40	1000	
Happy Maintows Happy Monitows	675	1.14	32.00	7834.60	7835.79 7836.45		7836.80 7830.57	0.000902	0.95	70.00	48.91	0.2
Happy Mandows	675		426.00	7834.90	7837.19		7837.41	0.004270	3.82	111.62	00.14	0.40
Happy Mandows	675	2.9	840.00	7834.90	7837.80		7837.96	0.005324	4.83	139.63	61.82	0.5
Happy Mondows	075	5 yr 10 yr	540.00	7834.80	7837.87	<u> </u>	7838.35	0.005969	5.53	153.59	64.11	0.0
Hoppy Mondows	875	50 yr	1361.00	7834.00	7838.46		7839.24	0.007524	7.12	194.27	76.18	0.7
Hippy Mondows	675	100 yr	1610.00	7834.60	7838.70	7838.10	7839.04	0.008178	781	214.37	91.21	0.75
Imppy Mandows	675	500-yr.	2335.00	7854.60	7838.36	7839.33	7840.57	0.008858	¥.06	296.38	149.44	0.60
					-							
Hoppy Mendown	674	TT	32.00	7834.79	7835.87		7836.68	0.005/112	1.32	24.19	74.12	0.4
Happy Mainteau	874	1.96	180.00	7834.79	/838.22	Q	7838.30	0.003958	2.18	73.39	87.43	0.4
Happy Mexicore	874	2.0	40% 30	7834.79	/838.88		/83/.01	0.004197	3.77	130.48	91.70	0.41
Happy Meetcown	874	syr	860.00	7834.79	7837.29		7837.52	0.004494	3.89	159.56	10.57	0.5/
Happy Meadowe	674	10.91	540.00	7834.79	7837.58	-	7837.85	0.004983	4.33	195.29	93.18	0.55
Happy Meadows	874	50-yr	1351.00	7834.79	/838.19		7838.63	0.004967	531	254.75	95.08	0.5/
Happy Meadown	874	100 yr	1610.00	1834.79	/938.48		7838.59	0.005060	5/3	- 281.77	96.09	0.58
Нарру Мердона	674	500 yr	2335-00	7854.79	7839.17	-	7539.87	0.005272	6.72	356.96	120.03	0.60
Happy Mondows	673	eie.	32.00	7833.02	7833.79	-	7833.84	0.006779	1.84	17.35	48.39	0.54
Happy Mendows	673	1.94	160.00	7833.02	7834.31		7834.48	0.013188	3.29	48.62	77.23	9.7
Happy Mechows	673	2.97	426.00	7833.02	7834.85		7835.17	0.012616	4.60	92.63	85.79	0.78
Happy Mondows	673		660.00	7833.02	7635.24	-	7835.06	0.010983	5.19	127.07	88.22	0.70
Hoppy Menticen	673	5 W 10-W	848.00	7/003-02	/#35.51		78288-00	0.010203	5.60	151.25	90.29	0.7
Hippy Manzown	1173	50 yr	1351-30	FR03-02	/\$36.12	-	7836.79	0.009/19	6.50	208.45	101 30	0.70
Hoppy Mentown	673	100 yr	1610.00	7833.02	7636.39	-	7637.13	0.009/157	5.95	236.34	105.94	37
Huppy Meadows	673	500 1	2535.00	/833.02	/#37.05		/838.00	0.008/33	7.91	309.27	123.23	0.73
	1.0											
Happy Musclows	672	**	32.00	7802.10	7833.00	7832.86	7833-09	0.010459	1.89	18.95	52.51	0.58
Happy Montows	672	1.91	160.00	7832 10	7833.60	7833.32	78.55.71	0.006754	2.67	81.02	82.40	0.54
Happy Monitores	672	24	426.00	7832.10	7834.35	2	7834.54	0.004701	3.44	124.03	80.98	0.50
Happy Membors	072	Syr	000.00	7832.10	7834.78	S	7835.04	0.004797	4.11	162.65	93.89	0.93
Happy Mondown	672	10 94	846.00	7832.10	7635.07	() () () () () () () () () ()	7835.38	0.004815	4.54	180.42	97.39	0.54
Hippy Moodows	072	50 yr	1361.00	7832.10	7835.71		7930.17	0.005076	5.53	254.98	107.58	0.94
Hippy Mondows	672	100 yr.	1610.00	7832.10	7835.99	S	7830.52	0.005173	5.94	285.30	110.57	-0.9
Happy Mentowe	672	500 yr	2335.30	7832.13	7636.68		7837.38	0.005261	6.86	367.67	126.52	0.60
	441.6		10.00	2000 00	2420.04		24240.728	0.00004.00		10.00	21.22	
Happy Mandows	671.5	min:	32.00	7878.69	7679.68	· · · · · · · · · · · · · · · · · · ·	7829 78	0.009543	2.48	17.90	24.39	0.60
Happy Machnes	871.6	1.9	160.00	7828.89	7830.43	7830.25	/830.71	0.012910			39.22	
Hoppy Mentows	871.6	2.9	428.00	7828.89	7831.18	7831.18	7631.68	0.073819	5.78	73.90	70.62	0.96
Hoppy Maintown	071.5	3 yr	946.00	7878.59	7851.55	7831.55 7831.76	7832.19	0.079104	6.91	107.57	81.08	1.0
Happy Mandows	671.5	10-pt -		7525.00	7637.52	7832.32	78.32.52	0.017444	8.04			1.0
Happy Mastoves	071.5	50 yr 100 yr	1351.00	7825.69	/832.52	7832.52	7833.52	0.016589	8.04	199.17	87.92	1.0
Happy Meadows Happy Meadows	071.5	500 yr	2335.00	7525.09	7832.57	7833.21	7830.68	0.014540	8.51	249.94	89.59	0.94
		-		1 00.01 010		10.012.1	10.04.00	20.000	2.21	2.10.24		
Happy Mondows	6713	-	32.00	7626.74	7627.60	7827.80	78,27.96	0.031678	3.18	10.07	35.13	1.00
Happy Mandows	671.3	1-34	160.00	7826.74	7628 32	7828.32	78,78.67	0.028164	4.35	36.74	65.97	1.0
Happy Meadows	671.3	2.4	428.00	7826.74	7628.09	7828.87	7829.33	0.019359	5 30		90.62	0.96
Hoppy Mendows	871.3	5 yr	860.00	7826.74	7829.24	7829.18	7829.77	0.016602	5.87	113.02	95.72	0.94
Hoppy Mectows	871.3	10-pr	816.00	782674	7879.48	7879 39	7800.08	0.015398	0.24	138.04	P6.11	0.96
Happy Mexicows	871.3	50-yr	1367.00	1826.74	7830.09	78,29.90	second state and states	the second s	5.83	196.00	and the second se	2.8
Happy Mantows	671.3	100 yr	1610.00	7826.74	7830.33	7830.14	7831.15	0.017507	7.32	273.99		0.80
Happy Meastows	8/1.3	500-pr	2535.00	7828.74	7830.83	/830.81	7831.91	0.013865	8.39	254.74	131.71	0.98
- Min -		1.2	- 12 Quil								1 Sugar	
Happy Mandows	871	ete.	32.00	7824.85	7826.19	/825-83	7825.27	0.004997	2.28	54.14	18,28	0.48
Happy Mondows	671	1.94	160.00	7824.85	7827.27	7826.80	7827.36	0.005652	2.43	05.94	86.99	0.6
Happy Monitows	071	2 yr	426-00	7824.85	7827.78	7827.45	78,27.99	0.007817	3.61	118.04	109.58	0.61
Happy Mondows	071	SW.	660.00	7824.85	7828.02	7827.73	7828.35	0.009730	4.57	144.48	the second se	9.71
Happy Meedows	871	10 yr	848.00	7824.85	7826.18	7827.93	7828.60	0.011421	\$28	180.28	111.82	0.78
Happy Mondows	671	50.94	1351.00	7824.85	7828-41	7828.39	7829-21	0.017464	7.21	187.54	113.07	0.86
Happy Massions	871	100 yr	1610.00	1824.85	78/8.58	7828.58	1879.52	0.018028	1.19	206.84	114.05	
Happy Mantows	d71	500-9	2335.00	7824.85	7829-12	7829.12	7833.29	0.016000	8.69	268.45	118.12	1.00
		100				-						
Happy Meadows	670	ele:	32.00	7817.82	7818.49	7818.49	7818.61	0.052318	2.70	11.85	and the second se	0.9
Happy Meadows	670	1-18	180.00	7817.82	/818.92	7818.92	7819.18	0.029401	3.91	42.30	and the second sec	1,00
Hoppy Musclews	670	2.10	426.90	7817.82	7819.43	7819.33	7819.74	0.016526	4.53	94.12	109.50	43 0.86

Reach	River Sta	Peptie	Coards: Hoppy M Co Total	Mr Ch D	W.S. Eliny	OHWS	E.G. Dav	E.C. Slope	Vial Churk	Flow Area	Top Virue	Froute # Chi
			(ale)	010	(8)	(8)	(11)	(8.8)	(8h)	(14) (1)	(7)	
Huppy Mealbrea	870	5 yr	560.00	7817.82	7819.80	7819 80	78020.17	0.012290	4.88	135.18	112.04	0.7
Huppy Monouves	670	10 yr	846.00	7817.62	7820.08		78,20.48	0.010272	5.07	195.99	114.24	0.7
Happy Manzzain	670	50 97	1351.00	7817.83	7820.81		79(21:26)	0.000 ato	5.36	252.09	118.04	0.0
Happy Mancows	670	100 yr	1513.00	7817.82	7821.12		7821.60	0.0003328	5.59	200.33	119.48	0.0
	670	the second s					78/2 48		8.14			0.0
Happy Mondows	610	500-pr	2335.00	7617.82	7821.89		78.62.48	0.005290		383.41	126.34	0.0
Happy Meetines	869.6	min	32.00	7814.51	7815-84		7815.67	0.002713	1.35	23.78	44.02	0.3
Happy Mooduws	009.0	1.97	160.00	7614.51	7610.36		7816.47	0.004232	2.64	60.65	57.08	0.4
Hoppy Mondows	009.0	24	420.00	7814.51	7817.12		7817.38	0.004839	4.08	104.94	58.53	0.5
Happy Metrices	609.6	Syr	860.00	7814.51	7817.64		7615.01	0.005120	4.91	136.00	81.30	0.5
Happy Meatows	599 S	10-pr.	\$46.00	7814.51	7818.00		7818.48	0.005184	5.44	158.37	82.70	0.5
Hoppy Moscows	602.6	10 yr	1351 00	7814.51	7618.81		7619-48	0.005468	8.45	213.75	89.36	0.0
Happy Moscows	669.6	100 yr	1615.00	7814.51	7819.17		7819.92	0.005410	7.06	248.02	98.23	5.6
Happy Meadows	889.5	500-yr	2335.00	7814.51	7820.02	-	7820 94	0.006301	7.98	338.82	120.85	0.6
	10000	2.31			1.000					1.000		1. 1.1.1
Happy Mondows	009	ania:	32.00	7813.48	7814.42		7814.44	0.001908	0.97	33.00	77.18	0.2
Happy Meetows	663	Tije	160.00	7813.48	7815.20		7815.24	0.001361	1.45	110.29	108.62	0.2
Happy Meetows	003	24	425.00	7813.48	7818.32		7816.37	0.000880	1.77	241.02	127.51	0.2
Happy Mondows	609	Syr.	860.00	7813.48	7816.94		7817.01	0.000820	2.06	321.10	129.89	0.2
Hoppy Meannes	603	10-97	848.00	7813.48	7817.35		7817.43	0.000817	3.27	375.18	133.04	0.2
Hoppy Meadures	6992	50-yr	1351.00	/513.48	7818,25		/818.37	0.000845	2.78	497.45	143.97	0.25
Happy Meadows	659	100 yr	1810.00	/813.48	/818.63		7818.78	0.0008/1	2.99	552.48	148.45	0.2
Happy Mexicous	669	500-yr	2336.00	7813.48	7819.51		7819 70	0.000944	3.53	688.59	157.95	0.2
	1000	1000							10.103	- 8227		1.123
Happy Meathrest	055	anat A	32.00	7812.81	7813.67		7813.70	0.005839	1.57	21.04	57.40	0.4
Happy Mascows	0.00	1.97	160.00	7812.61	7814.95		7814.98	0.000696	1.35	123.03	103.57	0.2
Hoppy Meanines	068	2.4	426.00	7812.81	7818.54		P818.18	0.000731	1.60	205.15	143.87	0.20
Hisppy Meetows	668	ST	\$80.00	7812.81	7818.78		7515.83	0.000666	1.85	256.88	142.38	0.2
Hoppy Mondows	008	10 yr	\$46.00	7812.81	7917,19		7817.26	0.000658	2.04	418.32	144.91	0.2
Happy Meadows	668	50-yr	1351.00	7812.81	7818.08		7818.18	348000.0	7.50	545.65	148.98	0.23
Happy Mearines	668	100 γ	1810.00	7812.81	7818.48		7818.57	0.000721	2.71	602.90	151.07	9.73
Happy Montows	008	500 yr	2335.00	7812.81	781933		7819-49	0.000803	3.24	736.62	156.22	0.2
Happy Mantows	667	mm	32.00	7811.98	7813.54		7813.55	0.000436	0.71	45.32	55.53	3.14
Hoppy Montown	667	1.1	160.00	7811.98	7614.87		7014.89	0.000485	1.15	139-00	88.82	0.1
Hoppy Montows	007		429.00	7911.98	7816.05		7616.00	0.000555	1.66	298.12	108.27	0.1
		2 yr	the second s		and the second se		and the second	and the second se			and the second se	
Happy Mascines	667	59	8.60.00	7811.98	7810.68		7816 74	0.000671	7.04	328.27	114.47	0.7
Hoppy Mealtows	667	10-yr	546.00	7811.98	7817.08		7817.17	0.000672	2.30	3/5.69	119.29	0.2
Hoppy Monows	067	50 97	1351.00	7811.98	7017.95		7818.07	0.000803	291	482.63	129.07	0.2
Hoppy Monouws	067	100 yr	1912.00	7811.98	7018.31		7618.48	0.000865	3.19	529-90	133.46	0.2
Huppy Meadows	057	500-yr	2335.00	7811.98	7819.14		7819.36	0.001024	3.85	845.05	142.89	0.2
Happy Modernes	000	min'	32.00	7811.75	7913.30		7813.39	0.000398	0.63	50.51	68.73	0.10
Phippy Meadows	655	1.98	160.00	1811.75	7814.73		7814.75	0.000313	1.08	148.18	74.72	0.14
Happy Meastows	605	2.4	426.00	7811.75	7213.84		/815.90	the second design of the second	1.82	243.59	98.24	0.16
Happy Mondows	606		600.00	7811.75	7816.42		7816.51	0.000643	2.32	301.30	110.08	0.2
Happy Masterna	655	5 yr 10 yr	846.00	7811.75	7816.79		7818.90	0.000744	2.67	343.74	119.97	0.2
and some the Print product of the second s		and the state of t	1351.00	and the second se			and the second second second second	and the second se			second in the second second second	
Happy Meeduws	865	50 yr		/811./5	781/5/		1812,74	0.000990	3.48	448.91	157.78	0.2
Happy Meatows Happy Meatows	005	100 yr 500 yr	1810.00	7811.75	7817.90		7818.10	0.0010/0	3.78	502.95 638.40	187.27	0.2
Thisppy Meetcove	000	5.09	2000.00	1011.73	701000		1010.01	0.005244	. 4.65	0.0.40	1846.071	0.0
Happy Montows	595	aniari	32.00	7810.92	7813.32		/813.33	0.0002218	0.75	6.0	30.91	0.1
Happy Meadows	665	1.97	163.00	7810.97	7814.62		7814.85	0.000672	1.48	108.68	63.30	D. 15
Happy Mandows	005	2.4	426.00	7810.92	7815.67		7815.75	0.000804	2.33	205.53	118.45	0.2
Happy Mondows	885	byr	\$80.00	7810.92	7916.22		/816.33	0.001085	2.84	221.71	127.12	9.2
Hoppy Moodures	005	10 yr	\$46.00	7810.92	7910.57		7810.71	0.001201	3.18		144.25	
Hoppy Mexicous	165	50 yr	1351.00	7810.97	781731		7817.50		3.68	448.90	185.14	0.3
Hoppy Meantows	665	100 yr	1813.00	7810.97	7817.63		7817.54	0.001457	4.15		202.39	2.3
Hoppy Moodows	005	500 yr	2335.00	7810.92	7818.41		7818.00	0.001490	4.95	676.45	220.88	0.3
Happy Mascows	864	man	32.00	P811.58	7813.30		7813.22		1.09	29.35	33.05	0.2
Happy Monows	064	1.97	160.00	7011.56	7014.29		7014.30		2.17		56.94	0.3
Happy Moodows	004	24	426.00	7811.56	7815.24		7815.35		2,70		100.84	0.3
Happy Meetows	664	5 yr	860.00	7811.58	7815.75		7815.90		3.16	239.40	105.02	0.3
Happy Meadows	694	10-jr	845.00	/811.56	7816.04		7818.24	0.002437	3.93		108.66	0.4
Hippy Mondows	004	50 yr	1351.00	7811.58	7816-63		7816.94	0.003149	4.48	307.06	116.23	0.44
Hoppy Montows	064	100 yr	7612.00	7811.56	7810.89		7817.26	0.003325	4.80	337.09	122.20	3.4
Hoppy Meathres	694	303-#	2336.00	7811.56	and the second se		7818-01	0.003912	3.91	414.43	137.78	2.5
Chinese Aller	443	100004	20.00	1011.77	1010.01		10112.00	0.0000.00		20.00		
Happy Measures	063	1.0	32.00	7811.78	7813.06		7813.07	0.002243	1.33	28.42	59.81	0.2
Heppy Meadows	663	1-pt	160.00	F811.78			7814.23		:1.24	1,28.80	98.20	
Happy Meethwa	663	2.9	428.00	7811.78	7815.14		7815.19	0.000825	1.92	225.87	111.30	8.25
Happy Meacows	663	5 yr	560.00	7811.75	and the second		7815.77	0.300991	2.41	283.08	118.74	0.2
Happy Mencows	663	10-yr	846.00	7811.78	7815.92		7816.04	0.001151	2.77	316.78	118.41	0.29
Hoppy Meathwa	883	90-pr	1351.00	7811.78	7819.47		7819.58	0.001632	3.89	383.24	121.84	44 0.3

Reach	Rever Sta	Profile	Q Tatel	Mr Ch El	WSElev	ORW.5	F.G. Flay	F.G. Skope	Val Chri	Film Armi	Top Writh	Frouda # Chi
			(cta)	010	-(95)	090	(8)	(8/8)	(8h)	(80 8)	00	
toppy Meetines	883	100.10	1810.00	7811.78	7818-71		7818346	0.001886	4.11	611.98	126.96	
Inppy Mandows	663	500 yr	2335.00	7811.76	7817.25		7817.65	0.002446	5.15	480.79	147.78	0.
Reppy Milecows	3662	when .	32.00	7811.19	7812.91		7812.93	0.001025	1.09	30.22	38.53	0.
Inppy Mandows	1662	t-ye	160.00	7811.19	7814.14		7814.16	0.000640	1.21	132.82	38.44	
tippy Mendown	3662	2.97	426.00	7811.12	7815.08	C	7815.11	0.000796	1.89	233.43	133.65	0.
Inppy Kendowe	55.7	5 yr	860.00	7811.19	7815.54	-	7815.62	0.000942	2.34	305.97	184.55	0.
tappy Meadows	062	10-yr	\$46.00	7011.10	7815.82		7915.92	0.001071	2.99	353.29	174.38	. 0.
tappy Mastows	062	50-yr	1351.00	7911.19	7810.35	-	7918.52	0.001443	3.44	447.13	180.54	0.
kippy Meadows	662	100 yr	1615.00	7811.19	7816.57		7816 77	0.001604	3.78	455.06	183.16	0.
tappy Mentrum	667	500-yr	7336.00	7811.19	7817.11		7817.40	0.001990	4.63	587.94	189.40	
Inppy Mastows	861	unie:	32.00	7811.19	7812.82		7812.63	0.000875	0.85	38.72	\$3.57	0
Rappy Meastown	961	1-91	160.00	7811.19	7814.08		7814.10	0.000527	1.01	158.20	133.45	. 0
lappy Mandows	661	24	429.00	7011.19	7915.01	-	7915-03	0.000591	1.35	319.99	195-81	.0
Neppy Meedowe	3661	5 yr	000.00	7811.19	7815.50	6	7815.54	0.000600	1.61	417.54	291.37	0
Inppy Mexicous	1661	10-97	845.00	7011.19	7815.77		7815.82	0.300660	1.83	473.32	204.33	0
Inppy Mandman	661	50-yr.	1351.00	7811.19	7816.29		7816.58	0.000873	2.39	580.64	257.65	0
Inppy Mantows	661	100 yr	1810.00	7811.12	7816.57		7816.62	0.000970	2.64	626.93	209.06	
tappy Meedows	661	500-yr	2335.00	7811.19	7817.05		7817.21	0.001207	3.29	/38.69	212.44	
TRACK IN TRACE IN TRACK	1991.	Such	2309.00		1011110		1017-21			1 20.00	212.44	
tappy Meadows	550	min	32.00	7810.86	7812.75		7812.76	0.000533	0.74	43.04	57.19	0.
hoppy Mendows	660	tyr	160.00	7810.85	7814.02		7814.04	0.000086	1.11	144.74	125.57	0.
Inppy Mandows	660	2-11	475.00	7810.86	7814.94		7814.97	0.000783	1.35	315.91	225.79	0
	660		8/0 00	7810.86	7815.64		7815.47	0.000677	1.54	430.05	232.31	3
Enppy Mantows	660	57	546.00	/810.85	7815.44		7815.75	0.000/05	1.72	493.40	233.51	
toppy Mealibers		10-yr		and the second se	and the second se			and the second				
toppy Meadows	850	50-yr	1351.00	7810.86	7816.21		/818.29	0.000894	221	811.85	235.73	
Reppy Meadows	662	100 pr	1810.00	7810.85	7816.43		7818.52	0.000985	2.44	692.71	236.87	
Roppy Meedows	880	505 yr	2335.00	F810.86	7816.94		7817.08	0.001165	2.99	785.13	238.85	- 0
Anna Manadamat	137	min	22.00	-	Var. 1. 103		2412 22	0.000683	1.06	20.14	34.35	
tappy Mendows		and the second se	32.00	7811.13	7812.70		7812.72			30.15		
toppy Meedows	134	1-yr	160.00	7811.10			/813.96	0.002361	1.34	120.81	218.53	
tappy Meedows	135	24	428.00	7811.10	7814.90	-	7814.50	0.000906	1.28	364.49	235.84	0
feppy Meedows	137	byt	660.00	7811.10	7815.43		7815.43	8 000545	1.47	453.44	238.55	- 0.
toppy Maadows	137	10 yr	848.00	7811.10	7815.67		7815.71	0.000585	1.68	528.05	240.01	. 0
Карру Маадонго	137	50-yr	.1351.00	7811.10	7816.16		7510.23	0.000/7/1	2.16	647.49	344.27	
Roppy Misidows	137	100 pr	1613.00	7811.10	7216.37	· · · · · · · · · · · · · · · · · · ·	7816-46	8.000856	2.39	698.99	246.30	.0.
Hoppy Maintows	121	500 yr	2335.00	7811.10	7816.87		7817.00	0.001083	2.95	824.09	251.17	0.
	9.265	112		10000	1-222			1.1.1.1.1.5		101-00		
tuppy Meadows	136	et et	32.00	7210.86	2812.65		7812.66	0.000411	0.87	38.75	30.96	
Hoppy Misidows	1.30	1.11	160.00	7810.86	7813.76		7813.80	0.001414	1.55	108.52	94.42	. 0.
Roppy Mondows	136	12 yr	4,25.00	7810.86	7814.82		7814.86	0.000662	1.41	305.75	230.59	0.
Roppy Missows	136	510	660.00	7810.86	7815 33		7815.37	0.000713	1.58	425.05	240.65	. 0.
toppy Meetows	138	10-yr	848.00	7810.88	7815.80		7815.65	0.000/47	1.77	490.35	248.48	
Impany Mendorem	136	50-yr	1361.00	7810.86	7818.02	2	7818.15	0.000568	2.29	8138.90	256 82	0.
Inppy Mastows	138	100-9	1815.00	7910 88	2816.27		7816.52	0.001085	2.53	680 45	281.25	
Roppy Maadows	136	500 yr	2335.00	7810.86	7816 75		7816.89	0.001300	3.10	788.29	271 72	0
		19.80		10000		i make		1.1.1.1.1.1.1.1		1000		
Hoppy Moodows	135	wiki -	32,00	P#11.38	7812.34	7812.34	7812.55	0.029462	3.68	8.67	2123	
Inppy Manzows	135	tige	160.00	7811.58	7813.05	7813.05	7813.50	0.073310	5.38	79.72	34.15	
inppy Mantows	135	2.4	429-00	7811.38	7813.99	7813.90	7814.63	0.000090	8.53	65.21	50.41	1
Toppy Mandows	135	5 pt	880.00	/811.38	7814.84	7814.54	7815-17	0-200540	837	100.81	100.349	1
Hoppy Milecows	135	10 11	845.00	7811.38	7814.99	7814.99	7815.48	0.020044	5.53	154.58	191.25	0
toppy Meanows	135	50 yr	1351.00	7811.38	7815.35	7815.35	7815.82	0-020815	6.07	226.11	220.94	1
toppy Missowa	135	100 yr	1610.00	7611.35	7815.51	7815.51	7816.12	0.019837	6.31	259.94	229.47	
Inppy Mentiown	135	500-yr	2338.00	7811.38	7815.87	7815.87	7816.61	0.018339	6.96	343.48	244.21	1
and descent of the second s		- and the second	a de la capitar de	and a lot of the later.								
Inppy Mentows	134	mar.	32.00	7809-42	7829.73	10000	7839.81	0.020589	2.33	13.75	51.39	
Inppy Meadows	134	t-yr	160.00	7909.40	7810.12	7810.12	7810.39	0.026883	4.10	26.31	72.84	1
Rappy Masdows	134	24	420.00	7809.40	7810.62	7813-62	7811.05	0.022986	5.28	90.64	95.47	1.
Hoppy Mundows	134	6 yr.	660.00	7809.43	7911.04	7810.92	7811.49	0.014891	5.36	123.17	153.37	0
Enppy Mentown	134	10-97	846.00	7809-43	7811.48		7811.86	0.009321	4.99	169.51	111.34	
toppy Mandows	134	50 yr	1351.00	7839.43	7812.55		7812.87	0.004351	4.51	799.47	129.08	
	134	100 9		7809.40	7813.14		and the second sec	0.003112	4.26	317.80	137.84	0
heppy Mantown			1812.00	the second s			7813.47 7814.90		and the second se		the second s	
fappy Meadows	134	500-yr	2335.00	7809.43	7814.70		1814.30	9/001625	3.82	812.41	168-48	
tone Mentered	133	where the second	32.00	7907.85	7808.75	7808.73	7808.85	0.000000	2.50	12.79	65.83	
Rappy Misadows	130	where the second		the second s	7808.75	1208.73		0.025409			50.83	
Inppy Mentown	133	1-yr	160.00	7807.85			7839.53	0.010756	321	49.82	70.37	
tappy Mestows	133	2-11	425.00	7807.85	7810.35		7810-51	0.004/637	3.16	134.90	104.81	0
toppy Meadows	133	Sy.	\$60.00	7807.85	and the second se	-	7811.15	0.0002/1	3.18	209.12	127.04	
teppy Meadows	133	10-yr	\$46.00	7807.85	and the second sec	1	7811.80	0.002597	3.16	270.97	141.77	
Tappy Meadows	133	50-yr	1351.00	/80/.85	7812.57		7812.72	0.001463	3.19	440.33	161.81	
Roppy Misodows	135	100 yr	1810.00	7807.85	7813.16		7813.31	0.001143	3.16	540.56	181.67	
Inppy Minodows	133	500 yr	2335.00	7807.85	7814.73		7814.86	0.000665	3.03	875.51	239.63	
			and the second se									

Happy Maintown Happy Maintown	132 132 132 132 132 132 132 132 132 132	min 1-yr 2-yr 5-yr 10-yr 50-yr 100-yr 500-yr	(0%) 28.00 156.00 422.00 654.00 842.00 1347.00	(%) 7806.37 7806.37 7806.37	(#) 7807.28 7806.48	(70) 7806.98 7807.72	(ft) 7837.33	(8/8) 0.004151	(994) 1.79	(H1 #) 15:83	(f) 25.57	¢.
toppy Manctown toppy Manctown (toppy Manctown	132 132 132 132 132 132 132 132 132 132	1-yr 2-yr 5-yr 10-yr 50-yr 100 yr	156.00 422.00 654.00 842.00	7806.37 7806.37	7805.48			second				
http://doctows/ http://doctows	132 132 132 132 132 132 132 132 132 131 131	2 yr 5 yr 10 yr 50 yr 100 yr	422 00 654 00 842 00	7806.37	and the second	780772		A 200 A 200				
Inppy Matchives 1 Inppy Matchives 1	132 132 132 132 132 132 132 132 131.8	5 yr 10-yr 50 yr 100 yr	654.00 842.00			1.0000-11.001	7808.00	0.003272	2.64	55.36	40.50	0.
appy Matchows appy Matchows	132 132 132 132 132 131.8 131.8	10-ye 50-ye 100-ye	842.00	Martin and	7809.37	7808.62	7809.70	198400.0	4.87	93.39	46.22	0
appy Matchows ap	132 132 132 132 131.8 131 131	10-ye 50-ye 100-ye	842.00	7805.37	7809.95	7809.16	7810.44	0.005144	5.68	122.08	51.75	ଁ ହ
appy Maschees appy Maschees appy Maschees appy Maschees appy Maschees appy Maschees appy Maschees appy Maschees appy Maschees appy Maschees	132 132 131.8 131 131	50-yr 100 yr	1347.00	7806.37	7810.39	7809.58	7810-96	0.005157	6.24	145.28	54.75	0
appy Matchies appy Matchies appy Matchies appy Matchies appy Matchies appy Matchies appy Matchies appy Matchies appy Matchies	132 132 131.8 131 131	100 yr		7809.37	7811.58	7810.46	7812.27	0.004291	6.98	213.50	58.35	0
Inppy Manchows Inppy Manchows Inppy Manchows Inppy Manchows Inppy Manchows Inppy Manchows Inppy Manchows Inppy Manchows	132 131.8 131 131		1606.00	7806.37	7812.21	7810.85	7812.93	0.003768	7.13	250 62	58.78	. 0
toppy Manctown Toppy Manctown Toppy Manctown Toppy Manctown Toppy Manctown Toppy Manctown	131.6 131 131	1000 p	2331.00	7805.37	7813.76	7811.77	7814.58	0.003110	7.72	355.14	79.22	0
Inppy Ministows Inppy Ministows Inppy Ministows Inppy Ministows Inppy Ministows Inppy Ministows	131	2020 W										-
Reppy Mascown Reppy Mascown Reppy Mascown Reppy Mascown Reppy Mascown	131	-	Bedge									
Tappy Miscows T Tappy Miscows T Tappy Miscows T Tappy Miscows T		mie	28.00	7805.72	7807.21		7837.26	0.001335	1.27	22.05	22.70	0
appy Mascows 1 appy Mascows 1 appy Mascows 1 appy Mascows 1	1. The	t yr	156.00	7805.22	7808.39		7808.50	0.002663	2.57	60.62	38.05	0
appy Meadows	131	2.97	422.00	7805.22	7809.15	2	7839.49	0.005251	4.09	91.34	42.05	0
appy Meadows	131	5 yr	854.00	7805.22	7809.59		7810.16	0.007025	8.08	110.33	44.58	0
appy Meadows	131	10-yr	\$42.00	7805.22	7809.87	1	7810.64	0.008391	1.07	122.96	46.10	
and the second	131.	50-yr	1347.00	7805.22	7810.41	7810,21	7811.77	0.012240	9.51	148.30	48.71	0
	131	100 yr	1606.00	7805.22	7810.62	7810-62	7812.33	0.014261	10.65	158-88	49.79	0
and a second	131	500-yr	2331.00	7805.22	7811.75	7811.75	7813.71	0.011885	11.57	224.06	66.95	0
	130	erie:	28.00	7805.71	7836.66		7806.81	0.014728	3.17	8.84	18.08	0
and a feature of the local sector of the local	130	1-yr	158.00	7805.71	7807.39	7807.39	7807.89	0.224576	4.37	35.68	58.92	0
and the Countries of the Country of the	130	2-91	422.00	7805.71	7808.18		7808.52	0.011421	4.68	90.08	74.93	0
and which the state of the local division of the state of the	130	5 yr	654.00	7805.71	7808.70	8	7809.10	0.008636	5.04	129.73	77.93	
tappy Meadown	130	10-yr	842.00	7805.71	7809.08		7809.51	0.007421	5.29	159.32	80.43	0
appy Mandows	130	50-yt	1347.00	7805.71	7809.88		7810.44	0.006156	6.02	227.71	94.85	0
A CONTRACTOR AND A CONTRACTOR	130	100.yr	1606.00	7805.71	7810.21		7810.83	0.005906	6.35	261.28	104.35	
and a first state of a state of a first state of a stat	130	500-yr	2931.00	7805.71	7810.96		7811.72	0.005615	7.15	363.72	150.85	
appy Meedows	129	min	28.00	7803.60	7804.50	5	7804 53	0.003000	1.38	20.31	39.26	0
CONTRACTOR AND ADDRESS	129	t-yr	158.00	7803.60	7805.61	7	7805.88	0.002032	2.12	73.72	55.74	0
and the first of the second	129	2.11	422.00	7803.60	7805.83		7836.85	0.001888	277	152.12	71.78	0
and all discount of the second s	129		654.00	7803.60	7807.48		7837.65	0.001879	3.27	200.19	75.70	. 0
Children of the second s	129	5 yr		7803.60	and the second se		7808.13	0.001885	3.82		97.79	
C. C	129	10-94	842.00	7803.60	7807.92 7808.92	-	7839.17	0.001739	4.17	236.12 364.25	154.31	
and the second se		50-yr		and the second se	and the second sec	-		and the local distance of the local distance	4.37		and the second se	
and the second se	129	100 yr 500-yr	1606.00	7803.60 7803.60	7809.33 7810.14		7809.60 7810.47	0.001681	4.91	433 53 593 18	182.75	. 0
	222	10000						1.2.2.2.2.2.2		1.		1
C.C.C.L. Statute and the second	128	min	28.00	7802.29	7803.47		7803.49	0.001466	1.15	24.41	36.17	0
and the second se	128	t gr	156.00	7802.29	7804.48		7804.58	0.0023/70	2.35	66.42	47.98	. 0
and the second se	128	2.91	422.00	7802.29	7805.55		7835.74	0.003005	3.50	120.57	58.52	0
and the second state of the second states and	128	5 yr.	854.00	7802.29	7808.19	5	7806.45	0.002970	4.09	165.32	75.30	0
the first of the second s	128	tộ-yự	\$42.00	7902.29	7806.64	-	7606.94	0.002866	4.45	199.88	79.95	9
and a feel and an ended of the second s	1,28	50-yr	1347.00	7802.29	7807.85		7838.05	0.002740	5.23	293.28	\$22.27	0
teppy Meedows	1,28	100 yr	1606.00	7802.29	7808.08	1	7808.51	0.002968	5.51	354.57	169.58	0
toppy Meedows	128	500 yr	2331.00	7802.29	7808.96	5	7809.41	0.009461	5.93	\$19.13	199.50	0
appy Mantuwa	127	min	28:00	7800.11	7800.74	7800.74	7800.92	0.030088	3.36	8.32	23.75	
and the second se		Contraction of the local distance of the loc	a second s	7800 11	contraction of the later of the later of the	1 9 9 9 9 7 9	second second second second second	control on the second of the second second			39.04	0
and the second is the second second	127	1.97	158.00		7801.85	-	7832.05	0.007328	3.56	43.81		0
and the second		2.91	422.00	7803.11	7803.20		7803.46	0.004166	4.05	104.25	50.60	
	127	5 yr	654.00	7800.11	7803.92		7804.25	0.003873	4.63	141.29	52.69	0
and the second se	127	10-ye	842.00	7800.11	7804.41	-	7804.80	0.003786	5.03	167.57	55.32	. 0
and the first state of the stat	127	50-yr	1347.00	7803.11	7805-46		7806.01	0.000620	5.97	231.73	74.24	
and the second se	127	100 yr	1606.00	7800.11	7805.92		7806.52	0.003485	0.29	279.11	117.80	
lippy Meetown	127	500-yr	2531-00	7800.11	7607.13	-	7807.72	0.002715	6.49	444.51	154.65	0
and the set when the set of the s	120	min .	28.00	7798.43	7799.69	1	7799.71	0.000763	0.99	28.39	32.31	0
inppy Moscloven	126	5-yr.	156.00	7798.43	7801.10	1	7801.18	0.001048	1.95	79.80	40.88	. d
lappy Meadows	120	2-yr	422.00	7798.43	7802.23	· · · · · · · · · · · · · · · · · · ·	7802.39	0.001582	3.21	132.28	51.08	0
appy Meetows	126	5 yr	654.00	7798.43	7802.87	1	7803.12	0.002217	3.99	165.78	52.74	ą
and a state of the second s	128	10-ye	842.00	7798.43	7803.30		7803-62	0.002458	4.53	188.51	53.75	
and the second se	1.26	50-yt.	1347.00	7798.43	7804.25	S	7804.75	0.002888	5.72	241.65	.58.19	
	1,26	100 yr	1606.00	7798.43	7804.87		7805.26	0.003052	6.23	267.08	62.52	0
and the second shares of the second se	1,215	500 yr	2331.00	7798.43	780573		7806.54	0.003310	7.36	341.28	89.70	
area Manines	126		76.00	7798.22	7799.33		7799.38	0.002936	1.70	16.45	22.70	
	125	min	28.00	7798.22	7800.59	-				10.40	50.01	
and the second se	125	1.97	158.00			-	7800.71	0.003921	2.69		· · · · · · · · · · · · · · · · · · ·	
and the part of th	125	2.98	422.00	7798.22	7801.39	-	7801.65	0.005318	4.13	102.08	57.75	
	125	5 yr	854.00	7798.22	7801.85	2	7802.25	0.006109	5.05	129.44	59.97	0
or to the section of the same section	125	10-yr	842.00	7798.22	7802.12		7802.64	0.007092	5.79	145.42	61.31	0
of the second seco	125	50-yr	1347.00	7798.22	7802.67		7803.54	0.0090322	7.47	180.33	64.01	9
Inppy Meedows	1,25	100 yr	1606.00	7798.22	7802.91		7803.90	0.010315	8.23	195.45	65.82	0
Inppy Meedows	125	500 yr	2331.00	7798.22	7803.43	7803.32	7805.03	0.012771	10.17	231.08	70.09	. 0
Inppy Mandows	124	man	28.00	7795.98	7797.97		7797.98	0.001450	0.86	32.52	73.72	

and the second se				and the second se			the first state of the second state of the sec			and the second sec	
Happy Meadows	124	1.97	156.00	7796.98	7796.67		7798.71	0.002177	1.62	96.08	112.62
Happy Meadows	124	2.98	422.00	7796.98	7799.46		7799.53	0.001928	2.55	196.05	136.22
Happy Mendows	1.24	5 yr	654.00	7796.98	7799.98		7800.07	0.001805	2.39	274.08	156.19
Happy Mondows	124	1D-yr	842.00	7798.98	7800.33		7800.43	0.001671	2.58	328.12	159.60
Happy Meedows	124	50 yr	1347.00	7796.98	7801.14		7801.28	0.001443	2.95	461.79	157.83
Happy Meadows	124	100 yr	1606.00	7796.98	7801.52		7801.67	0.001366	3.10	525.72	171.38
Happy Matchwa	124	500 yr	2331.00	7796.98	7802.47		7802.65	0.001218	3.44	708.00	218.49
Coppy manageres	1.41	- P									
Happy Mastows	123	anie:	28.00	7794.86	7795.75	7796.75	7795.94	0.028898	3.56	7.87	19.97
and the second se	123		156.00	7794.88	7796.77	CONC.	7798.91	and the second	2.96	52.28	
Happy Meedows		1-j#	and the second	and the second				0.006307			56.12
Happy Methows	123	2.15	422.00	7794.86	7797.74		7797.97	0.005178	3.88	108.69	86.15
Happy Mandows	123	5 yr	854.00	7794.88	7796.31		7798.61	0.0047925	4.43	147.81	69.34
Happy Mondows	123	10-yr	842.00	7794.86	7798.69		7799.05	0.004616	4.83	175-01	75.10
Happy Meedows	123	50-yr	1347.00	7794.88	7799.54		7800.04	0.004312	5.68	243.98	84.75
Happy Meedows	125	100 yr	1806-00	7794.88	7799.92		7800.48	0.004209	8.03	276.96	88.05
Happy Meedows	123	500-yr	2331.00	7794.88	7800.82		7801.53	0.004137	0.91	358.71	95.06
Happy Montows	122	periet.	28.00	7792.56	7794.57		7794.58	0.001159	0.98	28.53	43.02
Happy Meadows	122	1.9#	158.00	7792.56	7795.39		7795.46	0.002521	2.09	74.48	61.55
Happy Mondows	122	2.95	422.00	1792.56	7796.20		7796.38	0.003412	3.34	126.47	63.96
Plappy Mandows	122	Syr	854.00	7792.58	1796.73		7796 99	0.003798	4.08	180.45	65.87
and the second se	122	10-yr	842.00	7792.56	7797.09		7797.42	0.003978	4.57	154.80	67.97
Happy Mandows				contract the back of the Contract of the second	and the second sec					and the second se	
Hoppy Moscows	122	50 yr	1347.00	7792.56	7797.90		7798.40	0.004353	5.66	243.09	78.08
Happy Meedows	122	100 yr	1606.00	7792.56	7798.26	-	7798.83	0.004496	6.11	272.48	88.56
Happy Meedown	122	500-yr	2331.00	7792.56	7799.08		7799.54	0.004788	2.15	354.04	108.97
Happy Maadows	121	anias .	28.00	7783.42	7794.26		7794.31	0.007937	1.79	15.62	42.09
Happy Meedown	121	1.96	156.00	7793.42	7795.00		7795.09	0.004477	2.34	65.75	78.07
Happy Meedows	121	2.98	422.00	7793.42	7795.81		7795.97	0.003830	3.23	130.74	83.14
Happy Mestows	121	5 yr	054.00	7793.42	7796.36		7796.57	0.003527	3.70	179.78	85.92
Happy Mondows	121	10-97	842.00	7793.42	7796.74		7796.99	0.003314	A 00	210.55	88.24
Happy Meedows	121	50 yr	1347.00	7793.42	7797.61		7797.95	0.003018	4.68	293.98	105.84
Happy Meadows	121	100 yr	1606.00	7793.42	7797.99		7798.37	0.002931	4.97	337.13	120.11
Happy Meedows	121	\$00 yr	2331.00	7793.42	7798.90		7799.36	0.002762	6.58	454.02	136.26
chippy annount	1.001	erre p	100.00	11114-16			11100	0.0001.000			10020
Happy Mascows	120	ania.	28.00	7791.27	7792.33		7792.35	0.001747	1.04	27.04	53.18
a free of the local data was a second of the local data	120		158.00	7791.27	7793.12		7793.18	0.002362	2.02	77.58	68.34
Happy Meadows		1.je									and the second se
Happy Mandows	120	2.9	422.00	7791.27	7794.07		7794.21	0.002294	2.95	143.38	71.32
Happy Mondows	120	5 yr	654.00	7791.77	7794.67		7794.86	0.002331	3.52	187.19	75.14
Happy Meadows	120	10-yr	842.00	7791.27	7795.08		7795.30	0.002430	3.94	217.71	81.95
Happy Miledows	1,20	50-yr	1347.00	7791.27	7795.90		7796.26	0.002861	4.85	292.80	98.04
Happy Mascows	120	100 yr	1806.00	7791.27	7799.24		7796.65	0.002792	5.26	327.08	105.41
Happy Meldows	120	500-yr	2331.00	1791.27	7796.99		7797.57	0.003190	0.27	412.79	121.84
Happy Meedows	119	min.	28.00	7790.37	7791.03		7791.07	0.005581	1.50	18.68	50.56
Happy Mendows	119	Sign:	156.00	7790.37	7791.85		7791.94	0.003353	2.42	64.38	\$7.47
Happy Mascows	119	2.10	422.00	7790.37	7792.93		7793.09	0.002758	3.19	132.61	68.92
Happy Meedows	519	5 yr	656.00	7790.37	7793.58		7793.79	0.002499	3.67	1.85.96	11926
Happy Meetows	119	10-yr	842.00	7790.37	¥794.04		7794.26	0.002224	3.86	244.18	129.02
Happy Masdows	119	50 yr	1347.00	7790.37	7795.08		7795.28	0.001703	4.08	416.49	210.69
Happy Meedows	119	100 yr	1606.00	1790.37	7795.48		7795.68	0.001560	4.10	504.90	226 33
Happy Mandows	119	500-yr	2331.00	7790.37	7796.31		3796.55	0.001438	4.48	711.40	258.14
		Pro p									
Lines- Manufacture	118		28.00	7758.90	7789.77		7789-81	0.002744	1.44	19.47	32.99
Happy Medicows	118	anie.		and the second			1790 97	and the second		and the second sec	47.75
Hoppy Meetows	The second second	1.98	158.00	7788.90	7790.85		and the second	0.002583	2.42	64.50	
Happy Mandows	118	2.91	422.00	7788.90	7791.91		7792.12	0.003345	3.62	115.61	53.03
Happy Mendows	118	5 yr	654.00	7788.90	7792.57	_	7792.86	0.003101	-6.33	157.58	58.20
Happy Mondows	178	10-yr	842.00	7788.10	7790.02		7793.38	0.003109	4.78	180.57	64.52
Ptoppy Mesitows	118	50-yr	1347.00	7788.90	7794.06		7794 52	0.002992	5.61	272.85	117.57
Happy Mendows	118	100 yr	1605.00	7788.90	7794.51		7794.98	0.002784	5.78	348.50	210.85
Happy Mandows	118	500-yr	2331.00	7788.90	7795.61		7795 99	0.001950	5.55	602.27	246.26
						-					
Happy Meetows	117.	anien :	28.00	7788.91	7788.14	7787.78	7788.20	0.004702	2.00	14.02	21.65
Happy Meedown	197	1 gr	158.00	7788.91	7789.25	7788.71	7789.38	0.004856	2.84	54.95	\$1.31
Happy Mendows	117	2.18	422.00	7788.91	7790.24	7789.46	7790.49	0.004225	3.98	106.13	52.86
Happy Mandows	117	syr.	654.00	7786.91	7790.87	7789.93	7791.21	0.004224	4.88	139.66	53.78
Happy Mindows	117	10-yr	842.00	7788.91	7791.30	7790.23	7791.72	0.004296	5.10	163-12	54.94
Happy Maintows	ttP		1347.00	7788.91	7792.26	7790.95	1792.86	0.004423	6.24	216.95	58.09
	197	50 yr	1606.00	7785.91	7792.66	7791.34	7793.36	0.004495	6.73	240.98	59.61

(ft) (ft) (ft) (etc)

(0) (00) (0)

(90 \$)

070

0.31 0.32 0.32 0 31 0.31 0.30 0.30 1.00 0.54 0.53 0.54 0.54 0.55 0.55 5.57 0.21 0.34 0.42 0.46 D.48 0.52 0.54 0.57 0.57 0.45 0.45 0.45 0.45 0.45 0.46 0.46 0.26 0.34 0.58 0.38 0.40 0.43 2,45 0.50 2.44 0.40 0.40 0.40 0.39 0.38 0.35 0.34 0.33 0.37 0.43 0.45 2.46 0.47 0.46 0.40 0.44 0.48 0.49 0.51 9.53 0.58 0.57

HEC-RAS Plan Plan 01 Rover South Platter Reach: Heppy Meacows (Continued)
Reach: Rover Sta Phote: Q Total Min Ch EJ W S: Elev Ont W S: E.G. Elev E.G. Stope Vel Chrid New Area Top Web: Provide # Chri

Happy Moldows

Happy Meedows

Happy Mondows

Happy Mandows

Happy Mandows 116

117

116 116 110 500 yr

1911 1911 2911

Syr

2331.00

28.00

158.00

422.00

654.00

7788.91

7785.59

7785.59

1785 59

7785.59

7793.64

7788.81

7787.75

7788.71

7789.26

7792.19

7786.33

7794.61

7788.54

7787.82

7788.89

7789.52

0.004725

0.002023

0.002489

0.002857

0.003164

7.91

1.21

2.21

3.36

4.12

301.30

23.98

70.44

125.72

1:50.13

63.53

39.07

56.05

59.88

85.53

47

0.61


0.28


0.36


0.41


0.44


Reach	- River Sits	Profile	C Total (ofs)	Mir Ch El 00	W.S.Elev (R)	Crit W.S. (R)	E.G. Ellev (ft)	E.G. Slope (NR)	Vel Chril (19%)	Flow Arms (sc) #0	Top With	Froude # Chi
Happy Meedows	118	50-yr	1347.00	7785.59	7790.45		7790.96	0.003796	5.77	241.81	72.21	0.52
Happy Meedows	116	100 yr	1606.00	7785.59	7790.79	f	7791.39	0.004005	6.27	267.07	74.56	0.54
Happy Mandows	116	500 yr	2331.00	1785.59	3791.60	7790.26	7792.44	0.004545	7.51	329.96	81.62	0.50
	1.0	10035					1000			1. 0.000		
Happy Meadures	115	aniati .	28.00	7754.06	7784.60	7754.63	7754.76	0.000547	3.13	8.93	23.67	0.99
Happy Metdows	115	tige	158.00	7784.06	7785.36	7785.25	7785.68	0.018096	4.53	34.47	42.97	0.89
Happy Meedows	115	2.98	422.00	7784.06	7788.15	7786.03	7788.59	0.015758	5.37	78.62	68.10	0.55
Happy Mendows	115	Syr.	654.00	7784.05	7788.58	7786.43	7787.13	0.014429	5.96	109.73	75.28	0.87
Hoppy Mondows	115	10-34	842.00	7784.06	7786.84	7786.68	7787.49	0.014138	6.50	1,29.58	78.38	0.88
Happy Meedows	115	50 yr	1347.00	7784.06	7787.48	7787.29	7788.34	0.013126	7.42	181.60	83.08	0.88
Heppy Meadows	115	100 yr	1606.00	7784.06	7787.76	7787.56	7788.72	0.012618	7.84	205.22	87.24	0.58
Happy Mandolen	115	500 yr	2331.00	7784.06	7788.45	7788.24	7789.05	0.011467	8.81	270.69	102.58	0.88
	100											-
Happy Meedows	114	min	28.00	7779.69	7783.97	7780.39	7750.99	0.001184	0.96	29.10	48.07	0.21
Happy Mandows	114	1 yr	156.00	7779 89	7781.77		7781.86	0.000423	2.02	77.40	76.02	0.35
Happy Meadows	116	2.95	422.00	7779 69	7782.65		7782.77	0.002730	2.78	151.54	88.59	0.34
Happy Meedows	114	5 yr	854.00	7779-69	7783.17		7783.34	0.002772	3.28	199.29	92.84	0.30
Happy Meadows	114	10-97	842.00	7779.69	7783.54		7783.75	0.002739	3.61	234.72	95.51	0.40
Happy Meadows	114	50-yr	1347.00	7779.69	7754.39		7754.00	0.002689	4.31	318.58	107.26	0.41
Happy Meedown	114	100 yr	1636.00	7779-69	7784.76		7785.08	0.002687	4.81	358.54	110.55	0.42
Happy Mendows	114	500-yr	2331.00	7779.69	7785.85		7788.08	0.002688	5.30	460.87	118.24	0.43
Happy Meedows	113	wie:	28.00	7778.93	7779.52	7779.52	7779.63	0.003853	2.72	10.29	66.14	0.99
Happy Meadown	113	tyr	156.00	7778.93	7780.40		7780.50	0.004379	251	62.15	64.64	0.45
Happy Mandowa	113	2 1	422.00	7778.93	7781.48		7781.62	0.002962	2.98	141.75	84.83	0.41
Happy Mandows	113		654.00	7778.93	7762.09	-	7782.27	0.002585	3.38	193.69	86.76	0.40
	113	Syr	842.00	7778.93	7782.50		7782.71	0.002458	3.68		91.00	0.40
Happy Meedows Happy Meedows	113	10-yr	1347.00	7778.93	7783.40		7783.68	0.002281	4.31	229.70	524.45	0.40
and the particular sector of the particular sector of	113	50-yr		7778.93	7783.80		7754.11	0.002201	4.54	3,09.90	128.72	0.40
Happy Meadows	113	100 yr	1606.00	1178.93	7784.75	-	7785.12	and the second se	5.07			
Happy Matchines	11.3	500 yr	233: 00	1118.93	1184.15	-	7180.12	0.002066	9.92	518.10	168.25	() 4)
Anna Anna	1.4%	min	28.00	7778.69	1178.78	TITTAT	7778.79	0.000261	0.62	45.26	49.25	0.11
Happy Meedows	112	and the second se	156.00	1176.69	7779.65	7778.37	1779.69	0.000975	1.64	45.20	80.75	
Happy Meanows	112	1.90	422.00	7778.69	778353	7778.37	7780.65					0.23
Happy Meetows	112	24	654.00		7781.07	7779.82		0.001709	280	155.67	64.87	0.32
Happy Meedows		5 yr	and the second se	7775.69	contraction of the second s	the second se	7781.28	0.002088	the second se	186 71		
Happy Mandows	112	10-ye	842.00	7776.69	7781-41	7779.89	7781.66	0.002371	4.03	211.06	78.37	0.40
Happy Meetines	112	50-yr	1347.00	7776.69	7782.16	7780.58	7782.58	0.002875	5.13	273.52	88.04	0.46
Happy Mexicoves	112	100 yr	1606.00	7776.69	7782.50	7780.92	7782.97	0.003048	5.58	303.91	93.17	0.48
Happy Mandown	112	500 yr	2331.00	7778.09	7783.30	7781.73	7783.95	0.003400	6.62	384.57	108.82	9.52
Happy Meadows	111	wer :	28.00	7777.96	7778.60	7778.42	7778.63	0.004784	1.33	20.99	60.48	0.40
Happy Meedows	111	1.97	158.00	7777.95	7779.22	-	7779.31	0.004483	2.30	67.74	81.87	0.45
Happy Meetows	111	2.11	422.00	1117.95	7779.95		7780.11	0.004242	3.25	129.86	89.56	0.48
Happy Meedows	111	5 yr	854.00	7777.95	7793.44	-	7750.66	0.004105	3.74	175.08	95.90	0.49
Happy Meedows	111	10-y#	842.00	7777.96	7780.76		7781.02	0.004005	4.10	200.01	100.20	0.49
Happy Meedows	133	50-yr	1347.00	7777.96	7781.50	5	7781.86	0.003751	4.84	283.86	109.19	9.50
Happy Mantuwa	111	100 yr	1636.30	7777.95	7781.85	3	7782.25	0.003634	5.13	322.62	118.03	0.50
Happy Meedows	111	500-yr	23/31 00	7777.95	7782.71		7783.20	0.003328	5.75	439.07	157.50	0.50
Happy Meedown	110	mm.	28.00	7774.34	7775.82	7775.80	7775.87	0.008014	1.82	15.42	39.18	0.51
Happy Meedows	110	5-yr	158-00	7774.34	7776.47	7776.20	7778.62	0.008009	3.10	50.36	58.10	0.50
Happy Meadows	110	2 yr	422.00	7774.34	7777.20	7776.78	7777.51	0.007992	4.49	P4.03	62.39	0.64
Happy Meedows	110	5 yr	654.00	77714.34	7777.68	7777.21	7778.10	0.008014	5.19	126.26	67.92	0.67
Happy Mantows	110	10-ye	542.00	7774.34	7777.99	7777.49	7778.50	0.006004	5.73	147.67	70,72	0.68
Hippy Meetows	110	50-yr	1347.00	7774.34	7778.69	7778.12	7779.42	0.007999	6.90	198.25	73.16	0.72
Happy Meadows	110	100 yr	1606.00	7774.34	7779.00	7778.43	7779.84	0.008011	7.40	221.38	74.28	0.73
Happy Mandows	110	500 yr	2331.00	7774.34	3779.79	2779.14	7780.90	0.008002	8.55	281.08	78.38	0.75

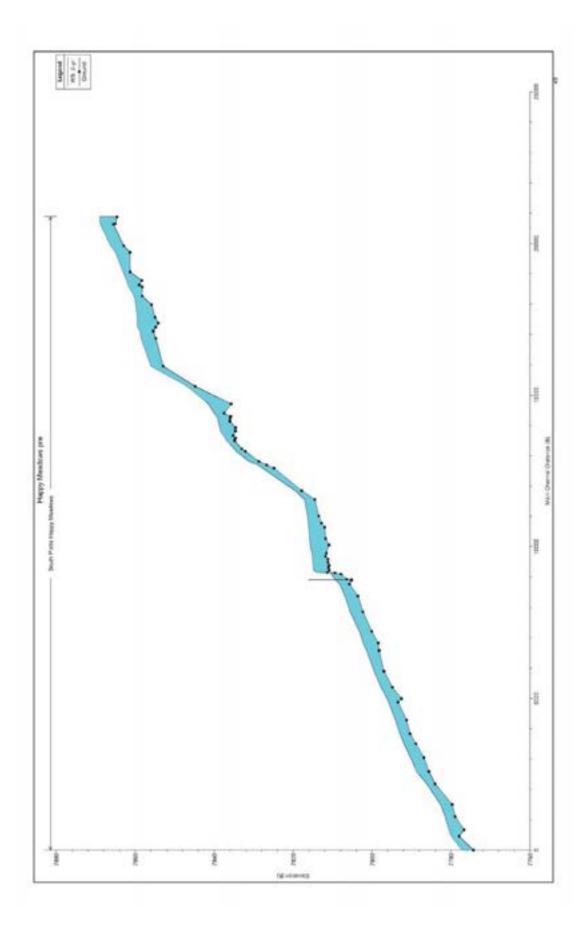


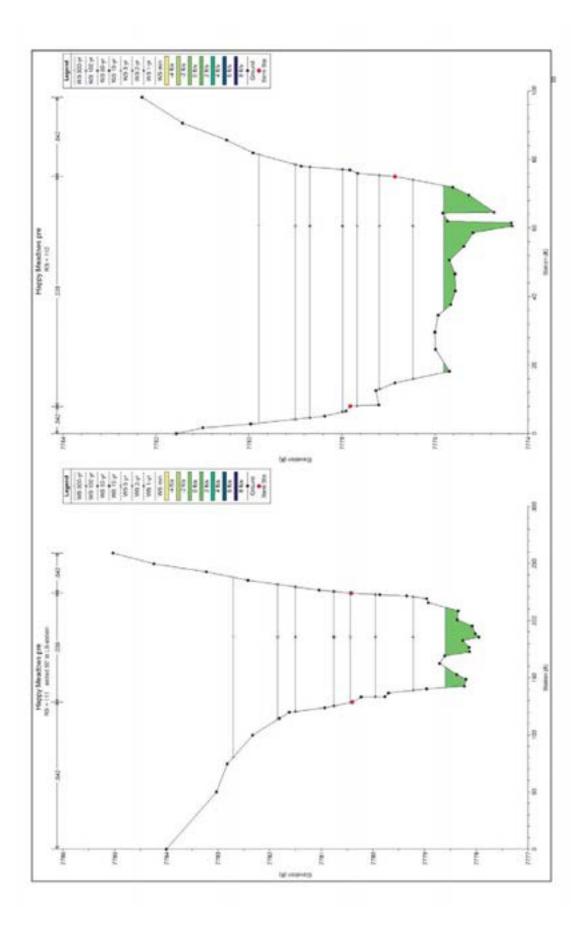


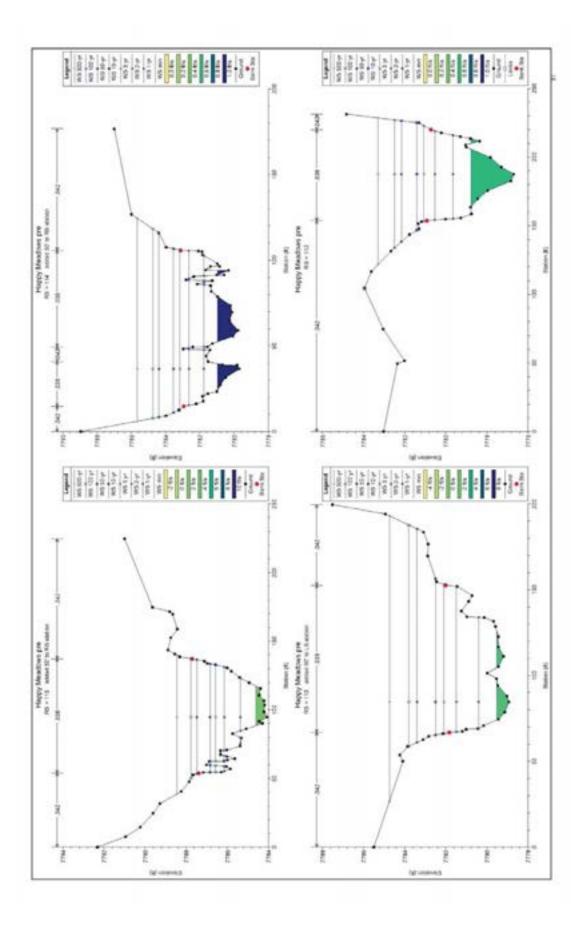


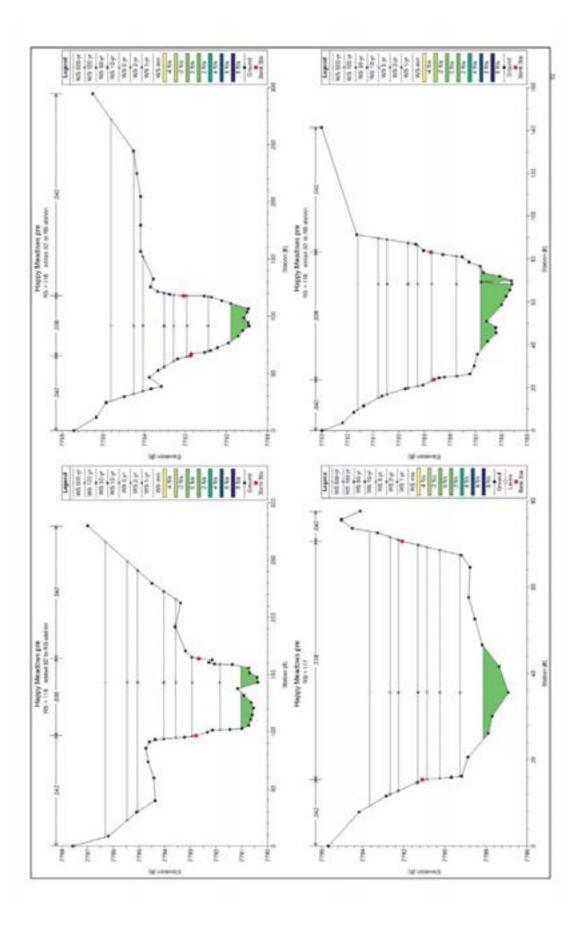


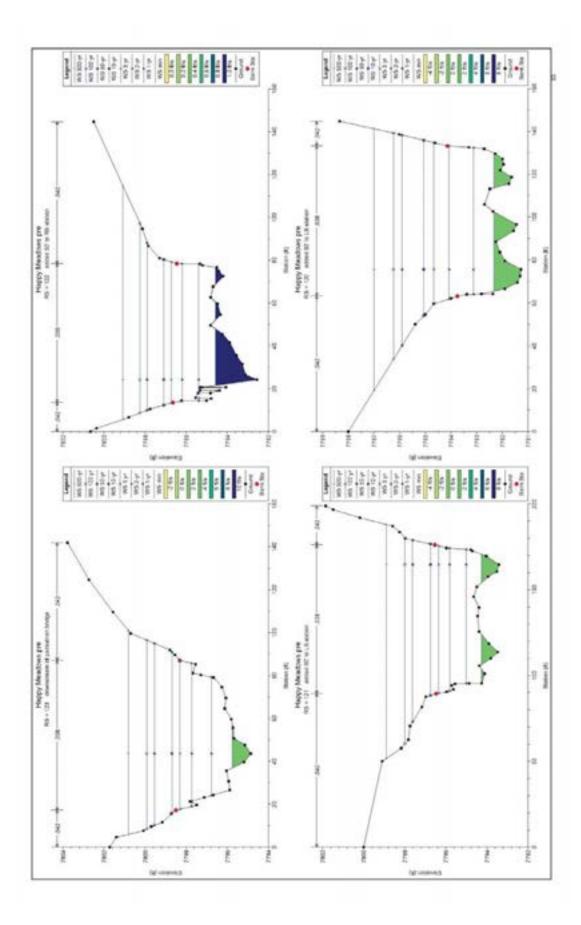


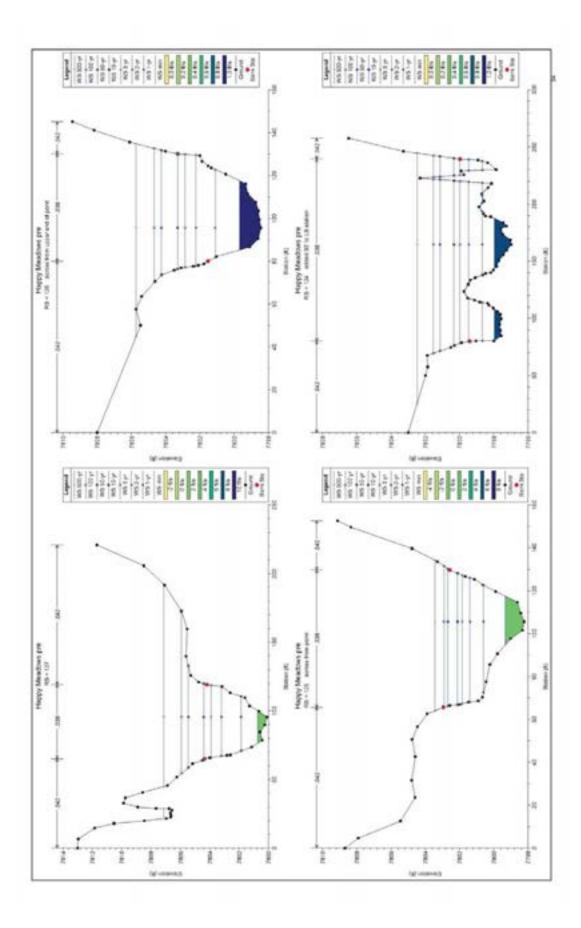


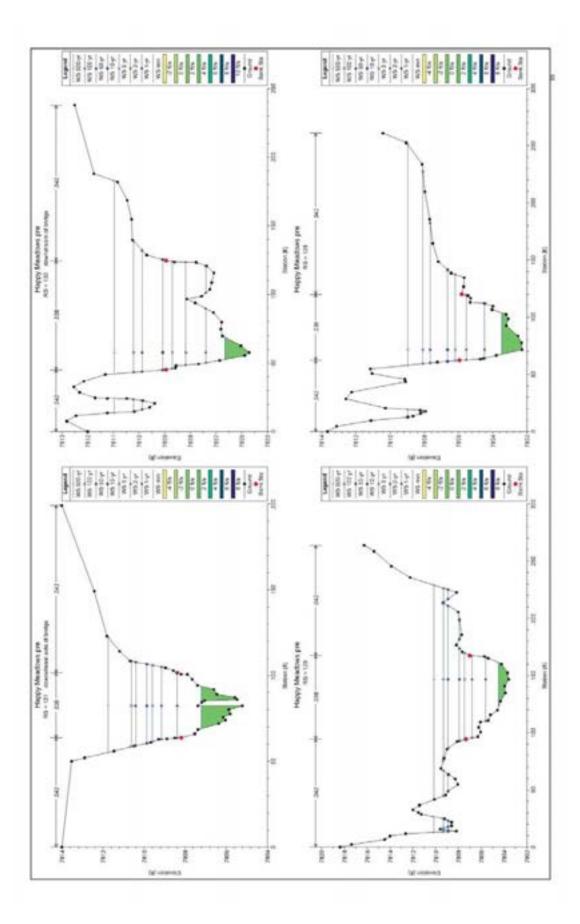


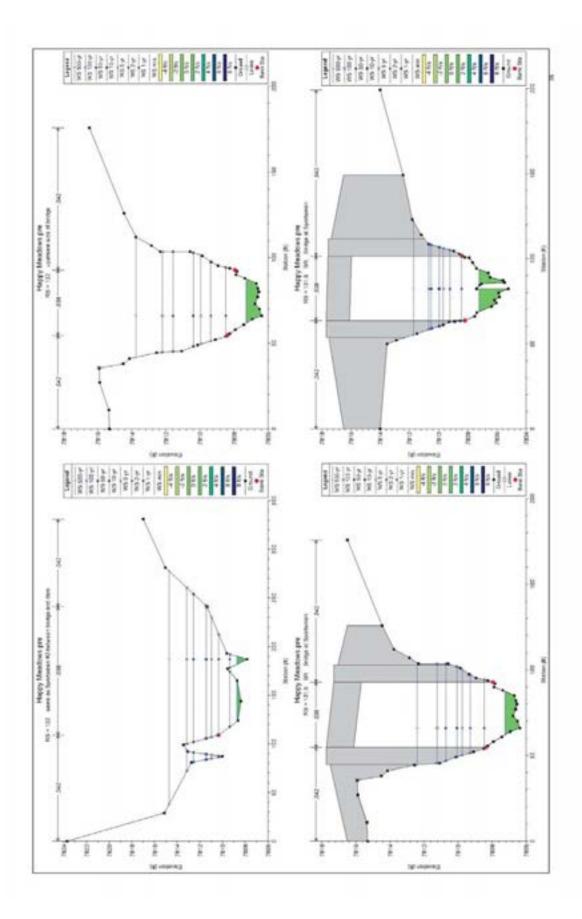


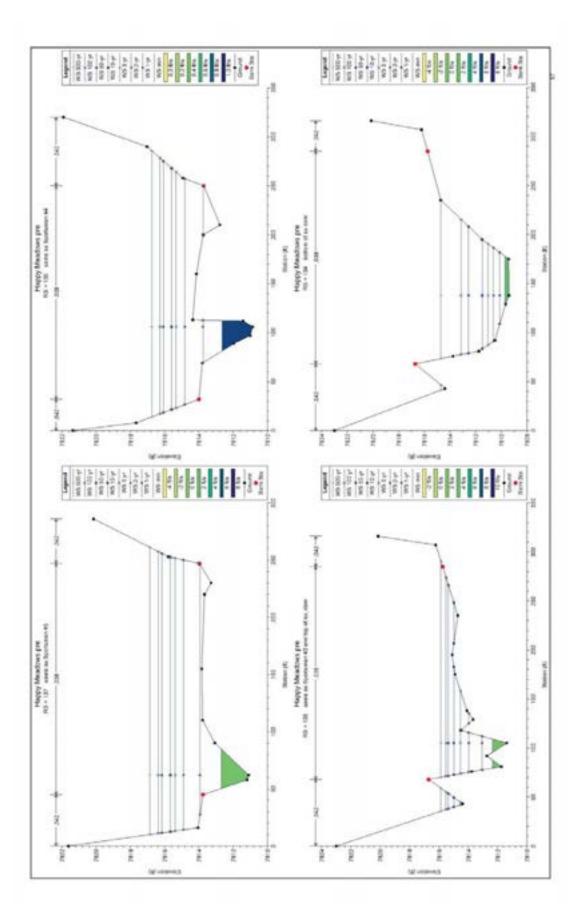


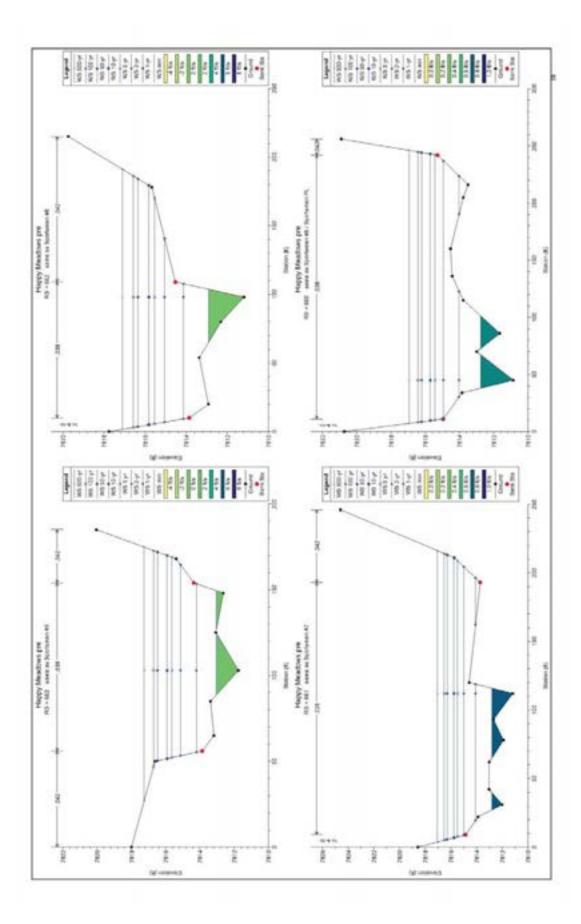


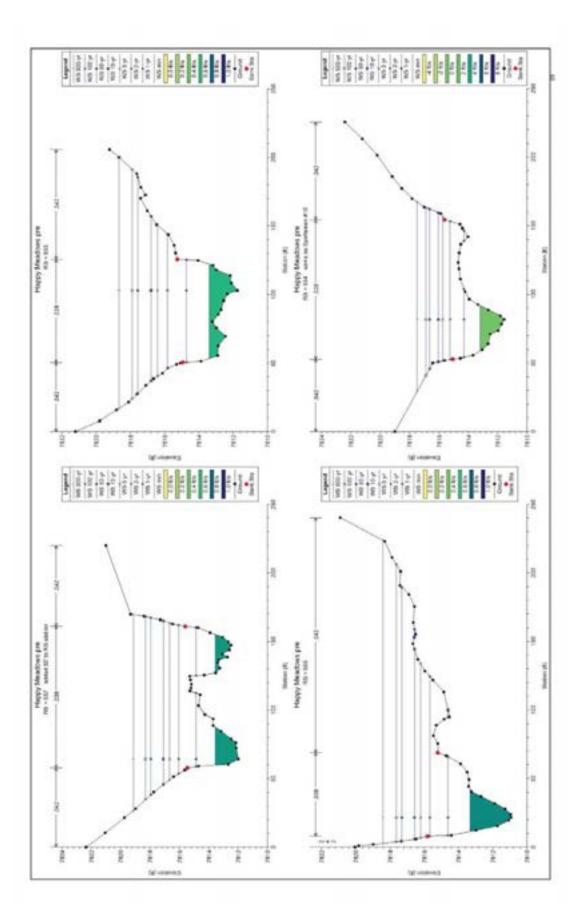


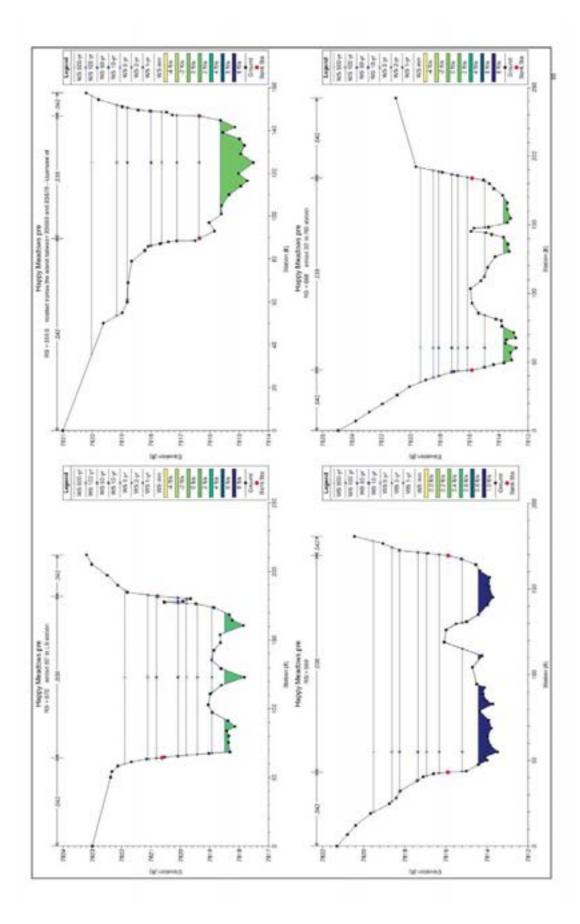


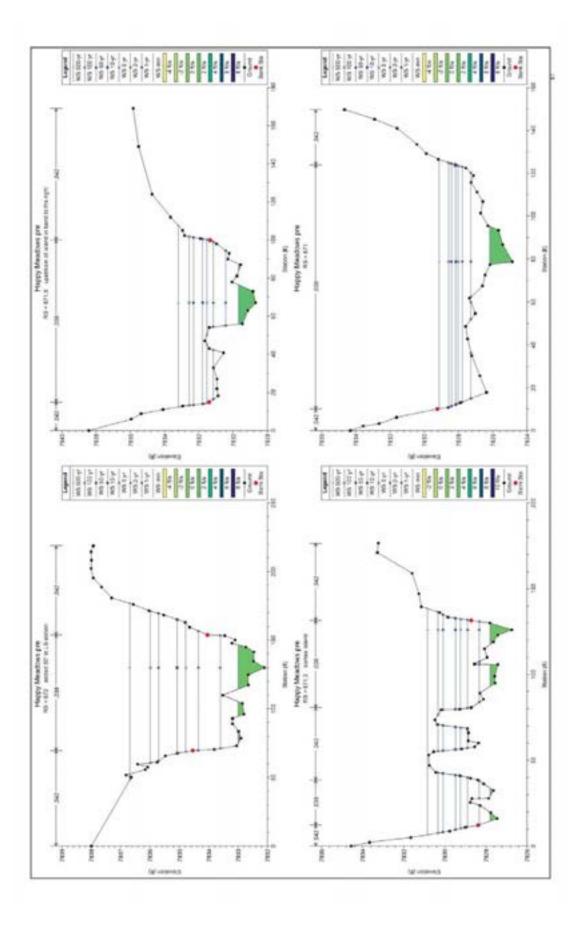


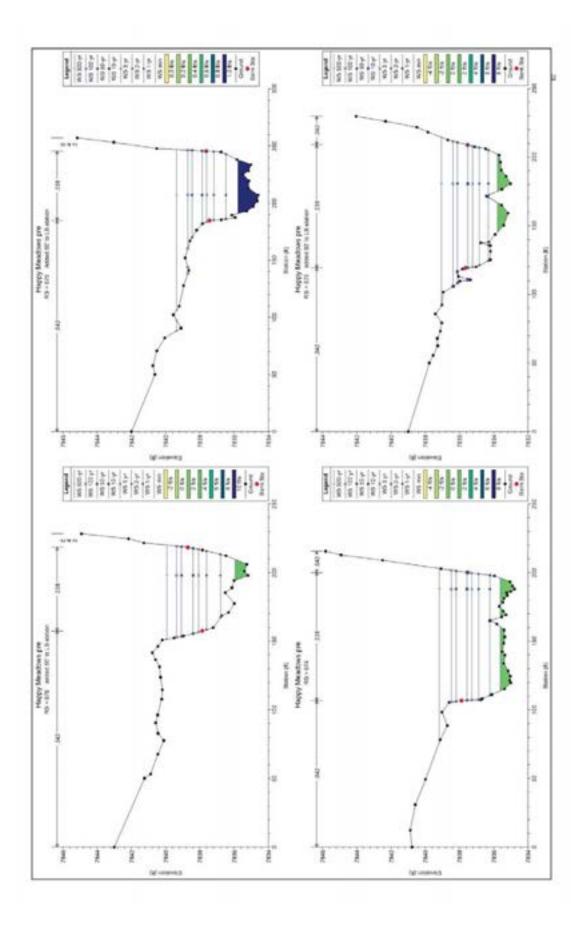


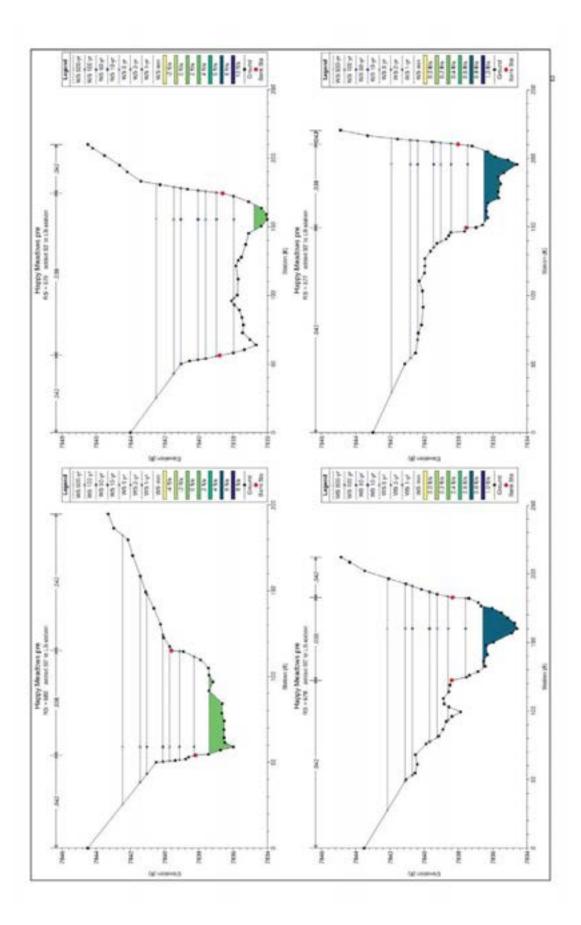


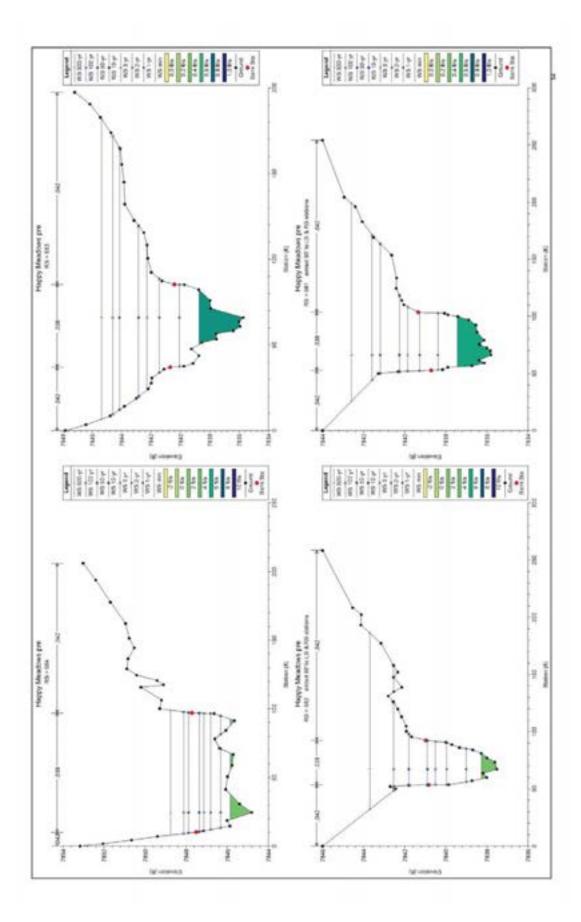

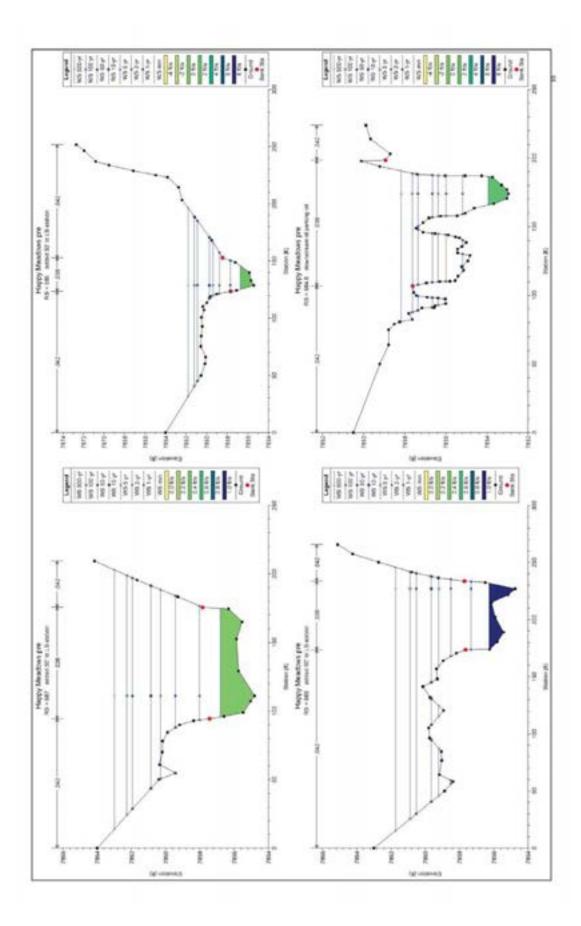

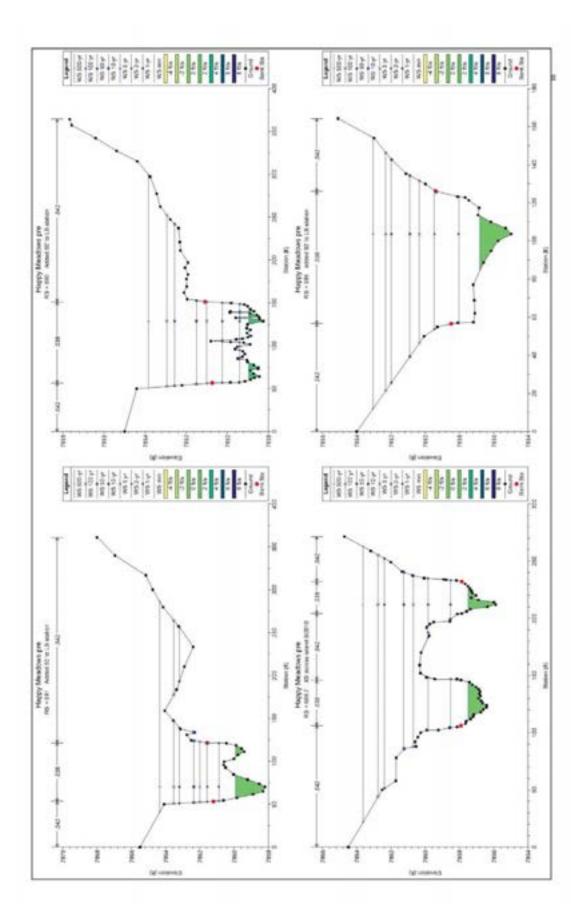

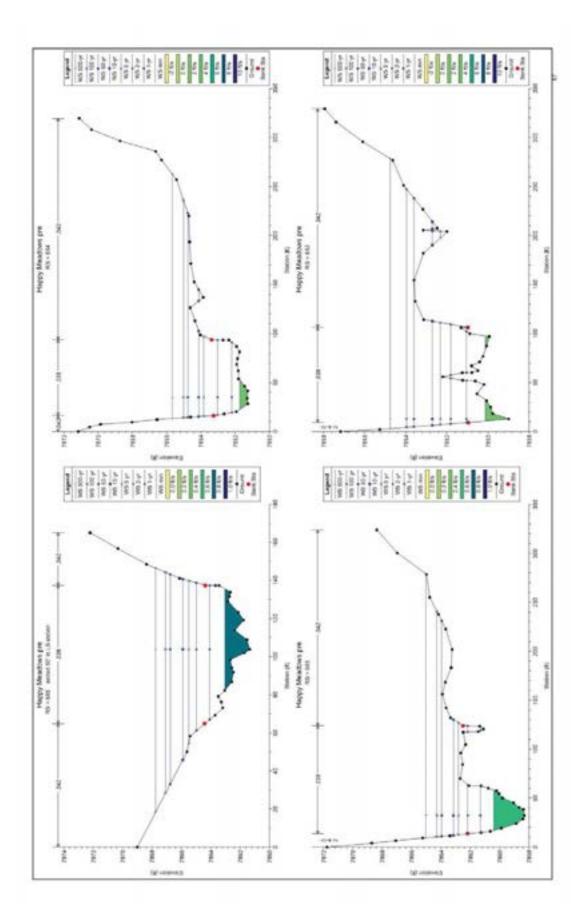

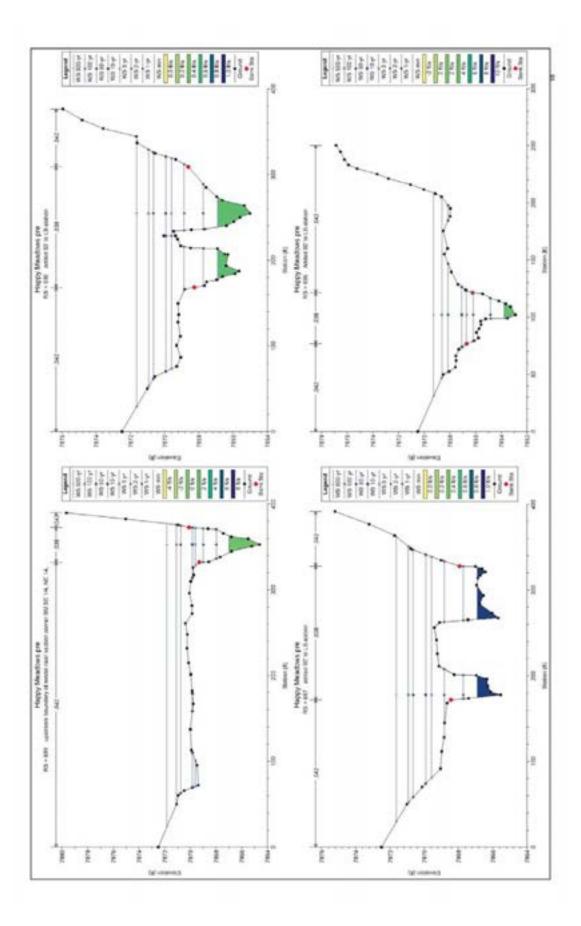

Aggrading

The deposition of material by a stream.

Related Glossary Terms

Drag related terms here

Index

Find Term

Chapter 1 - Background

Benthic

The flora and fauna found on the edges, bottom, or in the bottom sedim sea, lake, or other body of water. Includes many insects that trout depen part of their food supply.

Related Glossary Terms

Drag related terms here

Index

Find Term

Chapter 1 - Background

Benthic Zone

The area where benthic organisms reside. It is the lowest level of a body It is inhabited mostly by organisms that tolerate cool temperatures and gen levels.

Related Glossary Terms

Drag related terms here

Cascade

A meso-habitat type. Cascades are the steepest riffle habitat types, in te dient, in streams. These riffles consist of alternating small waterfalls an pools. These habitats may appear to have the characteristics of a Step-p tem. Cascades are characterized by swift current flows and often have e rocks and boulders above the water surface, which creates considerable lence and surface agitation. The substrate normally found in cascades is or accumulations of boulders.

Related Glossary Terms

Drag related terms here

Cover

Locations where fish prefer to rest, hide and feed are called cover. Cove visually isolate fish, which increases the number of territories in the sar Additionally, cover can create areas of reduced velocities providing criti and feeding stations for fish. The amount of cover available in a stream ence the production of a number of fish and invertebrate species.

Related Glossary Terms

Drag related terms here

Cross Vane

A structure spanning the entire width of the channel, constructed of lar ders and/or large wood, that provides vertical stability, increased scour stage upstream, and reduced stream power. This structure type is comm as a diversion structure for irrigation ditches, as well as for treating acti cutting and head cuts in the stream channel

Related Glossary Terms

Drag related terms here

Embeddedness

The degree to which the interstitial spaces between larger substrate par filled with finer sediments. Embeddedness tends to armor the substrate iting available habitat for benthic dwelling macroinvertebrates and spav tat for salmonids.

Related Glossary Terms

Drag related terms here

Glide

A meso-habitat type. Glides are those portions of streams which have rewide uniform bottoms, low to moderate velocity flows, lack pronounced lence, and have substrates usually consisting of either cobble, gravel or Glides are usually described as stream habitat with characteristics inter between those of pools and riffles. These habitats are commonly found sition between a pool and the head of a riffle, however they are occasion in low gradient stream reaches with stable banks and no major flow obs

Related Glossary Terms

Drag related terms here

Head Cut

An area of active down-cutting in the channel where a river or stream is down to a new, lower flood plain.

Related Glossary Terms

Drag related terms here

Intermittent

An intermittent stream is one that only flows for part of the year.

Related Glossary Terms

Drag related terms here

Index

Find Term

Lotic

Of, relating to, or living in moving water such as streams and rivers.

Related Glossary Terms

Drag related terms here

Index Find

Find Term

Meso Habitat

A channel scale habitat form. Typically a pool, riffle, rapid, cascade or g tat. A meso-habitat occupies the entire width of the stream channel, and exceptions (most notably plunge pools in high gradient step-pool syster least as long as the channel is wide.

Related Glossary Terms

Drag related terms here

Micro Habitat

Micro habitats are small, site specific habitats within a meso-habitat for may include spawning redds, in-stream or overhead cover, and velocity

Related Glossary Terms

Drag related terms here

Micro Vortex

A small rock cluster structure that replicates pocket water habitat in rifl and cascades.

Related Glossary Terms

Drag related terms here

Over-wintering Habitat

Areas of a stream or water body exhibiting depths that may sustain a pot through the winter months.

Related Glossary Terms

Drag related terms here

Perennial

A perennial stream is one that flows year round.

Related Glossary Terms

Drag related terms here

Pocket Water

A micro-habitat type. Pocket water habitats are typically found in higher riffles, rapids, and cascades with large cobble, boulder, and large woody These pocket water habitats provide small areas for velocity shelter and within these fast-water habitat forms.

Related Glossary Terms

Drag related terms here

Pool

A meso-habitat type. Pools are channel segments exhibiting areas of sco deposition where the water is deeper and slower moving.

Related Glossary Terms

Drag related terms here

Primary Producer

Primary producers are those organisms in an ecosystem that produce b from inorganic compounds. In almost all cases these are photosynthetic organisms.

Related Glossary Terms

Drag related terms here

Rapid

A meso-habitat type. Rapids are riffles associated with high gradients (get than 4%) with swiftly flowing (greater than 1.5 ft/sec), moderately deep highly turbulent waters. These riffles are generally associated with boul strates, which protrude through the surface of the water.

Related Glossary Terms

Drag related terms here

Redds

The egg sacks fish have laid that stay on the bottom of the river until yo year hatch, or the hollow in the bottom of the river that a trout makes in lay its eggs.

Related Glossary Terms

Drag related terms here

Residual Pool Depth (RPD)

Residual pool depth is estimated as the depth of water which would be in a pool under highly reduced flows or the stoppage of flows in the stream area of pools would be utilized by fish in low flow conditions. Residual p would also provide habitat for overwintering of fish when ice buildup removement in riffles or glides between pools. Residual pool depth is calc locating and measuring the greatest depth of the pool at the riffle crest of point of the downstream boundary cross-section of the pool), and subtrivalue from the greatest measured depth of the pool habitat. The different these measurements is described as the RPD. RPD may be difficult to do in some habitats, particularly dam pools with woody debris structural a tions. In many of these habitat units, the RPD may actually be a very low zero due to water flowing through these debris dams.

Related Glossary Terms

Drag related terms here

Riffle

A meso-habitat type. Riffles are those areas of the stream in which turb the water column is the major identifying characteristic, as a result of rehigh gradients. These units contain moderately deep to shallow, swift fl ter, and are characterized by boulder or cobble substrates. Riffles are vetant for macroinvertebrate production, due to the availability of light ar and the corresponding vegetative growth on the bottom substrate. The riffles, including low sediment deposition and resulting embeddedness direct impact on fish populations. The cleaner and healthier the vegetat and benthic macroinvertebrate community, the more food there is for t population.

Related Glossary Terms

Drag related terms here

Salmonids

Salmonidae is a family of ray-finned fish, the only family of order Salmo It includes the well-known salmons and trouts; the Atlantic salmons an genus Salmo give the family and order their names.

Subfamily - Salmoninae Brachymystax - lenoks Oncorhynchus - Pacific salmon and trout Salmo - Atlantic salmon and trout Salvelinus - Char and trout (Brook trout, Lake trout)

Related Glossary Terms

Drag related terms here

Substrate

Stream substrate (sediment) is the material that rests at the bottom of a

Related Glossary Terms

Drag related terms here

Thermal Refugia

Micro habitats found in streams and lakes that provide thermal protect cold water species such as trout. These may include shaded areas, cool springs, and deep water habitats.

Related Glossary Terms

Drag related terms here

Toe Slope

The foot, or bottom, of the sloping bank of a stream. This is the area of the sloping bank of a stream. sheer stress and erosion potential on a stream bank, and is typically the failure leading to mass wasting and collapse.

Related Glossary Terms

Drag related terms here

Index

Find Term